


INLET DEPTH _____ MAXIMUM BOTTOM DEPTH _____ SQ. FT./BEDROOM _____

COORDINATE LIST		
POINT	NORTH	EAST
148	579555.05469	1318850.46117
149	579561.60831	1318824.39335
150	579572.15538	1318618.95225
151	579586.70522	1318608.19027
152	579581.71048	1318767.55998
153	579581.71048	1318767.55998
154	579581.71048	1318767.55998
155	579581.71048	1318767.55998
156	579581.71048	1318767.55998
157	579581.71048	1318767.55998
158	579581.71048	1318767.55998
159	579581.71048	1318767.55998
160	579581.71048	1318767.55998
161	579581.71048	1318767.55998
162	579581.71048	1318767.55998
163	579581.71048	1318767.55998

CURVE DATA			
CURVE	ARC	RADIUS	TANGENT
C1	41.32'	180.00'	20.35'
C2	41.32'	180.00'	20.35'
C3	41.32'	180.00'	20.35'
C4	41.32'	180.00'	20.35'
C5	41.32'	180.00'	20.35'
C6	41.32'	180.00'	20.35'
C7	41.32'	180.00'	20.35'
C8	41.32'	180.00'	20.35'
C9	41.32'	180.00'	20.35'
C10	41.32'	180.00'	20.35'
C11	41.32'	180.00'	20.35'
C12	41.32'	180.00'	20.35'
C13	41.32'	180.00'	20.35'
C14	41.32'	180.00'	20.35'
C15	41.32'	180.00'	20.35'
C16	41.32'	180.00'	20.35'
C17	41.32'	180.00'	20.35'
C18	41.32'	180.00'	20.35'
C19	41.32'	180.00'	20.35'
C20	41.32'	180.00'	20.35'

CURVE DATA		
CURVE	ARC	RADIUS
C1	41.32'	180.00'
C2	41.32'	180.00'
C3	41.32'	180.00'
C4	41.32'	180.00'
C5	41.32'	180.00'
C6	41.32'	180.00'
C7	41.32'	180.00'
C8	41.32'	180.00'
C9	41.32'	180.00'
C10	41.32'	180.00'
C11	41.32'	180.00'
C12	41.32'	180.00'
C13	41.32'	180.00'
C14	41.32'	180.00'
C15	41.32'	180.00'
C16	41.32'	180.00'
C17	41.32'	180.00'
C18	41.32'	180.00'
C19	41.32'	180.00'
C20	41.32'	180.00'

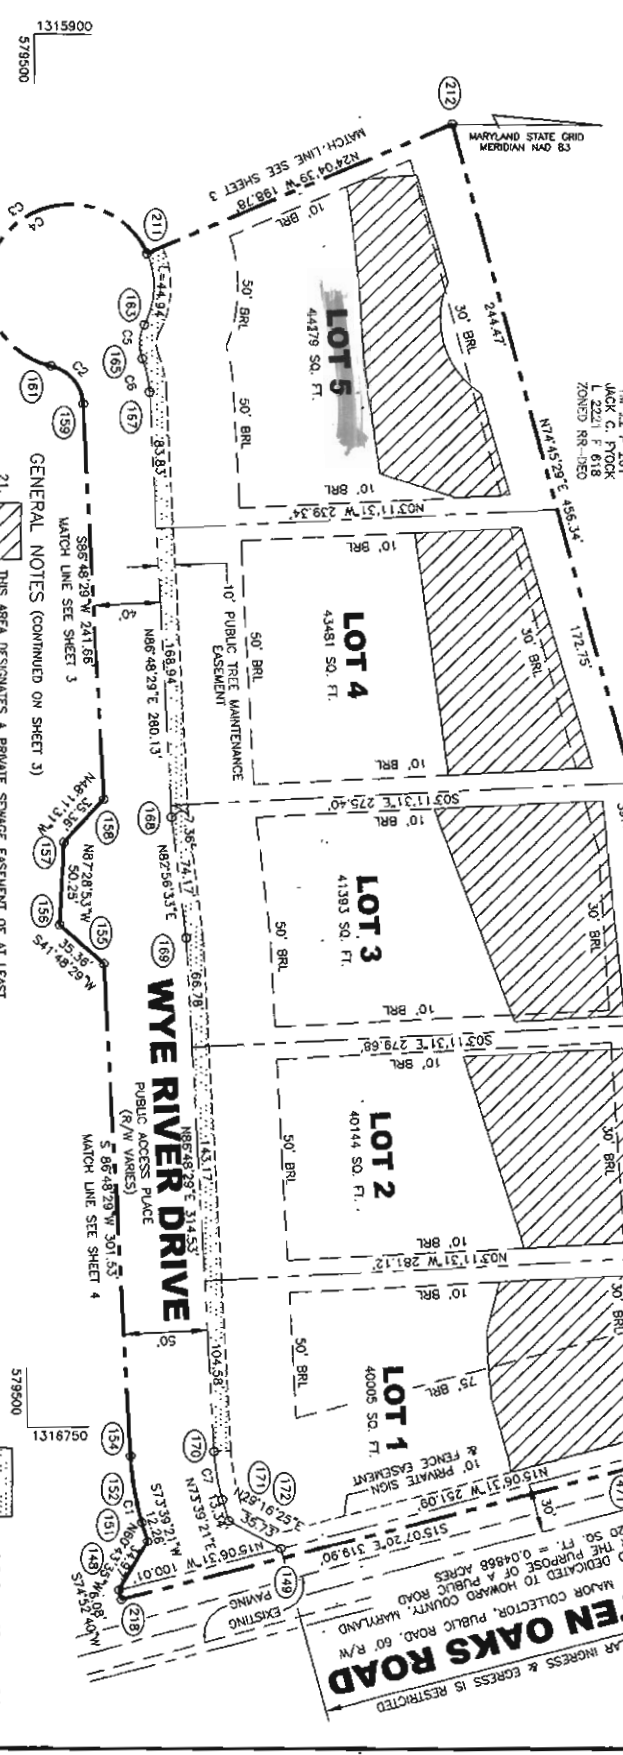

ROBERT H. VOGEL ENGINEERING, INC.
8401 MAIN STREET
BUDGET CITY, MARYLAND 21043
410-461-7666

SHEET TABULATIONS
TOTAL NUMBER OF LOTS AND/OR PARCELS TO BE RECORDED: 5
TOTAL AREA OF LOTS AND/OR PARCELS: 1.89498 AC.
TOTAL AREA OF ROADWAYS TO BE RECORDED INCLUDING WIDENING STRIPS: 1.08958 AC.
TOTAL AREA OF SUBDIVISION TO BE RECORDED: 5.97456 AC.

APPROVED FOR PRIVATE WATER AND PRIVATE SEWERAGE SYSTEMS
HAROLD COUNTY HEALTH DEPARTMENT

APPROVED FOR PRIVATE WATER AND PRIVATE SEWERAGE SYSTEMS
HAROLD COUNTY HEALTH DEPARTMENT


APPROVED FOR PRIVATE WATER AND PRIVATE SEWERAGE SYSTEMS
HAROLD COUNTY HEALTH DEPARTMENT

OWNERS CERTIFICATE
WE, THE UNDERSIGNED, CASTLEBERRY AT TEN OAKS, LLC, TRUSTEES OF THE HAROLD COUNTY HEALTH DEPARTMENT, DO HEREBY CERTIFY THAT THE PLAT, PLAT NO. 19097, IS A TRUE AND CORRECT REPRESENTATION OF THE LANDS AND INTERESTS THEREIN, AND THAT THE SAME HAVE BEEN EXAMINED AND FOUND TO BE TRUE AND CORRECT.

SURVEYOR'S CERTIFICATE
I, THE UNDERSIGNED, DO HEREBY CERTIFY THAT I AM A LICENSED SURVEYOR IN THE STATE OF MARYLAND, AND THAT I HAVE PERSONALLY EXAMINED THE PLAT, PLAT NO. 19097, AND THAT I HAVE FOUND IT TO BE TRUE AND CORRECT.

RECORDED AT PLAT NO. 19097
BOOK 19097, PAGE 1

Copy Perc Out Revision
signed 12/22/2011

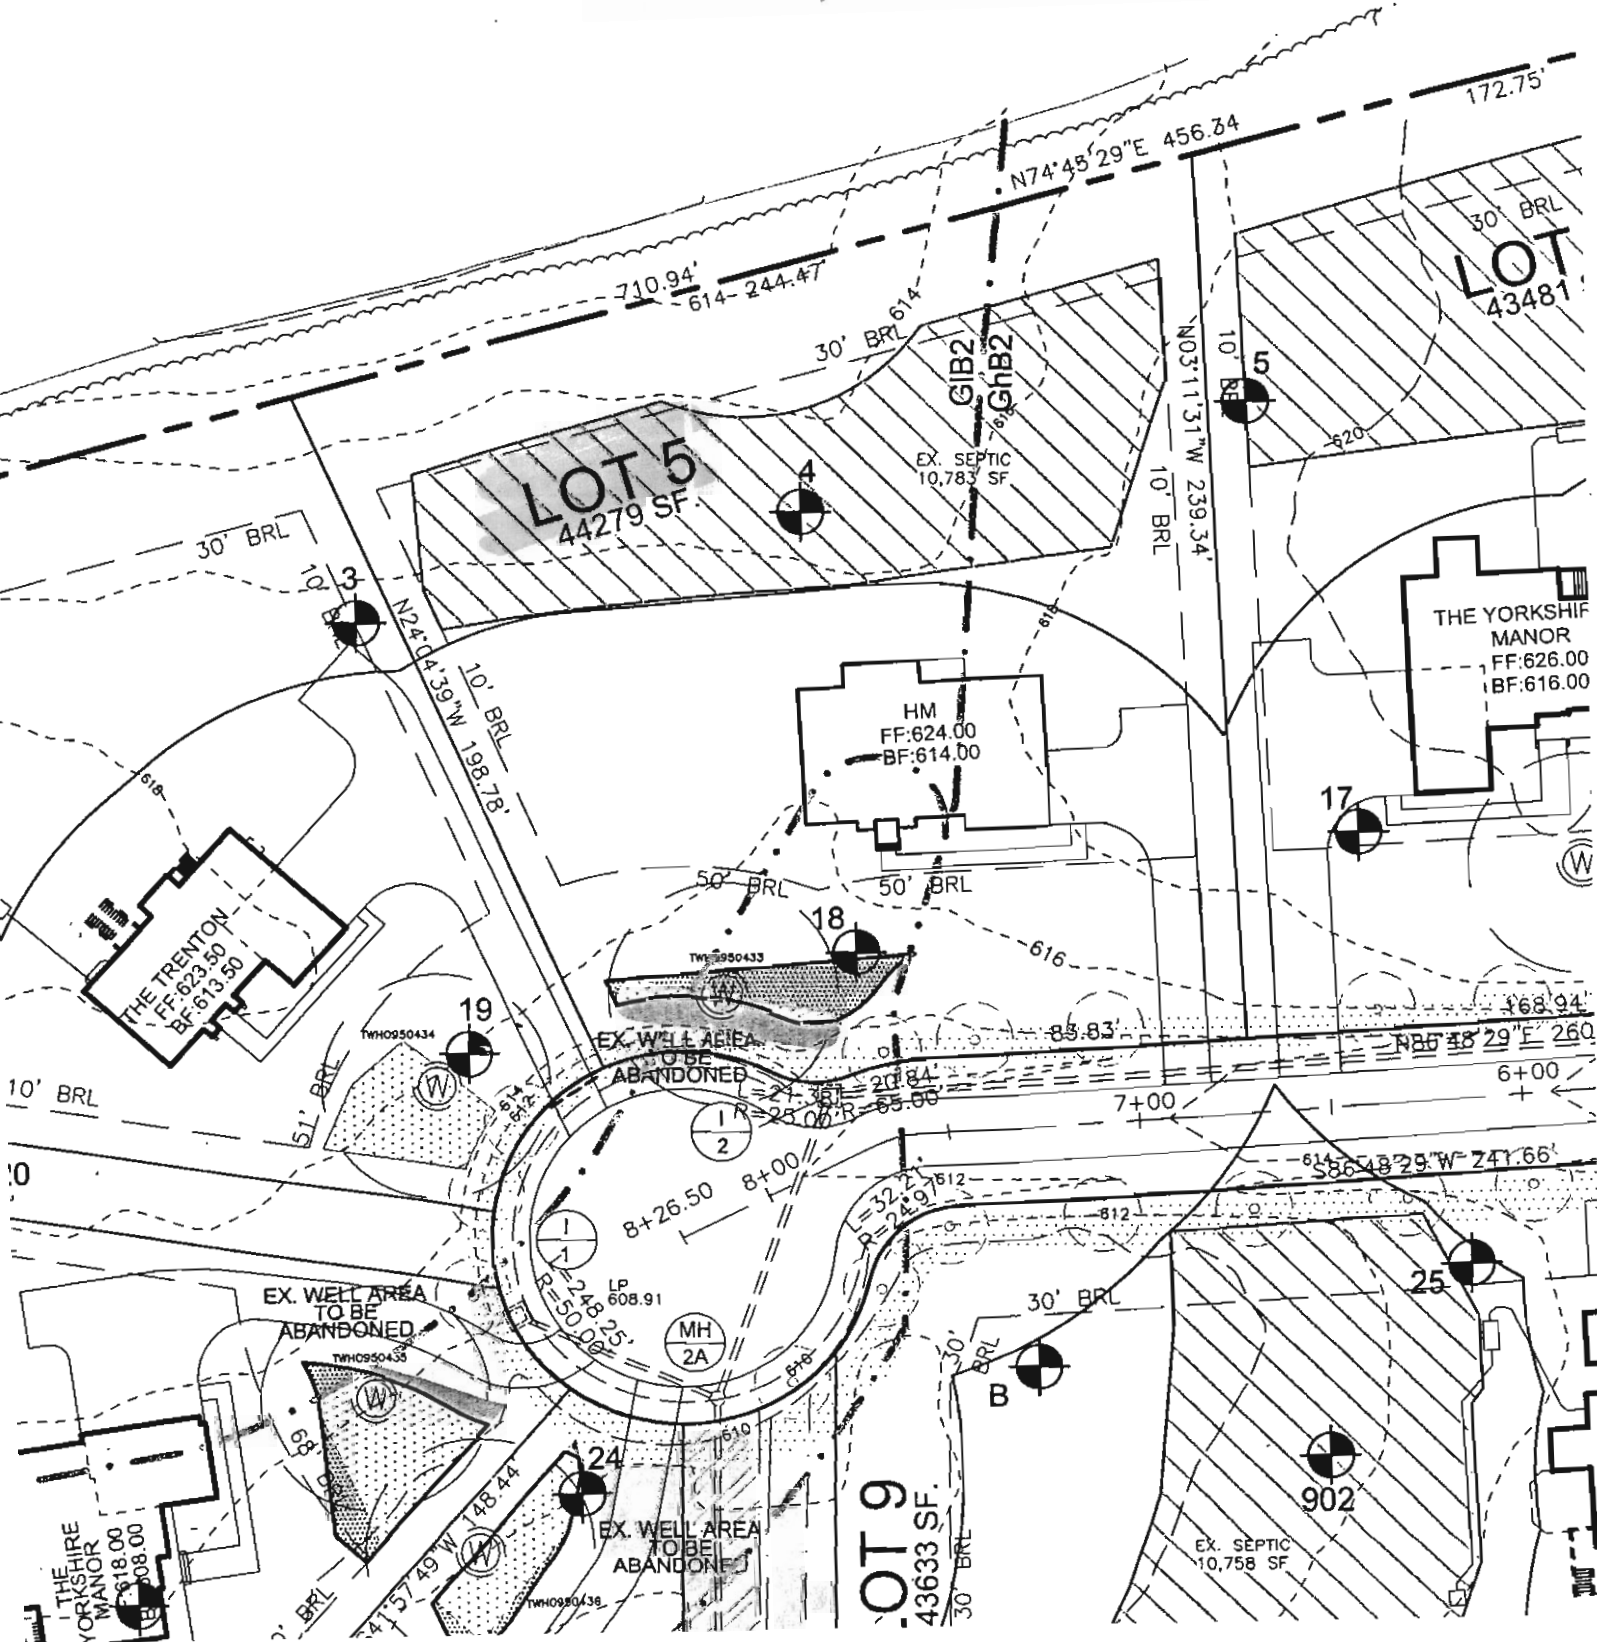

JACK C. FYOCK
TM22-P201
2221/618

Signed
Per
Cert

Superceded 12/22/14

NON-BUILDABLE
PRESERVATION
PARCEL A
137,750 SF
3.16 AC.

LOT 6
40,931 SF

LOT 5
40,080 SF

LOT 4
40,652 SF

LOT 7
42,364 SF

LOT 8
58,067 SF

LOT 9
45,600 SF

LOT 10
41,726 SF

ROAD A

ROAD A

PUBLIC ACCESS PLACE

PARC