
LAYOUT 9-23-0	57 INSP 4		Xo \	
INSP 2 9/-24	/o INSP 5			
INSP 3 9 25	INSP 6	1 /1/20	Day (m)	
ISSUE DATE:	9/2/09	PERMIT	P 531902	
APPROVAL DATE: $9/25/09$ A $\frac{525578}{517386}$				
Tax ID # 05445426 ON-SITE SEWAGE DISPOSAL SYSTEM HOWARD COUNTY HEALTH DEPARTMENT BUREAU OF ENVIRONMENTAL HEALTH				
Winty Ouder	4 Homes	IS PERMITTED TO	INSTALL ⊠ ALTER□	
ADDRESS:	/	PHONE NUMI	BER: 410-480-0023	
SUBDIVISION: F	ulton Ridge	LOT NUMBER	: <u>2</u>	
ADDRESS: 1211	5 Fulton Ridge Drive	PROPERTY OWNE	R: Trinity Quality Homes	
SEPTIC TANK CAPACITY (GALLONS): 2000 OUTLET BAFFLE FILTER REQUIRED				
PUMP CHAMBER CAPACITY (GALLONS): COMPARTMENTED TANK REQUIRED⊠				
NUMBER OF BEDROOMS:		4 APPLICATION F	RATE:1.2	
SQUARE FOOTAGE OF HOUSE:		Unkn Inlest 4	RATE:1.28'	
LINEAR FEET OF TRENCH	I REQUIRED:	Unkn Inlest 4 What I will	L	
TRENCHES:	Trenches to be 2.0 feed depth of feet below g feet of stone below dis	t wide. Inlet 4.0 feet below originate. Effective area begins at	nal grade. Bottom maximum	
LOCATION:	 Set septic tank per layout inspection. Set distribution box near corner of septic easement southwest of large gum tree. Install 200 feet of trench on contour (5) 40' trenches in south portion of septic easement per layout inspection. 			
NOTES:	2. Call for lay 3. Mark utilit	ic easement corners and additional yout inspection. ies tets must be available for Environr	·	
PLANS APPROVED:	Dana Bernard	-	DATE: 9/1/09	
NOTE: PERMIT VOID AFTER 2 YEARS NOTE: CONTRACTOR RESPONSIBLE FOR SCHEDULING A PRE-CONSTRUCTION INSPECTION FOR ALL INSTALLATIONS NOTE: WATERTIGHT SEPTIC TANKS REQUIRED NOTE: ALL PARTS OF SEPTIC SYSTMEM SHALL BE 100 FEET FROM ANY WATER WELL NOTE: MANHOLE PISERS REQUIRED ON ALL SEPTIC TANKS AND PUR OF CHANGE TO SEPTIC TANKS AND PUR OF CHANGE T				

NEITHER THE HOWARD COUNTY COUNCIL OR THE HEALTH DEPARTMENT IS RESPONSIBLE FOR THE SUCCESSFUL OPERATION OF ANY SYSTEM PERMITTEE RESPONSIBLE FOR OBTAINING FINAL APPROVAL ON THIS PERMIT CALL 410-313-1771 FOR INSPECTION OF SEPTIC SYSTEM

NOT TO SCALE	TRENCH/DRAINFIELD DATA WIDTH INLET BOTTOM 2' 4 8' NUMBER OF TRENCHES 3 TOTAL LENGTH
See Separate Steet Ser As-Bui'H	SEPTIC TANK DATA SEPTIC TANK I LEVEL SES MANUFACTURER BAPFLES BAFFLES SES BAFFLE FILTER MANHOLE LOC FORM WATERTIGHT TEST SLOTTED SES DATE ON LID 8-4-09 RUMP/SEPTIC TANK LEVEL MANUFACTURER CANACITY GAL SEAM LOC TANK LID DEPTH BAFFLES BAFFLE FILTER MANHOLE LOC 6" PORT LOC WATERTIGHT TEST SLOTTED SES BAFFLE FILTER MANUFACTURER CANACITY GAL SEAM LOC TANK LID DEPTH BAFFLES BAFFLE FILTER MANHOLE LOC 6" PORT LOC
ROAD NAME	WATERTIGHT TEST
PRE-CONSTRUCTION: 9/23/09 Set Dbook a little but forther med approved Or plan Ren 30.50' drender across The truncles should wrap some as you get in the septie only. Et Button's of true	SDIP on conterm.
INSTALLATION: 9/24/05 (12pm) Jonk Let. Dhoox dry now, Frist load of stone on -site. Med ones, some 18th but ok to use OK to const 9/25/09 Treads (2000/1) of Suites loaks a	me RD
1/25/09 Trendes completed. System looks g bouk 411. (kw) FINAL INSPECTOR	



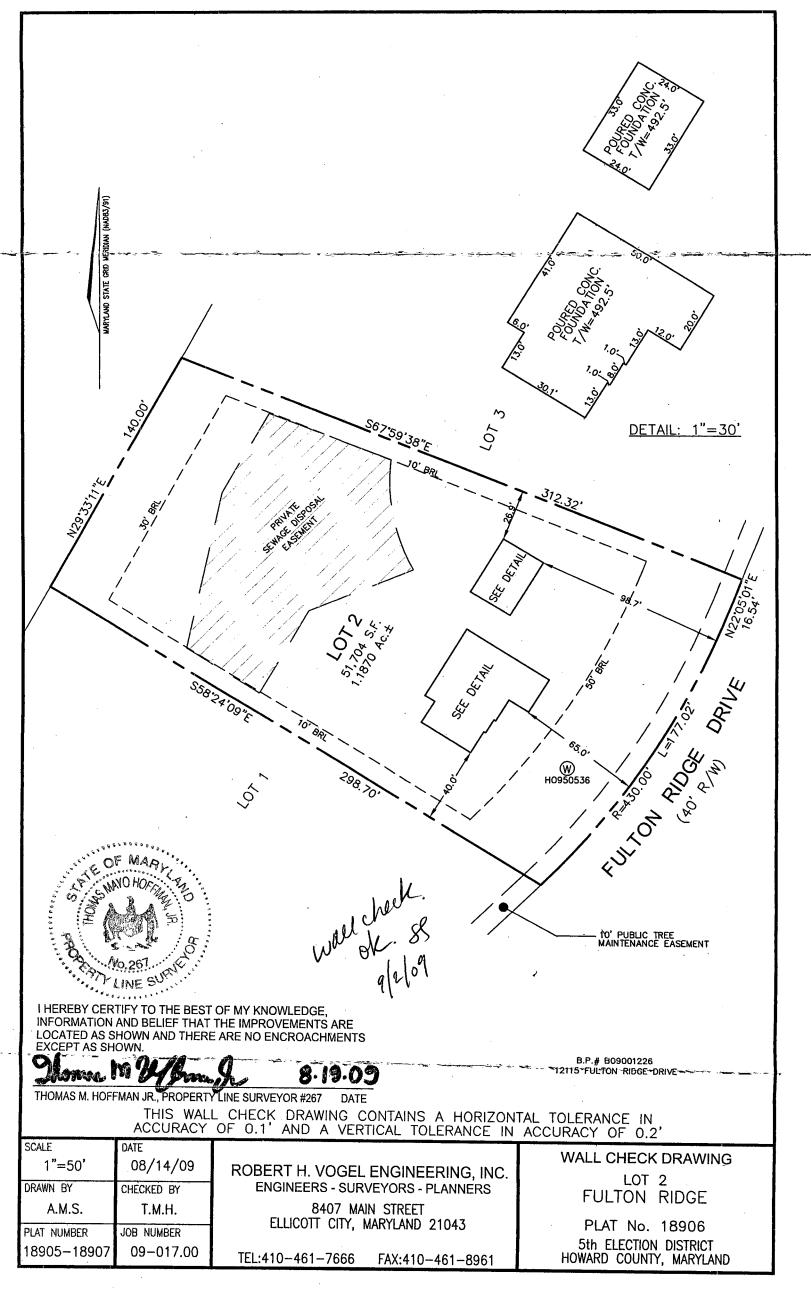

HOWARD COUNTY HEALTH DEPARTMENT

31902

	9 / DATI	109 5
Received //	city Quelity Homes.	PHONE #
- 1000		24 3
☐ CASH	12115 Fulton Kido Dr.	O WAY AND STORY
NO.		* Pertilia
\$ 7410	The herdent new 4 - m	Dollars