


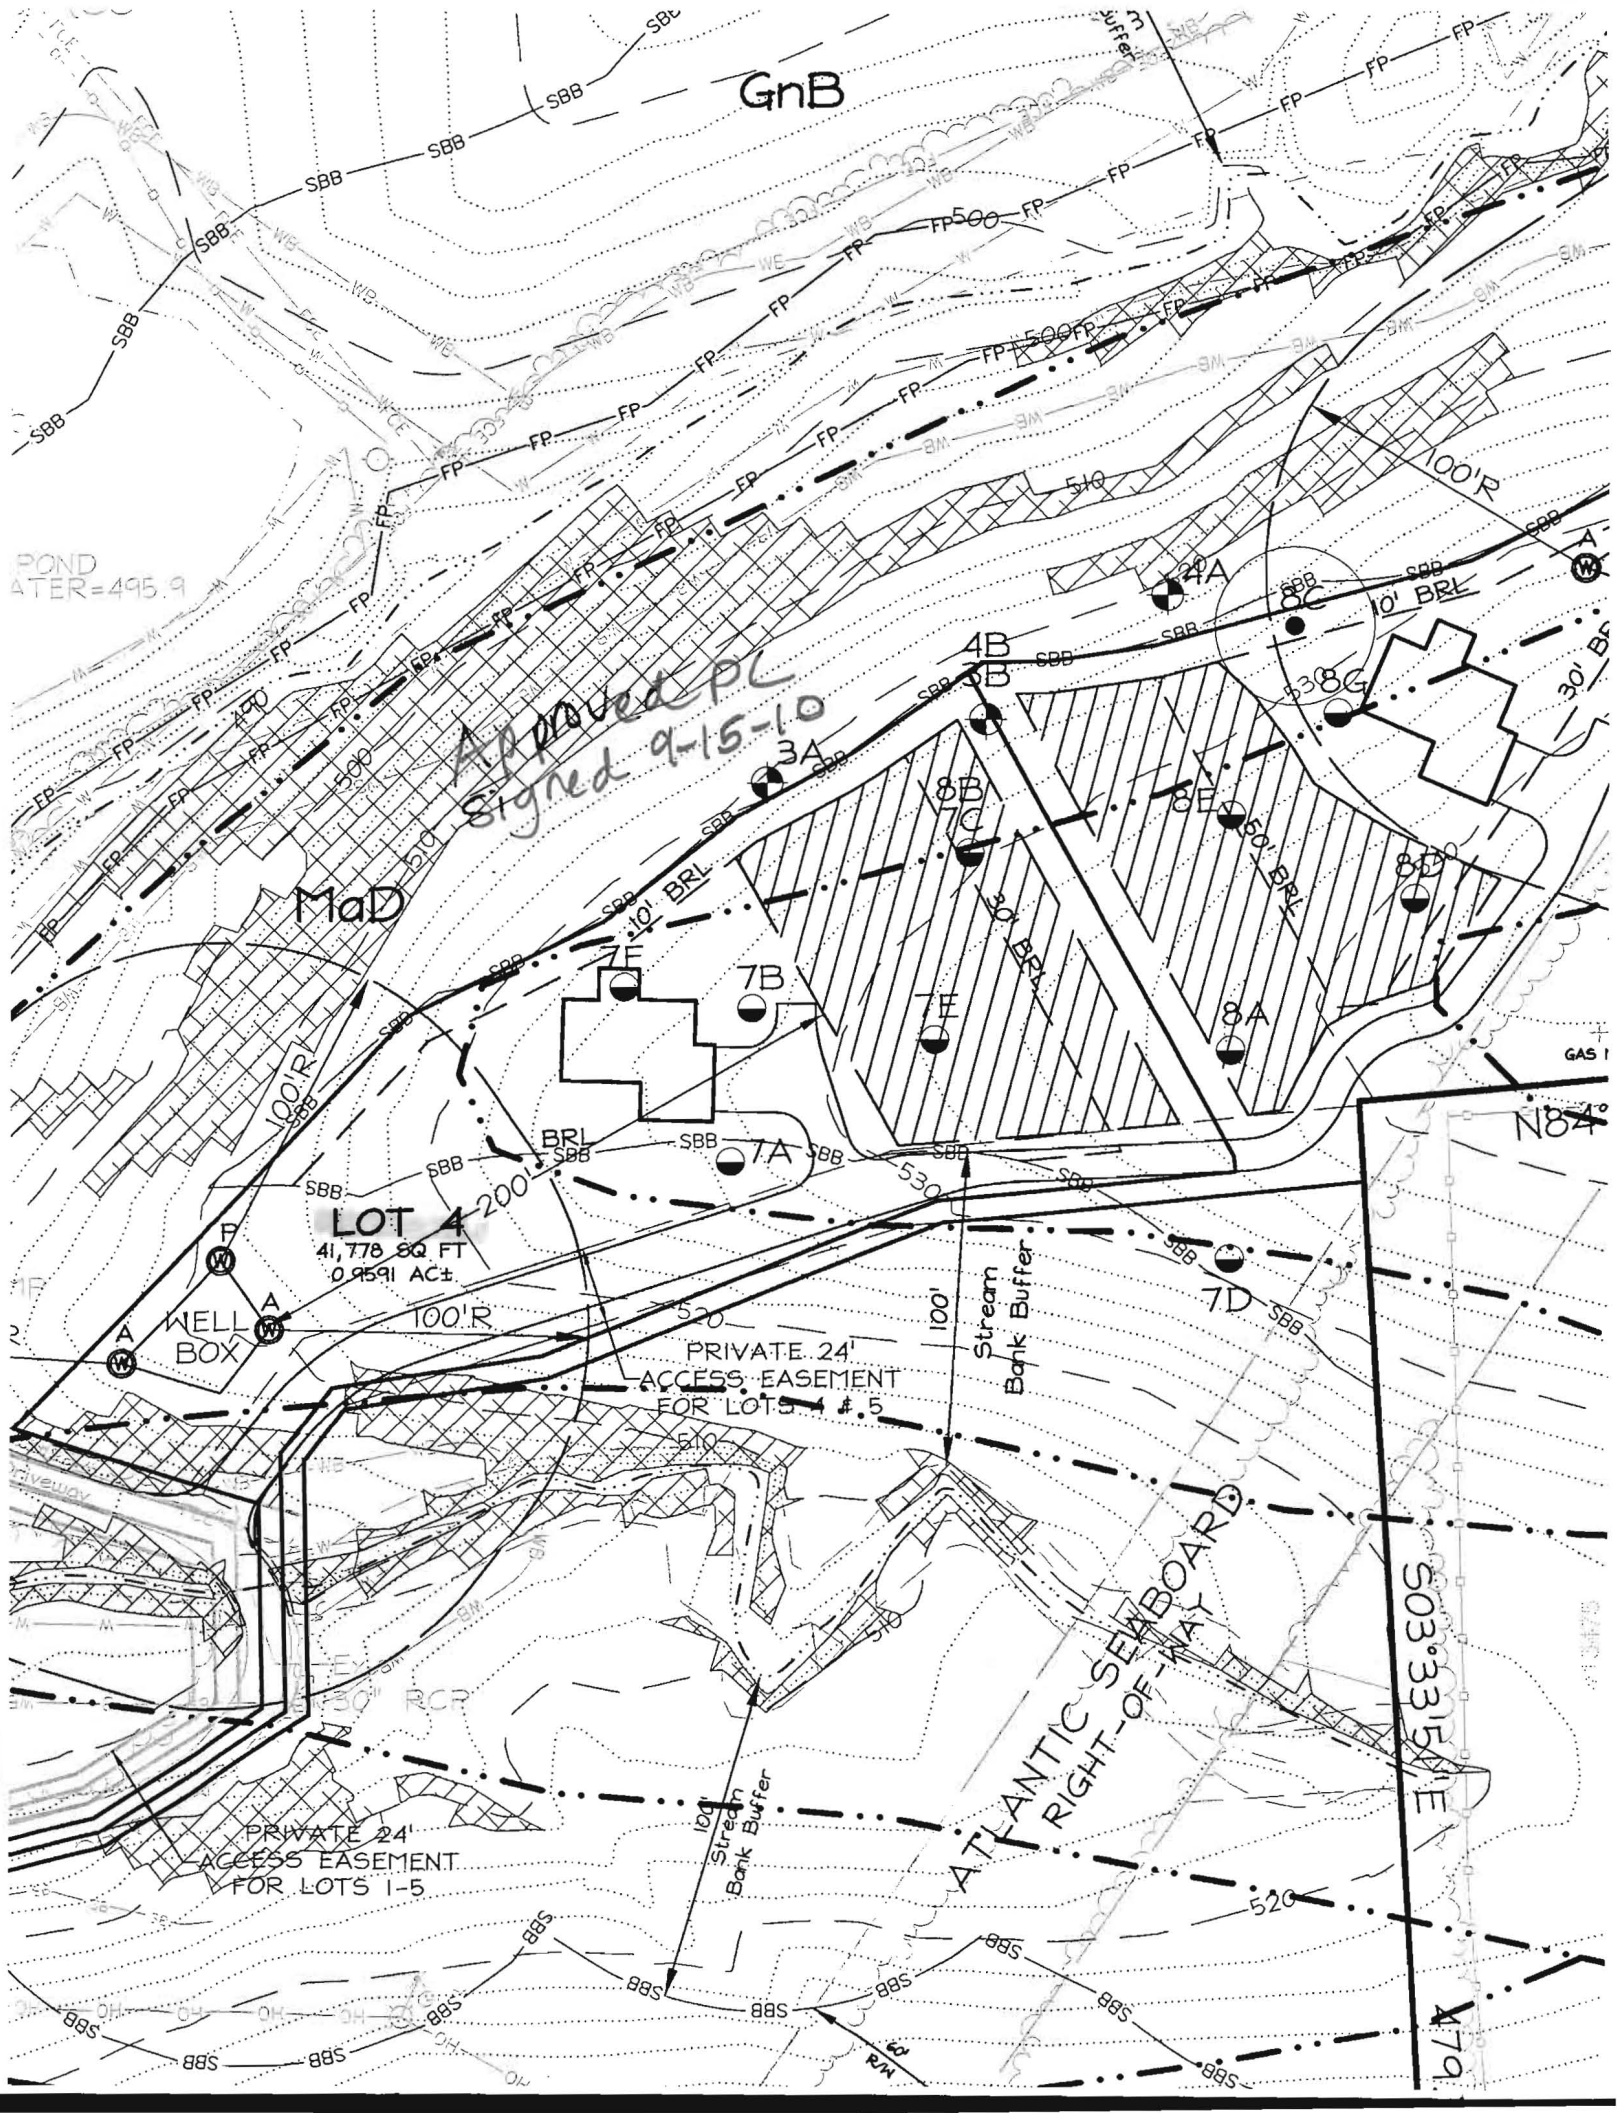

GnB

MaD

Approved PL
Signed 9-15-10

LOT 4
41,778 SQ FT
0.9591 AC±

WELL BOX

PRIVATE 24'
ACCESS EASEMENT
FOR LOTS 1-5

PRIVATE 24'
ACCESS EASEMENT
FOR LOTS 1-5

ATLANTIC SEAWARD
RIGHT-OF-WAY

Stream
Bank Buffer

Stream
Bank Buffer

S03°33'51"E

479

N84°

POND
ATER=495.9