
<b>c</b> 1 0612	1. A C C C C C C C C C C C C C C C C C C	NCE NO.	STATE OF MARYLAND WELL COMPLETION REPORT	THIS REPORT MUST BE SUBMITTED WITHIN 45 DAYS AFTER WELL IS COMPLETED.
1 2 3 6 (THIS NUMBER IS TO BE PUNCHED IN COLS. 3-6 ON ALL CARDS)			FILL IN THIS FORM COMPLETELY PLEASE TYPE	COUNTY ON SRU NUMBER 13 9/14/01
ST/CO USE ONLY DATE Received MM DD YY 8 13	DATE WE MM <u>07</u> 15	BLL COMPL	ETED         Depth of Well           Y         22         26           7         22         26           7         20         (TO NEAREST FOOT)	FROM "PERMIT NO." FROM "PERMIT TO DRILL WELL" HO-94 -3151 28 29 30 31 32 33 34 35 36 37
OWNER STREET OR RFD <sup>Cht</sup> ( SUBDIVISION		Vikin	Development Nille Pol first name TOWN_N SECTION_	H. AIRCH P.243
Not required for	driven wells		GROUTING RECORD WELL HAS BEEN GROUTED (Circle Appropriate Box)	C 3 <sup>1</sup> <sup>2</sup> <u>PUMPING TEST</u>
STATE THE KIND OF FORMAT COLOR, DEPTH, THICKNESS DESCRIPTION (Use	FEET	check	CEMENT CM BENTONITE CLAY	HOURS PUMPED (nearest hour)
additional sheets if needed) Overburden Soft Shale	FROM         TC           0         1           15         5	5 5	NO. OF BAGS 46 NO. OF POUNDS 45 46 GALLONS OF WATER DEPTH OF GROUT SEAL (to nearest foot)	PUMPING RATE (gal. per min.) 10.0 METHOD USED TO MEASURE PUMPING RATE Somersby
Gray Rock'	39 30		trom 48 TOP 52 ft. to 54 BOTTOM 58 ft. (enter 0 if from surface) casing CASING RECORD types insert ST CO	WATER LEVEL (distance from land surface) BEFORE PUMPING $\frac{2}{17}$ 20 ft. WHEN PUMPING 190 ft.
mader at M			Appropriate code below MAIN Nominal diameter Total depth	TYPE OF PUMP USED (for test) A air P piston T turbine
	R LONT OF S		CASING top (main) casing of main casing (nearest inch)! (nearest foot) PL 60 61 63 64 66 70 E OTHER CASING (if used)	C     centrifugal     R     rotary     O     other (describe below)       J     jet     S     submersible
			C C C C C C C C C C C C C C C C C C C	PUMP INSTALLED DRILLER INSTALLED PUMP (CIRCLE) (YES or NO)
	non wento	84NQ	screen type or open hole ST BR HO	IF DRILLER INSTALLS PUMP, THIS SECTION MUST BE COMPLETED FOR ALL WELLS. TYPE OF PUMP INSTALLED PLACE (A,C,J,P,R,S,T,O) 29 IN BOX 29.
ALTERNAL A	F We L		insert appropriate code below BRONZE BRONZE BRONZE HOLE OT OTHER	CAPACITY: GALLONS PER MINUTE (to nearest gallon) 31 35 PUMP HORSE POWER
NUMBER OF UNSUCCESSF	UL WELLS: yes	10	C 2 DEPTH (nearest ft.)	PUMP COLUMN LENGTH (nearest ft.)
	Y		A 9 9 11 15 17 21 C 2 H 2	ASING HEIGHT (circle appropriate box and enter casing height) LAND SURFACE
CIRCLE APPROPRIATE LETTER A WELL WAS ABANDONED AND SEALED WHEN THIS WELL WAS COMPLETED E ELECTRIC LOG OBTAINED P TEST WELL CONVERTED TO PRODUCTION WELL			R 38 39 41 45 47 51 E SLOT SIZE 1 2 3	LOCATION OF WELL ON LOT
I HEREBY CERTIFY THAT THIS WELL HAS BEEN CONSTRUCTED IN ACCORDANCE WITH COMAR 26.04.04 "WELL CONSTRUCTION" AND IN CONFORMANCE WITH ALL CONDITIONS STATED IN THE ABOVE CAPTIONED PERMIT, AND THAT THE INFORMATION PRESENTED HEREIN IS ACCURATE AND COMPLETE TO THE BEST OF MY, KNOWLEDGE.			DIAMETER OF SCREEN (NEAREST OF SCREEN INCH) from to	SHOW PERMANENT STRUCTURE SUCH AS BUILDING, SEPTIC TANKS, AND /OR LANDMARKS AND INDICATE NOT LESS THAN TWO DISTANCES (MEASUREMENTS TO WELL)
DRILLERS LIC. NO. I M HD 3 9 9 1 DRILLERS SIGNATURE (MUST MATCH SIGNATURE ON APPLICATION)			GRAVEL PACK	Tik 19-
Warm Pavel			(NOT TO BE FILLED IN BY DRILLER) T (E.R.O.S.) W Q 70 72	2001
SITE SUPERVISOR (sign. of driller or journeyman responsible for sitework if different from permittee)			TELESCOPE LOG 74 75 76 CASING INDICATOR OTHER DATA	3 100 11

1

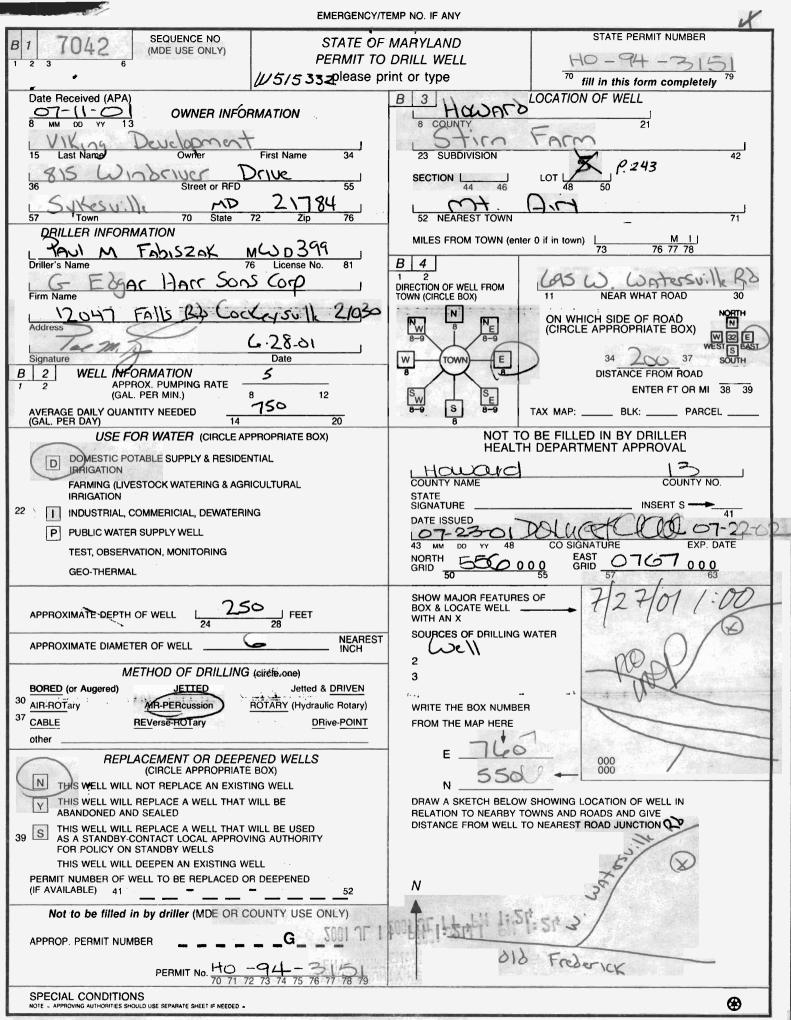

2 COUNTY

Page 1 of Date 1.25-0		r 6		ON SRU 9/14/01		
A. S. S.		FIELD DATA S HOWARD COUNTY WELD				
Well Permit No. Location of pro Subdivision	HO - 94-3	W. Watersvi	NC PO P243Block Plat er Viking Den	Sec		
Depth of well <u>300</u> Distance of measuring point (M.P.) above ground <u>'</u> Static water level (S.W.L.) below M.P. <u>49</u> '						
I. High rate pumping reservoir drawdown Time pump started 0800 Pumping rate 15.00 Total time 15 mm to reach pumping water level 103' ft. below M.P. II. Recovery pump test data - observations to be recorded every 15 minutes						
TIME (in 15	WATER LEVEL	PUMPING RATE	FLOW METER READING	CALCULATED FLOW		
minute in- tervals	below M.P.	time to fill 5 gallon bucket	(if used)	(gallons per minute)		
0800	44,	20		15.0		
0815	103'	22		13.64		
0830	ירכו	24		12.50		
0845	155 '	24		11.54		
0900	141	27		11.11		
0915	185 '	29		10.34		
0930	190'	30		10.00		
0945	190'	30		10.00		
1000	190'	30		10.00		
10.15	1901	30		10.00		
10 30	190'	30		10.00		
1045	190'	30		10.00		
1100	190'	30		10.00		

Page of						
TIME (in 15	WATER LEVEL below M.P.		recorded every 15 minu FLOW METER READING (if used)	CALCULATED FLOW (gallons per minute)		
10:30	190'	30 sec		1068M		

HOWARD COUNTY HEALTH DEPARTMENT BUREAU OF ENVIRONMENTAL HEALTH WATER AND SEWERAGE PROGRAM TEL: (410)313-2640 FAX: (410)313-2648

From Cary Cumberland To Steven Krieg 2-5-02

## Information Form for the Installation of the Well Pump, Pitless Adapter, and Supply Piping

NOTE: The installer is responsible for requesting an inspection prior to 9 am on the day of the desired inspection. No work is to be covered until approved by the Health Department. All installations must comply with the National Standard Plumbing Code (NSPC, as amended locally) and COMAR 26.04.04 (MD Well Construction Regulations). Submission of a complete form is required prior to Use and Occupancy approval.

Company Name: 4/TCTH	Telephone	#: 410 489-4457		
Address: In Gillis F	21/15 Rd			
- Woodp We	MD ZIMI			
(Must circle one) (Licensed Plumber	Licensed Well Driller	Licensed Well Pump Installer		
License # and name of individual res Name (Print): William T. (II		License#7979		
*A licensed individual must perfor	mbelland III	Encense#		
		staller or well driller. Licenses may be		
subjected to field verification.				
Name of Property Owner: B. 11+	Michele Bulimman Eleph	one #: 410 854-6095		
Subdivision: 455 Stira Far		5 Well Tag # : HO - <u>99 - 3151</u>		
Site Address: $643$ (w. 0	Natersville Rd			
Submersible Pump Data	Pitless Adapter	Well Cap and Electric Conduit		
Make: Meyers	Make: Harnso	Two piece watertight cap:		
Model #:	Model#:	Screened, vented well cap:		
Pump Capacity GPM	Depth: (36" min)	Cap secured to casing: Conduit min 18" B.G.:		
Well Yield: GPM Depth of well encountered at time of	NSF approved:	Conduit secured to well cap:		
If pump capacity exceeds well yield,	a low water cut off switch is requ			
Torque arrestors or Cable guards are				
Safety rope, if used, attached to ins				
Piping to house	House Connection	/		
Type: Plastic		bed soil at wall penetration:		
PSI: 160 (160 psi min)	Approximate length of sl	eeve: 5/		
Depth of supply line: 5 (36" min)	Sleeve caulked and seale	d properly:		
The water supply line is required t	to be at least ten feet from the s	entic tank, nump chamber, sewage piping.		
The water supply line is required to be at least ten feet from the septic tank, pump chamber, sewage piping, distribution box, drainfields, and sewage reserve area. If this <u>cannot</u> be accomplished, contact this office for				
approval prior to installation.				
MA M		1-31-02		
Signature of company representative	responsible for installation	date		
For Health Department Use Only – Not to be completed by Installer				
	•			
Date Insp. Requested: 1/3/02 Am Date Insp. Approved: 1/3/02				
Inspection Data: Pitless adapter and water supply line at least 36" below grade				
Two piece cap installed and attached to casing securely Elec. conduit extends at least 18" below grade/attached to cap properly				
Safety rope installed inside of well casing				
· -	ttached properly and casing 8" abo	ove finished grade		
Water supply line	sleeved adequately at house conn			
Adequate grout ob	oserved below pitless adapter			
HD-215(Rev. 8/00)				

