

HOWARD COUNTY PERMIT APPLICATION

PERMIT NUMBER

B00141205

B00141205MER

Building Address 11767 Treadwell

Property Owner's Name Carol B. I. ...

Mill Road Dayton MD 21024

Address 11767 Treadwell

Suite/Apt. #: _____ SDP/WP/Petition #: _____

City Dayton State MD Zip Code 21024

Census Tract 6051.01 Subdivision Glady Atter Corp.

Home Phone 413 812 0660 Work Phone _____

Section _____ Area _____ Lot _____

Applicant's Name & Mailing Address, (if other than stated hereon):

Tax Map 27 Parcel 15 Grid 24

Phone _____ Fax _____

Zoning RR Map Coordinates 15 Lot size 1447Ac

Existing Use A L F (Assisted Living Facility)

Contractor Company SAME

Proposed Use A L F (Assisted Living Facility)

Contact Person _____

Estimated Construction Cost \$ 10,000

Address _____

Description of Work Parking Area

City _____ State _____ Zip Code _____

PA Case 02-241C

License No. _____

Occupant or Tenant Kenwood Care Corp.

Engineer or Architect Company _____

Contact Name _____

Contact Person _____

Address _____

Address _____

City _____ State _____ Zip Code _____

City _____ State _____ Zip Code _____

Phone _____ Fax _____

Phone _____ Fax _____

BUILDING DESCRIPTION - COMMERCIAL

BUILDING DESCRIPTION - RESIDENTIAL

Building Characteristics

Utilities

Height: _____
No. of stories: _____
Gross area, sq. ft. per floor: _____
Use group: _____
Construction type:
☐ Reinforced Concrete
☐ Structural Steel
☐ Masonry
☐ Wood Frame
☐ State Certified Modular

Water Supply:
☐ Public
☐ Private
Sewage Disposal:
☐ Public
☐ Private
Electric Yes ☐ No ☐
Gas Yes ☐ No ☐
Heating System:
Electric ☐ Oil ☐
Natural Gas ☐
Propane Gas ☐
Sprinkler system: N/A ☐
☐ Full
☐ Partial
☐ Other Suppression
of Heads _____

Building Characteristics

Utilities

SF Dwelling ☐ SF Townhouse ☐
Depth Width
1st floor: _____
2nd floor: _____
Basement: _____
Finished Basement ☐ Unfinished Basement ☐
Crawl space ☐ Slab on Grade ☐
No. of Bedrooms: _____
Multi-family dwellings:
No. of efficiency units: _____
No. of 1 BR units: _____
No. of 2 BR units: _____
No. of 3 BR units: _____
Other Structure: _____
Dimensions: _____
Footings: _____
Roof: _____
☐ State Certified Modular
☐ Manufactured Home

Water Supply:
☐ Public
☐ Private
Sewage Disposal:
☐ Public
☐ Private
Electric Yes ☐ No ☐
Gas Yes ☐ No ☐
Heating System:
Electric ☐ Oil ☐
Natural Gas ☐
Propane Gas ☐
Sprinkler system: N/A ☐
☐ NFPA #13D
☐ NFPA #13R
☐ Other:

THE UNDERSIGNED HEREBY CERTIFIES AND AGREES AS FOLLOWS: (1) THAT HE/SHE IS AUTHORIZED TO MAKE THIS APPLICATION; (2) THAT THE INFORMATION IS CORRECT; (3) THAT HE/SHE WILL COMPLY WITH ALL REGULATIONS OF HOWARD COUNTY WHICH ARE APPLICABLE THERE TO; (4) THAT HE/SHE WILL PERFORM NO WORK ON THE ABOVE REFERENCED PROPERTY NOT SPECIFICALLY DESCRIBED IN THIS APPLICATION; (5) THAT HE/SHE GRANTS COUNTY OFFICIALS THE RIGHT TO ENTER ONTO THIS PROPERTY FOR THE PURPOSE OF INSPECTING THE WORK PERMITTED AND POSTING NOTICES.

Applicant's Signature

Print Name

Title/Company

Date

Checks payable to: DIRECTOR OF FINANCE OF HOWARD COUNTY

** PLEASE WRITE NEATLY AND LEGIBLY. **


- 1.
- 2.
APPROVED

WALK-THRU BUILDING PERMIT

BP# 00141205 A# 5162010
 APP. SAN P.A.Y. DATE: 12-27-04
 DESC. OF WORK: parking lot

ON & SALLY ANN THOMPSON
 AP 27, PARCEL 66
 988/570

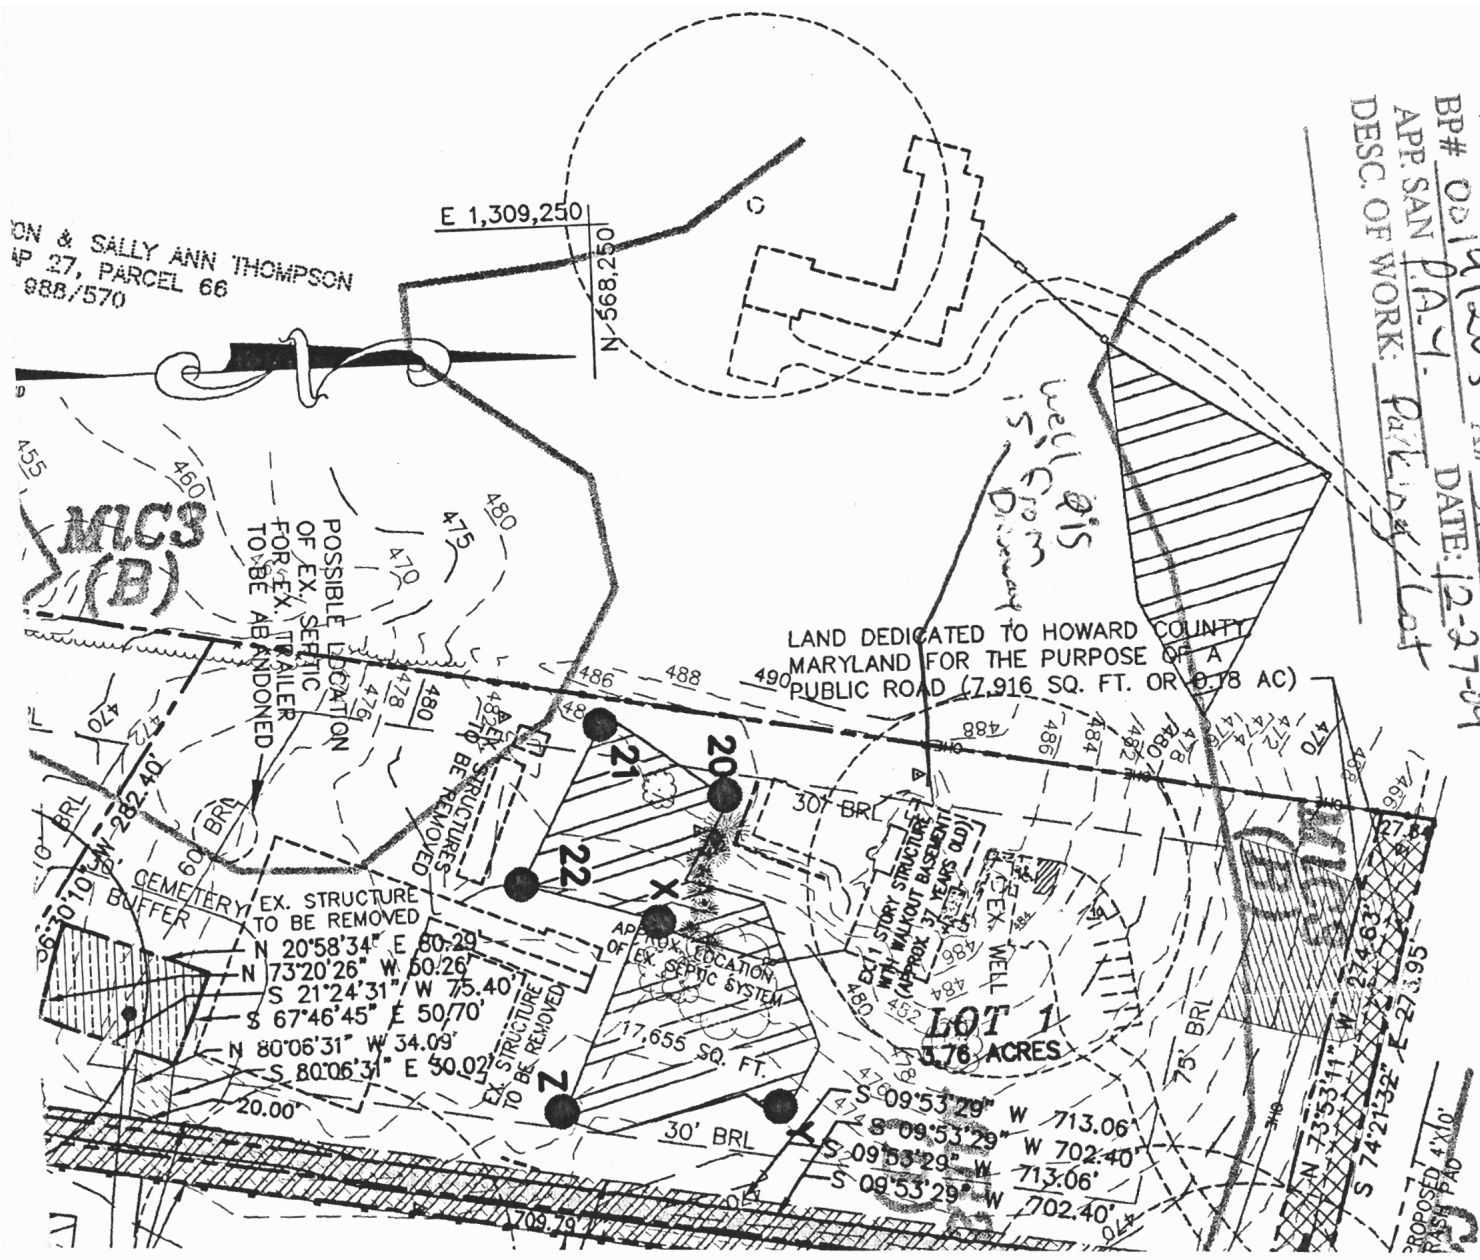

30' BRL
 11.55.57 N
 73.42.41 S
 567.22.37