


H0-73-2542

A/P (A)

1-1.5' Br Loam  
 Beige Sa Loam  
 2.5' Light Br Loamy Sa ~10% Saprolite  
 14' Dry

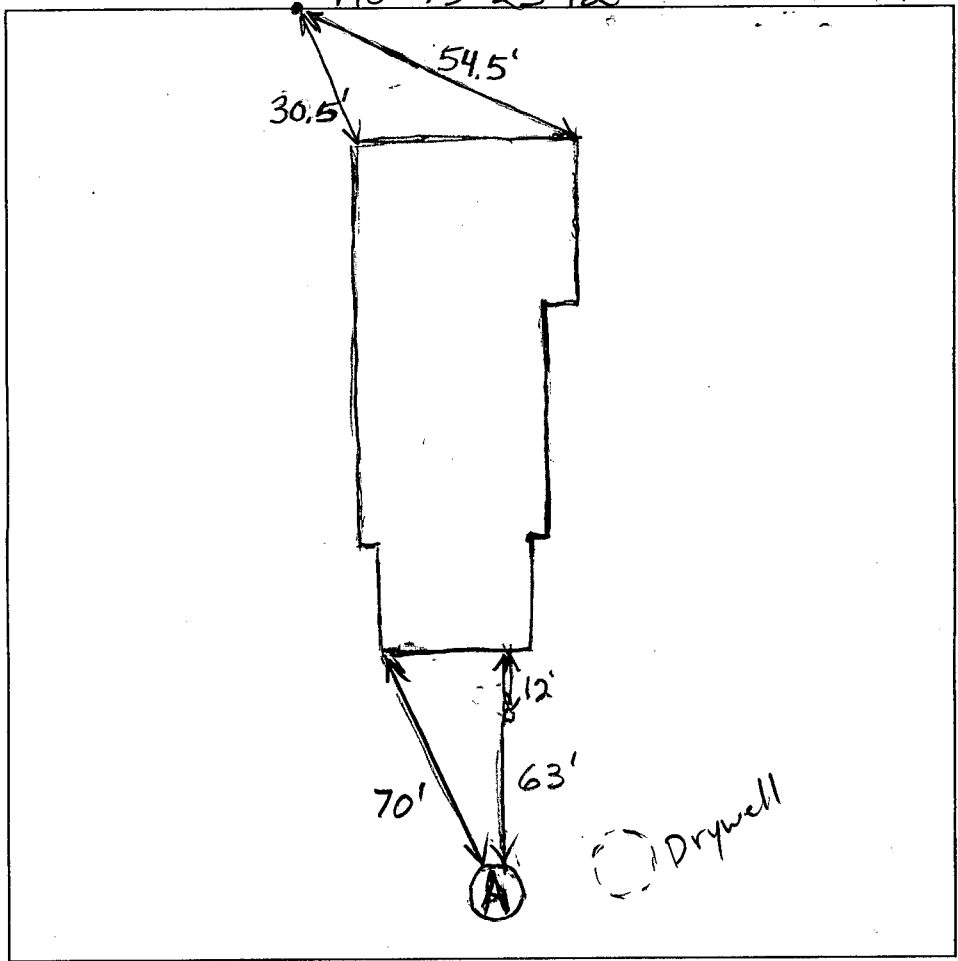

DATE	TEST #	DEPTH	START	BREAK 1" DROP	STOP 2" DROP	TIME OF 2nd INCH	P/F/H
6/30/08	A	5' 14"				1 1/2	Fast
		Repour	10:50	10:52	10:54:30	2 1/2	P

REMARKS \_\_\_\_\_  
 SANITARIAN B. Baker BACKHOE Hatfield OTHERS D. Satorius  
 TEST HOLES USED IN SDA \_\_\_\_\_ AVG. PERC TIME \_\_\_\_\_ SQ. FT/BR \_\_\_\_\_  
 TRENCH WIDTH \_\_\_\_\_ INLET DEPTH \_\_\_\_\_ MAX. BOT DEPTH \_\_\_\_\_ EFFECTIVE SW \_\_\_\_\_



Fee Paid \$ \_\_\_\_\_  
Receipt #P \_\_\_\_\_

SEPTIC SYSTEM REPAIR / UPGRADE / EVALUATION REQUEST

**Please fill out this form completely and check off the reason for the request**

Date Requested: 6/17/08

**Reason for Request:**

Failing System (includes surface discharge or inadequate treatment zone) X  
Has the contractor verified through excavation/pumping evaluation, that there are no pipe blockages? YES (Fyock)  
\*System relocation for proposed addition for setback compliance NO  
\*Verification of adequate system capacity per COMAR 26.04.02.02D (4) N/A  
To replace collapsed septic tank \_\_\_\_\_  
To replace collapsed drywell \_\_\_\_\_  
To do a minor repair (fix or replace distr. box, piping or lift station) \_\_\_\_\_

Septic Contractor: \_\_\_\_\_  
Contractor's Address: \_\_\_\_\_  
Contractor's Phone #: \_\_\_\_\_

Property Address: 6602 Blackwatch Ln Highland MD  
Property (Subdivision) & Lot # Highland Lakes 20777  
Owner's Name: Duane + Colleen Satorius  
Is public sewer available/nearby: NO  
**If public sewer may be close, mention further research will be performed to verify availability**  
Names of Any Previous Owners: Francis Lowman  
Year House Built: 1978  
# of Existing Bedrooms: 4  
# of Bedrooms after completion of addition: N/A  
Has this request been discussed previously with another Sanitarian: NO  
If yes, then with whom?: \_\_\_\_\_

**X A Sanitarian will be in contact within three business days depending upon the urgency of the situation to coordinate the scheduling of the repair / upgrade / evaluation. No inspection will be performed without fee collection at the office.**

Duane Satorius - owner  
301-317-1514 / home  
301-618-1924 / work