
SEQUENCE NO. THIS REPORT MUST BE SUBMITTED WITHIN STATE OF MARYLAND (MDE USE ONLY) 45 DAYS AFTER WELL IS COMPLETED. **WELL COMPLETION REPORT** FILL IN THIS FORM COMPLETELY COUNTY (THIS NUMBER IS TO BE PUNCHED A09607 NUMBER PLEASE PRINT OR TYPE IN COLS. 3-6 ON ALL CARDS) DATE WELL COMPLETED da PERMIT NO ST/CO USE ONLY Depth of Well FROM "PERMIT TO DRILL WELL" DATE Received "aar 720 3600 10-94-2270 (TO NEAREST FOOT) 29 30 31 32 33 34 35 36 37 JIM OWNER. WALT ANN DA TOWN GLENELL STREET OR RFD. SUBDIVISION SHIPHEADS LOT **SECTION** WELL LOG **GROUTING RECORD** 3 C Not required for driven wells WELL HAS BEEN GROUTED (Circle Appropriate Box) PUMPING TEST STATE THE KIND OF FORMATIONS PENETRATED, THEIR COLOR, DEPTH, THICKNESS AND IF WATER BEARING TYPE OF GROUTING MATERIAL (Circle one) HOURS PUMPED (nearest hour) CEMENT CM BENTONITE CLAY B C check if water DESCRIPTION (Use additional sheets if needed) FROM то NO. OF BAGS 46 16 bearing _ NO. OF POUNDS 13 200 PUMPING RATE (gal. per min.) GALLONS OF WATER_ METHOD USED TO TOP SOIL 0 DEPTH OF GROUT SEAL (to nearest foot) Z MEASURE PUMPING RATE from 52 ft. to _____ WATER LEVEL (distance from land surface) Jandy BOTTOM 3 35 (enter 0 if from surface) BEFORE PUMPING CASING RECORD 40 casing 35 types CONCRETE insert WHEN PUMPING 50 40 appropriate code OT TYPE OF PUMP USED (for test) below 55 A piston turbine Nominal diameter Total depth MĂIN top (main) casing of main casing 190 CASING other (nearest foot) (nearest inch)! TX/P/E centrifugal (describe TL below) 27 155 64 66 60 61 63 J submersible OTHER CASING (if used) 155 320 depth (feet) diameter inch from **PUMP INSTALLED** (NO) DRILLER WILL INSTALL PUMP YES (CIRCLE) (YES or NO) IF DRILLER INSTALLS PUMP, THIS SECTION MUST BE COMPLETED FOR ALL WELLS. SCREEN RECORD screen type TYPE OF PUMP INSTALLED 29 PLACE (A,C,J,P,R,S,T,O) or open hole HO ST BR IN BOX 29. insert CAPACITY appropriate **BRONZE** HOLE GALLONS PER MINUTE code IOITI 35 PILI (to nearest gallon) below PUMP HORSE POWER 41 2 DEPTH (nearest ft.) PUMP COLUMN LENGTH NUMBER OF UNSUCCESSFUL WELLS: (nearest ft.) 43 E CASING HEIGHT (circle appropriate box 21 WELL HYDROFRACTURED Υ Ν and enter casing height) + above C LAND SURFACE CIRCLE APPROPRIATE LETTER 49 36 26 30 32 A WELL WAS ABANDONED AND SEALED WHEN THIS WELL WAS COMPLETED (nearest) below foot) **ELECTRIC LOG OBTAINED** 39 41 TEST WELL CONVERTED TO PRODUCTION LOCATION OF WELL ON LOT WELL SLOT SIZE 1 ___ __ 2 _ I HEREBY CERTIFY THAT THIS WELL HAS BEEN CONSTRUCTED IN ACCORDANCE WITH COMAR 26.04.04 "WELL CONSTRUCTION" AND IN CONFORMANCE WITH ALL CONDITIONS STATED IN THE ABOVE CAPTIONED PERMIT, AND THAT THE INFORMATION PRESENTED HEREIN IS ACCURATE AND COMPLETE TO THE BEST OF MY KNOWLEDGE. SHOW PERMANENT STRUCTURE SUCH AS BUILDING, SEPTIC TANKS, AND /OR DIAMETER (NEAREST LANDMARKS AND INDICATE NOT LESS OF SCREEN INCH) 56 THAN TWO DISTANCES (MEASUREMENTS TO WELL) from to I not LINE DRILLERS LIC. NO. 1 GRAVEL PACK LIF WELL DRILLED 220 WAS FLOWING WELL PORD DRILLERS SIGNATURE (MUST MATCH SIGNATURE ON APPLICATION) MDE USE ONLY (NOT TO BE FILLED IN BY DRILLER) EX+ LIC. NO. I M D T (E.R.O.S.) W Q 70 72 SITE SUPERVISOR (sign. of driller or journeyman 74 75 76 LOG INDICATOR TELESCOPE responsible for sitework if different from permittee) OTHER DATA COUNTY

DENV-Permit 97

NOTE . APPROVING AUTHORITIES SHOULD USE SEPARATE SHEET IF NEEDED .

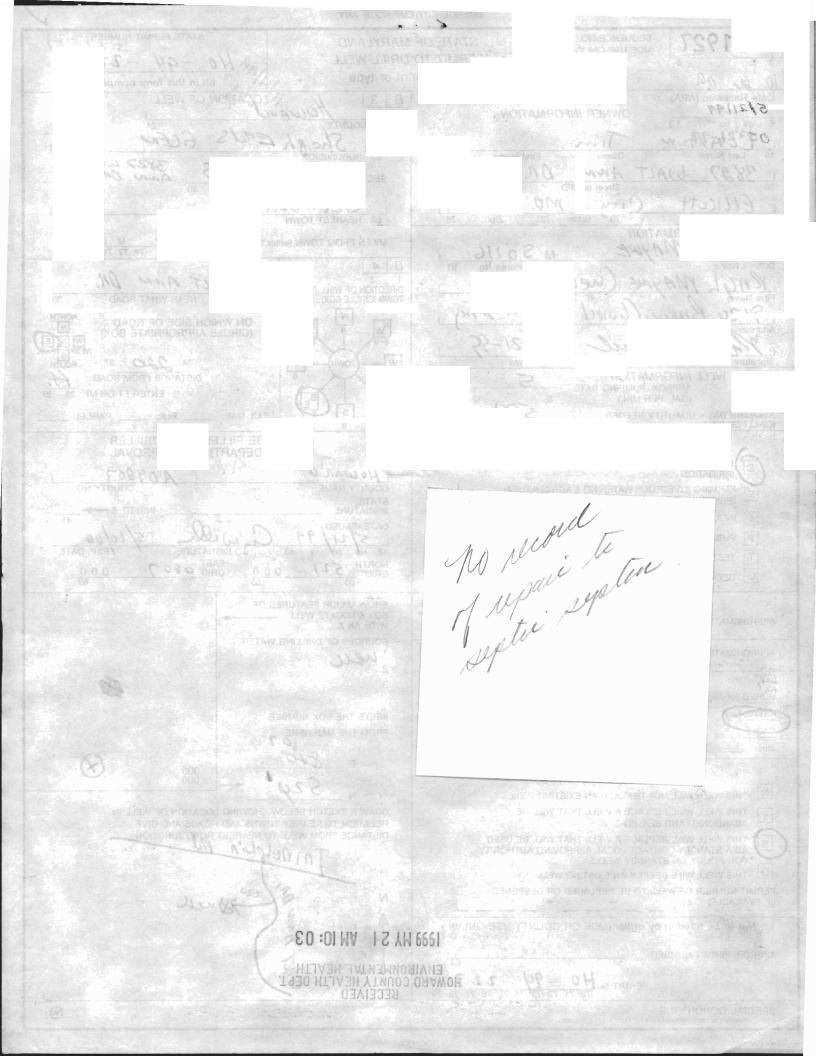

HOWARD COUNTY HEALTH DEPARTMENT Bureau of Environmental Health 3525-H Ellicott Mills Drive Ellicott City, MD 21043 461-9933

APPLICATION FOR PITLESS ADAPTER, WELL PUMP AND PRESSURE TANK INSTALLATION

New Installation Replacement	Receipt # Date 5/6/99 Menony Telephone 4/0 988-9221
Name of Installer Of Wa	Telephone 710 18 5 72 13
License Number 9805 Certified Well Pump Instal	ler Well Driller Registered Plumber 1/23
Name of Property Owner Subdivision Supervis (New York)	Telephone 4/0 442-15/0 Telephone 4/0 442-15/0 Mell Tag #
Pump	Moton 4 Ditlace Adenten
1. Type	
a. Deep well jet	1. Horsepower 4 1. Make 2. RPM 2. Model # 11
b. Shallow well jet	3. Voltage 120 3. Depth
c. Submersible	a. 110
2. Make	b. 220
3. Model #	· ·
4. CapacityG 5. Pump exceeds well capac	rm Stur Vee No
	cutoff switch installed? Yes No
	o protect the pump and electrical wiring from
vibrations? Torque ar	restors Cable guards Other
Tank	Piping 0/ Well data
1. Capacity	1. Type profit 1. Depth 320 ft.
2. Pressure relief	2. Size In 2. Yield 6 GPM
valve?	3. NSF and/or BOCA 3. Static water
	Code approved level ft.
	4. Depth of supply 4. Will water supply
	line 360 be disinfected by installer? Intormated yes
	y responsibility to notify the Howard County Health
	lation is ready for inspection (otherwise this permit
is null and void).	
	e is true to the best of my knowledge.
WPION	gnature of Applicant: Moran (u)
5/27/99	Tolorio -
SKU	Date: 5/26/99

Note: A sticker indicating approval/status of the installation will be placed on the well casing at the time of the inspection.