


$12 \frac{4}{5} \frac{108}{5} \frac{12}{4} \frac{12}{4} \frac{12}{4}$
 476
 336
 357

INDICATE NORTH. - NAME ADJOINING ROADWAY AS BASE LINE.

PERMIT CARD Signed
 SEPTIC TANK, LEVEL 1000 gal. CLEANOUTS 0
 DISTRIBUTION BOX, LEVEL _____
 TILE FIELD, DEPTH _____ FT. TRENCH WIDTH _____ FT.
 GRAVEL DEPTH _____ IN. TOTAL LENGTH _____ FT.
 NUMBER OF TRENCHES _____ TOTAL BOTTOM AREA _____
 SEEPAGE PITS, INSIDE DIAMETER outside perimeter 14 FT. DEPTH BELOW INLET 8 1/2 FT.
 ABSORBENT AREA 476 SQ. FT.

REMARKS _____

DATE SYSTEM APPROVED 8/8/69 INSPECTOR R. Torre

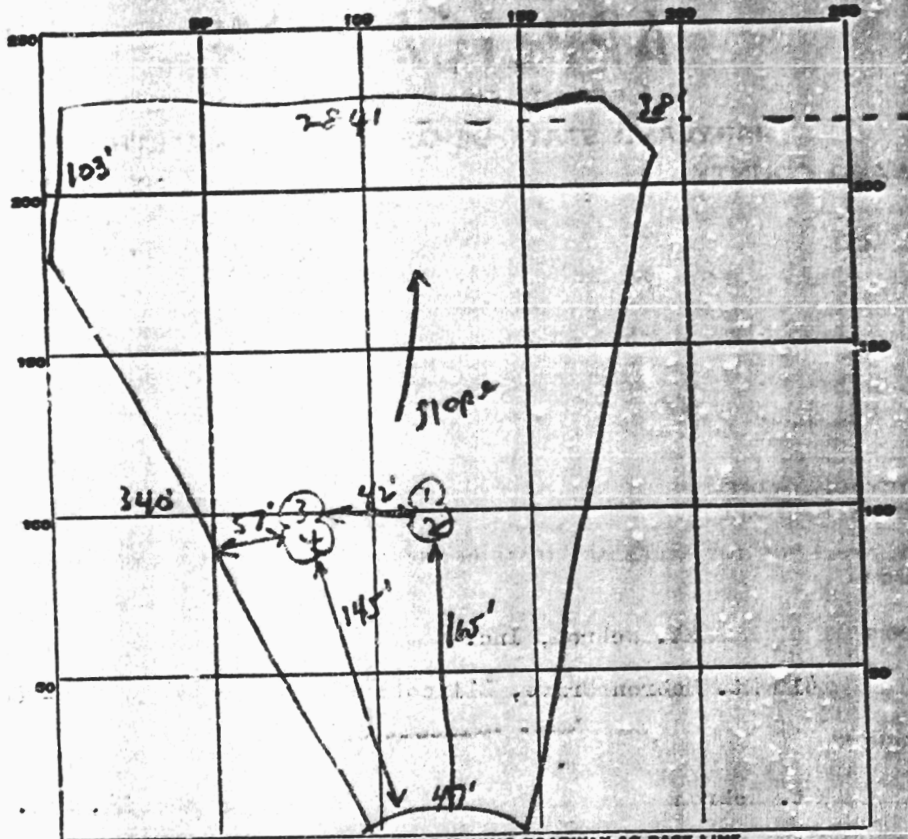

INDICATE NORTH. - NAME ADJOINING ROADWAY AS BASE LINE.

Mt. Hebron Ct.

DATE	TEST NO.	DEPTH	PRE-WET		TEST - 1" DROP		TIME
			START	STOP	START	STOP	
1/22/60	1	4'	2:25	2:27	2:27	2:29	2 min
	2	4 1/2'	2:25	2:27	2:27	2:31	4 min
	3	3 1/2'	2:27	2:29	2:29	2:35	6 min
	4	9'	2:27	2:29	2:29	2:31	2 min

Overturn
4 min
Depth below
inlet 3ft

SOIL AUGER FINDING _____

TESTED BY JHK

REMARKS _____

Lot 14 B1K A Sec 9