

LAYOUT _____ INSP 4 _____
INSP 2 _____ INSP 5 _____
INSP 3 _____ INSP 6 _____

ISSUE DATE: _____

APPROVAL DATE: _____

**PERMIT
INDEXED**

05-351626

P _____

A 516967-A

**ON-SITE SEWAGE DISPOSAL SYSTEM
HOWARD COUNTY HEALTH DEPARTMENT
BUREAU OF ENVIRONMENTAL HEALTH**

_____ IS PERMITTED TO INSTALL ☐ ALTER ☐

ADDRESS: _____ PHONE NUMBER: _____

SUBDIVISION: Holiday Hills LOT NUMBER: 82

ADDRESS: 10826 Vista Road PROPERTY OWNER: Thomas Gardner

SEPTIC TANK CAPACITY (GALLONS): _____ OUTLET BAFFLE FILTER REQUIRED ☐

PUMP CHAMBER CAPACITY (GALLONS): _____ COMPARTMENTED TANK REQUIRED ☐

NUMBER OF BEDROOMS: _____

SQUARE FEET PER BEDROOM: _____

LINEAR FEET OF TRENCH REQUIRED: _____

TRENCHES:	Trench to be _____ feet wide. Inlet _____ feet below original grade. Bottom maximum depth _____ feet below original grade. Effective area begins at _____ feet below original grade. _____ feet of stone below distribution pipe.
LOCATION:	
NOTES:	

PLANS APPROVED: _____ DATE: _____

NOTE: PERMIT VOID AFTER 2 YEARS

NOTE: CONTRACTOR RESPONSIBLE FOR SCHEDULING A PRE-CONSTRUCTION INSPECTION FOR ALL INSTALLATIONS

NOTE: WATERTIGHT SEPTIC TANKS REQUIRED

NOTE: ALL PARTS OF SEPTIC SYSTEM SHALL BE 100 FEET FROM ANY WATER WELL

NOTE: MANHOLE RISERS REQUIRED ON ALL SEPTIC TANKS AND PUMP CHAMBERS UNLESS SPECIFICALLY AUTHORIZED

**NEITHER THE HOWARD COUNTY COUNCIL NOR THE HEALTH DEPARTMENT IS
RESPONSIBLE FOR THE SUCCESSFUL OPERATION OF ANY SYSTEM
PERMITTEE RESPONSIBLE FOR OBTAINING FINAL APPROVAL ON THIS PERMIT
CALL 410-313-2640 FOR INSPECTION OF SEPTIC SYSTEM**

A516967-A

10/29/65

PERMIT

SEWAGE DISPOSAL SYSTEM

MARYLAND STATE DEPARTMENT OF HEALTH

HOWARD COUNTY

ELLIGOTT CITY

DISTRICT

INDEXED

DATE 9/28/65

Frank W. Robbins

IS PERMITTED TO INSTALL ☒ ALTER ☐

ADDRESS 112 Hunting Lane, Hampdenville, Maryland

PHONE AT 642554

A SEWAGE DISPOSAL SYSTEM LOCATED AT

SUBDIVISION Holiday Hills

ROAD Vista Rd.

LOT 32, Sec. 6

PROPERTY OWNER same as above

ADDRESS

SPECIFICATIONS - 3 bedrooms

DRAIN FIELD DEPTH FEET, BOTTOM AREA SQ. FT.

SEEPAGE PITS ABSORBENT SIDE-WALL AREA SQ. FT.

SEPTIC TANK CAPACITY 750 GALLONS

FOR GARBAGE GRINDER, INCREASE DISPOSAL AREA 22% & TANK CAPACITY 50%.

dry well - 12 ft. in dia. by 8 ft. deep below the inlet pipe located 121 ft. from the rear lot line and 57 ft. from the left side lot line when facing the lot from Vista Rd.


PLANS APPROVED BY J. H. Kilgore

DATE 5/28/65

FILL SEPTIC TANK AND DISTRIBUTION BOX WITH WATER BEFORE CALLING FOR AN INSPECTION. COVER NO WORK UNTIL INSPECTED AND APPROVED.

NEITHER THE HOWARD COUNTY COMMISSIONERS NOR THE HEALTH DEPARTMENT IS RESPONSIBLE FOR THE SUCCESSFUL OPERATION OF ANY SYSTEM.

10/29/65

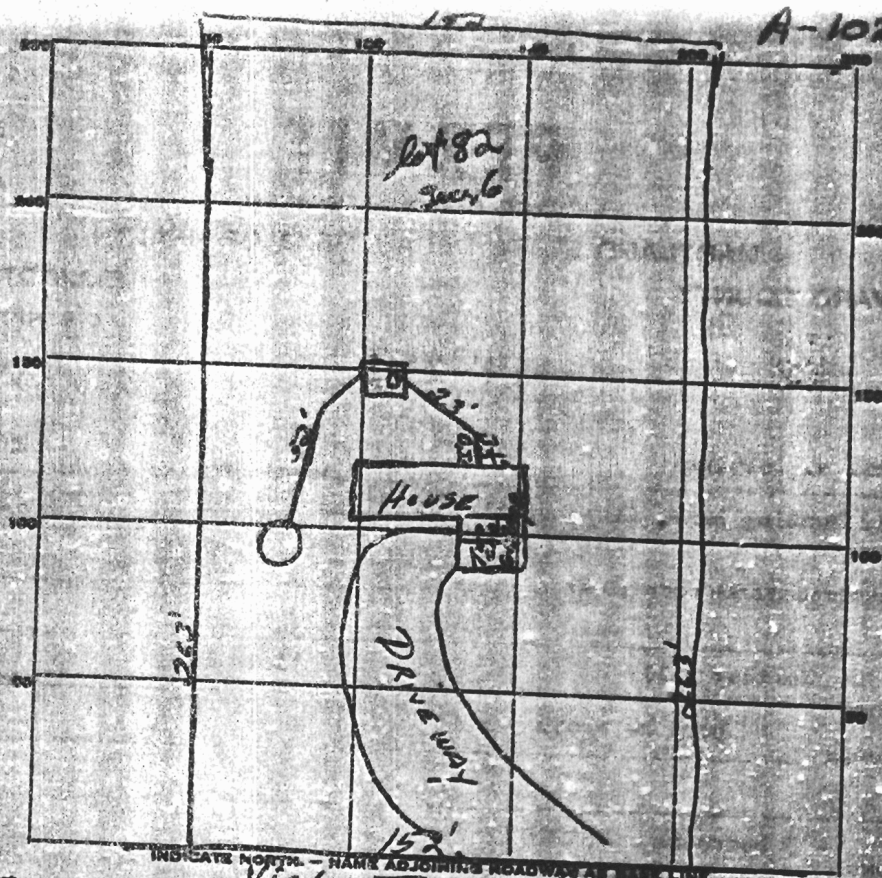

A-10255

1:21 P.M.

INDICATE NORTH - NAME ADJOINING ROADWAY AS BASE LINE.

PERMIT CARD None Seen

SEPTIC TANK, LEVEL Concrete - 100 gals.

CLEANOUTS 8" Steel pipe

DISTRIBUTION BOX, LEVEL None

TILE FIELD, DEPTH _____ FT. TRENCH WIDTH _____ FT.

GRAVEL DEPTH _____ IN. TOTAL LENGTH _____ FT.

NUMBER OF TRENCHES _____ TOTAL BOTTOM AREA _____

SEEPAGE PITS, INSIDE DIAMETER 12 1/2' FT. DEPTH BELOW INLET 10' 9"

ABSORBENT AREA OK. SQ. FT.

REMARKS Very good soil.

A10255 5/65 2 & 6 min. at 5 1/4 ft. at S.W.
 reserve test just behind S.T. 2 & 3 min. at 5 1/4 ft.

J.H.K.


DATE SYSTEM APPROVED 10-27-65

INSPECTOR J. H. K.

Property known as: LOT 82

HOLIDAY HILLS
SECTION 6 P.B. 9 699
5TH ELECTION DISTRICT
HOWARD COUNTY, MD.

THIS PLAT CAN NOT BE USED TO ESTABLISH PROPERTY
LINES OR CORNERS.

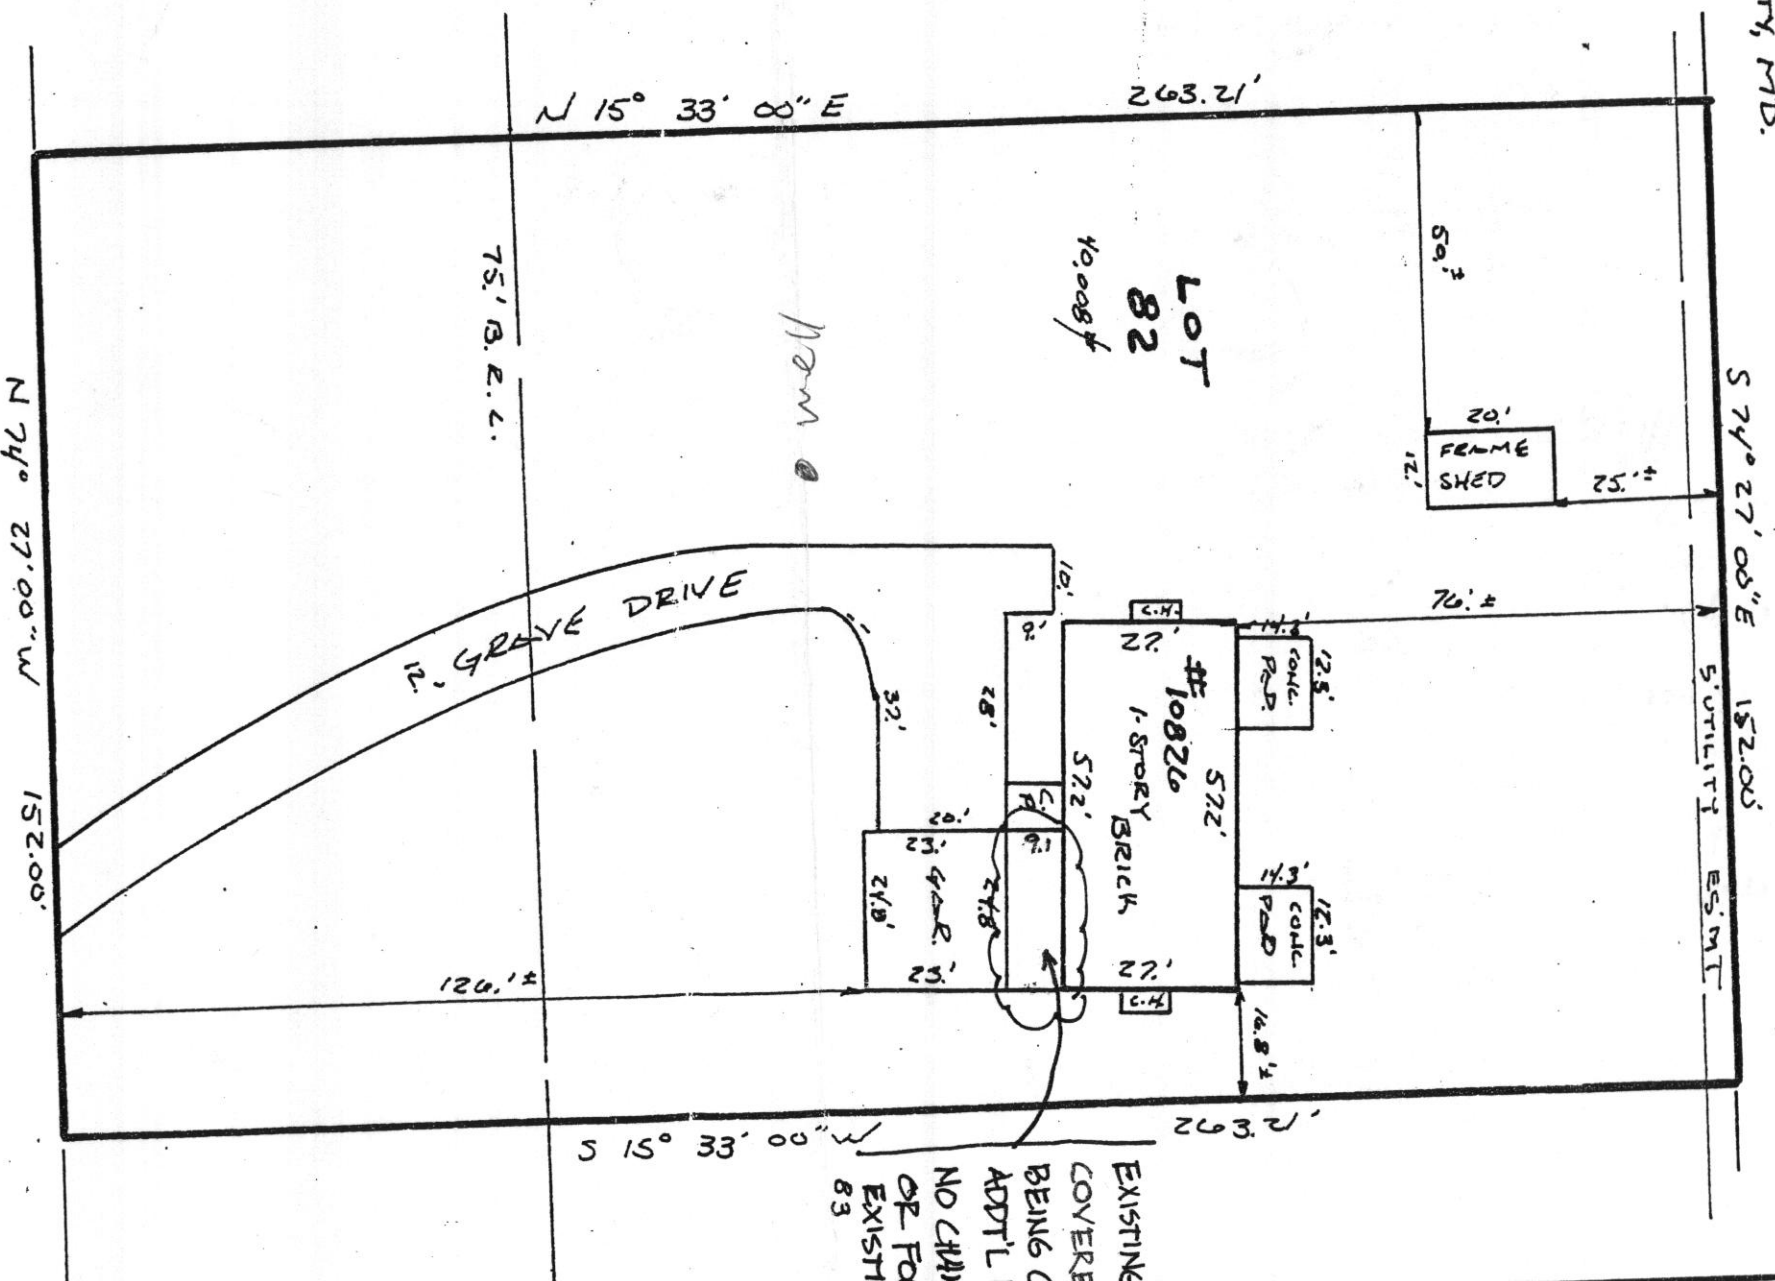

LOCATION SURVEY PLAT
SUBJECT PROPERTY NOT LOCATED IN A FLOOD PLAIN AREA UNLESS OTHERWISE NOTED

VISTA 50' x 14' ROAD

CERTIFICATION

SEAL

SCALE 1"=30' DATE 7-27-1989

This is to certify that I have surveyed
the property known as: 10826 VISTA ROAD

for the purpose of locating the im-
provements thereon, and the improvements
are located as shown.



LAND DESIGN ENGINEERING, INC.
SUITE 100
9030 RED BRANCH ROAD
COLUMBIA, MARYLAND 21045

WALTER PARK
REG. L.S. #55339

730-9060
730-0810

TRP 10020042

COHEN