

5/17/02
10:00

PUB. SEWER STATUS VERIFIED BY N/A mllb
for Jean Reed

ISSUE DATE: 4/22/02

APPROVAL DATE: 5/17/02

**PERMIT
INDEXED**

P 516942
A 516942
REPAIR

**ON-SITE SEWAGE DISPOSAL SYSTEM
HOWARD COUNTY HEALTH DEPARTMENT
BUREAU OF ENVIRONMENTAL HEALTH**

05-366356

South Carroll Backhoe IS PERMITTED TO INSTALL ALTER

ADDRESS: 4410 Salem Bottom Road, 21157 PHONE NUMBER: 410-875-4197

SUBDIVISION: Criswood Manor LOT NUMBER: 11

ADDRESS: 5425 Trotter Road PROPERTY OWNER: Sekira

SEPTIC TANK CAPACITY (GALLONS): 1000

PUMP CHAMBER CAPACITY (GALLONS): NA

NUMBER OF BEDROOMS: 2 existing (adding 1 bedroom) = 3

SQUARE FEET PER BEDROOM: 180

LINEAR FEET OF TRENCH REQUIRED: 135 (2-70' trenches)


TRENCHES:	Trench to be 3 feet wide. Inlet 4 feet below original grade. Bottom maximum depth 8 feet below original grade. Effective area begins at 5'6" feet below original grade. 4 feet of stone below distribution pipe.
LOCATION:	In support of building permit. Call for inspection when ground is opened.
PURPOSE:	

PLANS APPROVED: SRK / JB DATE: 4/22/02

- NOTE: PERMIT VOID AFTER 2 YEARS
- NOTE: CONTRACTOR RESPONSIBLE FOR SCHEDULING A PRE-CONSTRUCTION INSPECTION FOR ALL INSTALLATIONS
- NOTE: WATERTIGHT SEPTIC TANKS REQUIRED
- NOTE: ALL PARTS OF SEPTIC SYSTEM SHALL BE 100 FEET FROM ANY WATER WELL
- NOTE: MANHOLE RISERS REQUIRED ON ALL SEPTIC TANKS AND PUMP CHAMBERS

**NEITHER THE HOWARD COUNTY COUNCIL NOR THE HEALTH DEPARTMENT IS
RESPONSIBLE FOR THE SUCCESSFUL OPERATION OF ANY SYSTEM
PERMITTEE RESPONSIBLE FOR OBTAINING FINAL APPROVAL ON THIS PERMIT
CALL 410-313-2640 FOR INSPECTION OF SEPTIC SYSTEM**

AS16942

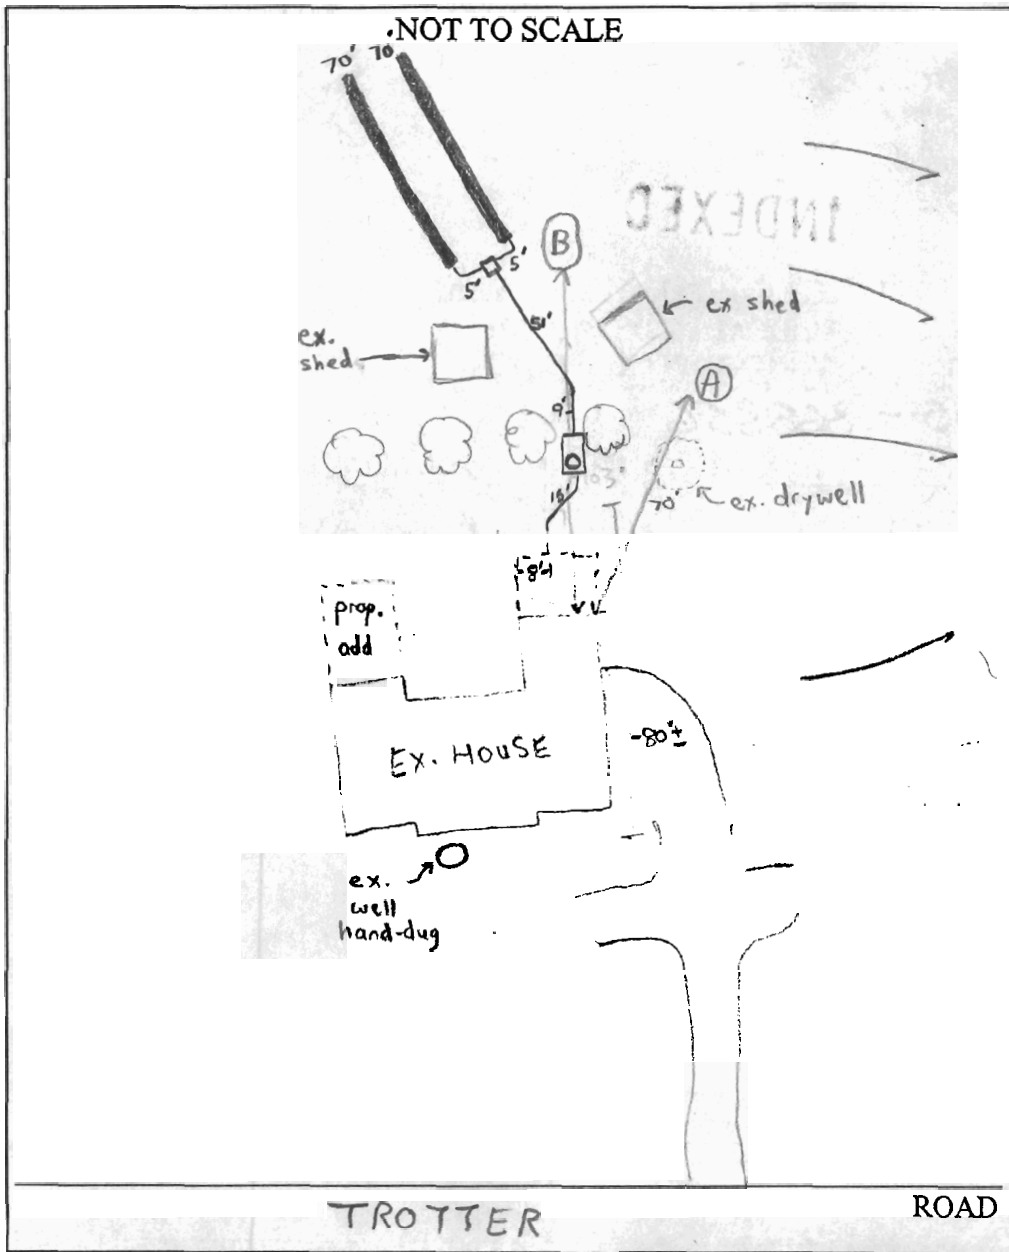

TRENCH/DRAINFIELD DATA		
WIDTH	INLET	BOTTOM
3'	4'	8'
NUMBER OF TRENCHES		2
TOTAL LENGTH		140'
ABSORPTION AREA		560 ft ²
DISTRIBUTION BOX LEVEL		✓
DISTRIBUTION BOX BAFFLE		✓
DISTRIBUTION BOX PORT		NA

SEPTIC TANK DATA	
SEPTIC TANK 1 LEVEL	✓
CAPACITY	1000 GAL
SEAM LOC	10p
TANK LID DEPTH	
BAFFLES	✓
BAFFLE FILTER	NA
MANHOLE LOC	Front
6" PORT LOC	NA
WATERTIGHT TEST	NA
SEPTIC TANK 2 LEVEL	NA
CAPACITY	NA GAL
SEAM LOC	NA
TANK LID DEPTH	NA
BAFFLES	NA
BAFFLE FILTER	NA
MANHOLE LOC	NA
6" PORT LOC	NA
WATERTIGHT TEST	NA

PRE-CONSTRUCTION 5/17/02 - EX. TANK TO BE REPL. W/ 1000 GALLON TOP SEAM & MOVED TO BE 10' FROM NEW ADDITION, 75-80' FROM EX. HAND DUG WELL, PERC HOLE DUG IN LOCATION (A) (HOLE ABANDONED DUE TO RESULTS), HOLE DUG IN LOCATION (B) SOILS MORE SUITABLE - INSTALL AS DISCUSSED - (SRV/JB)

INSTALLATION

5/17/02 - OK TO COVER ALL WORK, EXISTING S.T. COLLAPSED & FILLED, ALONG W/ EX. DRYWELL

FINAL INSPECTOR Steven R. Krieg DATE OF APPROVAL 5/17/02

