

DATE PERMITTED: [ ] [ ] [ ] [ ] [ ] [ ] DATE WELL COMPLETED: **08-27-84** DATE OF TEST: [ ] [ ] [ ] [ ] [ ] [ ] FROM PERMIT TO DRILL WELL: **10-01-84**

OWNER: **CAMPBELL ANTHONY** STREET OR RFD: **KONDORUP DRIVE** TOWN: **FULTON** SUBDIVISION: **BEAUFORT PARK** SECTION: **45** LOT: **13**

**WELL LOG**  
Not required for driven wells

STATE: THE KIND OF FORMATIONS PENETRATED, THEIR COLOR, DEPTH, THICKNESS AND IF WATER BEARING

DESCRIPTION (Use additional sheets if needed)	FEET		Check if water bearing
	FROM	TO	
Top So. L	0	2	
Sandy	2	11	
Sand Stone	11	25	
Micka	25	30	
Sand Stone	30	40	✓
Micka	40	120	

8-1-84  
20' case  
18' open  
5' gravel pack  
SS  
5gpm 3hr. per test  
NO<sub>3</sub> 401  
Chloride 150

**WELLING RECORD**

WELL HAS BEEN GROUTED (Circle Appropriate Box) **Y** **N**  
TYPE OF GROUTING MATERIAL  
CEMENT **CB** BENTONITE CLAY **BC**  
NO. OF BAGS: **5** NO. OF POUNDS: **500**  
GALLONS OF WATER: **30**  
DEPTH OF GROUT SEAL (to nearest foot)  
from **0** ft. to **12** ft. (enter 0 ft from surface)

**CASING RECORD**  
casing types insert appropriate code below  
**ST** **CO** **PL** **OT**  
STEEL CONCRETE PLASTIC OTHER

MAIN CASING TYPF  
Nominal diameter top (main) casing (nearest inch) **2 1/2**  
Total depth of main casing (nearest foot) **20**

OTHER CASING (if used)  
EACH CASING diameter inch depth (feet) from to

**SCREEN RECORD**  
screen type or open hole insert appropriate code below  
**ST** **BR** **HO** **PL** **OT**  
STEEL BRASS BRONZE OPEN HOLE PLASTIC OTHER

**DEPTH (nearest feet)**  
EACH SCREEN  
1 **HO** **15** **120**  
2  
3  
SLOT SIZE: **2**  
DIAMETER OF SCREEN (NEAREST INCH)

GRAVEL PACK: **from to**  
IF WELL DRILLED WAS FLOWING WELL INSERT **F** IN BOX 60  
OEP USE ONLY (NOT TO BE FILLED IN BY DRILLER)

TELESCOPE CASING: **T** **LOG INDICATOR** **OTHER DATA**


**OPERATING DATA**

HOURS PUMPED (nearest hour) **3**  
PUMPING RATE (gal. per min. to nearest gal.) **5**  
METHOD USED TO MEASURE PUMPING RATE: **Bucket**  
WATER LEVEL (distance from land surface) BEFORE PUMPING: **312**  
WHEN PUMPING: **30**  
TYPE OF PUMP USED (for test): **A** **P** **T** **C** **R** **O** **J** **S**  
Air piston turbine centrifugal rotary other (describe below) jet submersible

**PUMP INSTALLED**

DRILLER WILL INSTALL PUMP YES **NO** (CIRCLE)  
IF DRILLER INSTALLS PUMP, THIS SECTION MUST BE COMPLETED FOR ALL WELLS EXCEPT HOME USE  
TYPE OF PUMP INSTALLED PLACE (A,C,J,P,R,S,T,O) IN BOX - SEE ABOVE  
CAPACITY: GALLONS PER MINUTE (to nearest gallon) **5**  
PUMP HORSE POWER **1/2**  
PUMP COLUMN LENGTH (nearest ft.) **12**  
CASING HEIGHT (circle appropriate box and enter casing height) **+** above **-** below  
LAND SURFACE (nearest foot) **312**

LOCATION OF WELL ON LOT SHOW PERMANENT STRUCTURE SUCH AS BUILDING, SEPTIC TANKS, AND/OR LANDMARKS AND INDICATE NOT LESS THAN TWO DISTANCES (MEASUREMENTS TO WELL)

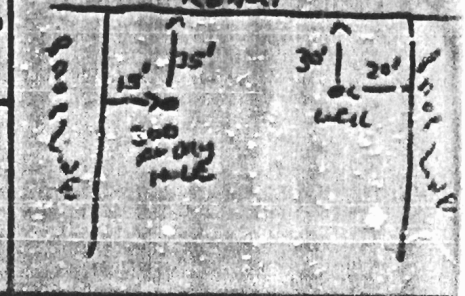


CIRCLE APPROPRIATE LETTER  
**A** A WELL WAS ABANDONED AND SEALED WHEN THIS WELL WAS COMPLETED  
**E** ELECTRIC LOG OBTAINED  
**P** TEST WELL CONVERTED TO PRODUCTION WELL

I HEREBY CERTIFY THAT THIS WELL HAS BEEN CONSTRUCTED IN ACCORDANCE WITH COMAR 10.17.13 "WELL CONSTRUCTION" AND IN CONFORMANCE WITH ALL CONDITIONS STATED IN THE ABOVE CAPTIONED PERMIT, AND THAT THE INFORMATION PRESENTED HEREIN IS ACCURATE AND COMPLETE TO THE BEST OF MY KNOWLEDGE

DRILLERS IDENT. NO. **223**  
*Ralph Mayer*

DRILLERS SIGNATURE (MUST MATCH SIGNATURE ON APPLICATION)  
*Ralph E. Mayer*

SITE SUPERVISOR (sign. of driller or person responsible for sitework if different from permittee)

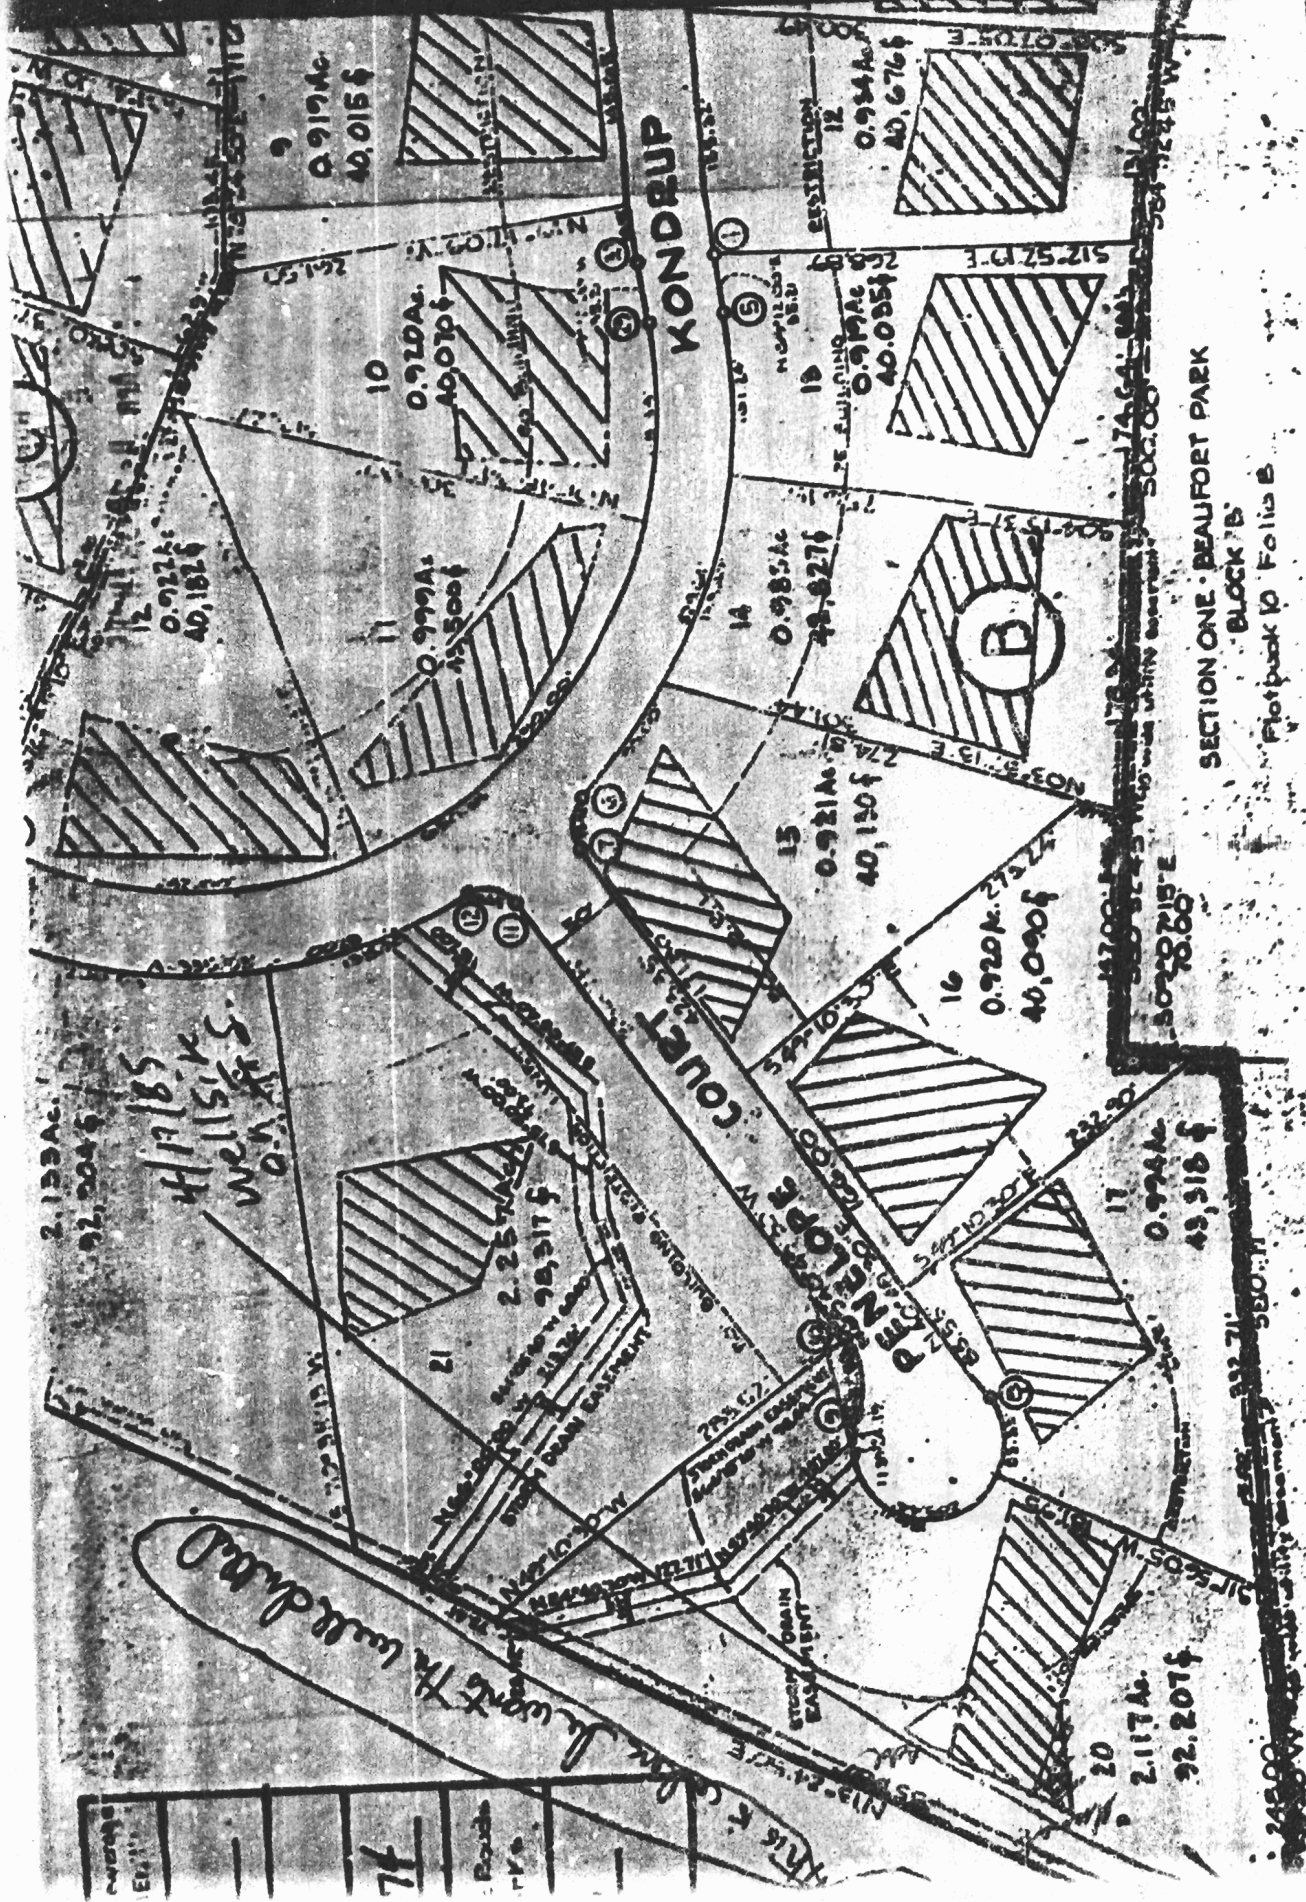

SECTION ONE - BEAUFORT PARK  
BLOCK B  
Plotbook to Folio B

SECTION FOUR  
AREA ONE

ADJ LOTS