

A517427A

# APPLICATION

A 18030

## SEWAGE DISPOSAL TESTING

P \_\_\_\_\_

STATE OF MARYLAND - DEPARTMENT OF HEALTH AND MENTAL HYGIENE

HOWARD COUNTY HEALTH DEPARTMENT  
ENVIRONMENTAL HEALTH SERVICES  
P. O. BOX 476, ELLICOTT CITY, MARYLAND 21043  
TELEPHONE: 468-8000, EXT. 396

DISTRICT 5th

DATE 3/14/73

TO: THE COUNTY HEALTH OFFICER  
ELLICOTT CITY, MARYLAND

I, HEREBY, APPLY FOR THE NECESSARY TEST IN ORDER TO CONSTRUCT (OR RECONSTRUCT) A SEWAGE DISPOSAL SYSTEM.

PROPERTY OWNER C. P. Musgrove (Contract Purchaser - Richard Tucker)  
Downvard St., Gaithersburg, Md.  
ADDRESS \_\_\_\_\_ PHONE 253-3208

### PROPERTY LOCATION:

SUBDIVISION (Chestnut Hills) LOT NO. Parcel F  
ROAD AND DESCRIPTION Long Corner Road

SIZE OF LOT 5.036 acres TYPE BLDG. 4 bedrooms  
NUMBER OF BEDROOMS

IF NOT SINGLE RESIDENCE DESCRIBE \_\_\_\_\_

THE SYSTEM INSTALLED UNDER THIS APPLICATION IS ACCEPTABLE ONLY UNTIL PUBLIC FACILITIES BECOME AVAILABLE.

SIGNATURE OF APPLICANT Allen E. Burdette


APPROVED BY \_\_\_\_\_ FOR \_\_\_\_\_ DATE \_\_\_\_\_  
(KIND OF SYSTEM)

REJECTED BY \_\_\_\_\_ FOR \_\_\_\_\_ DATE \_\_\_\_\_  
(KIND OF SYSTEM)

HOLD PENDING FURTHER TESTS \_\_\_\_\_ DATE \_\_\_\_\_

REASONS FOR REJECTION OR HOLDING \_\_\_\_\_

# THIS IS NOT A PERMIT

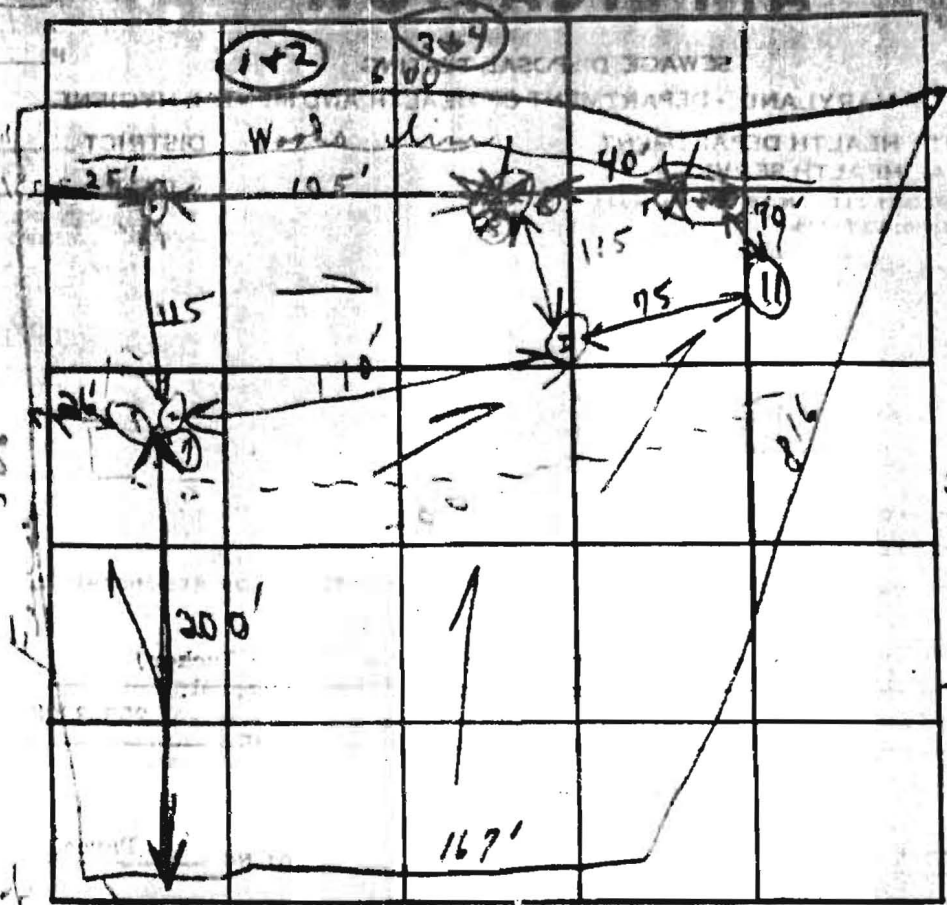

5/3/73

Pyrite Street

1	4'	BSY 409
2	12'	BSY 409
3	4'	
4	12'	

DATE	TEST NO.	DEPTH	PRE-WET		TEST - 1" DROP		TIME	
			START	STOP	START	STOP		
5/1/73	1	3' 5"	10:10	10:14	Pulled Per	Lower	Shelf	
	2	1 1/2'	10:11	10:15	10:15	10:21	6 min	
	3	9'	(Similar to 1+2)					
	4	3 1/2'	10:16	10:25	10:25	Pulled Per	} lower shelf 24 min	
	5	12'	10:16	10:20	10:20	10:30		10 min
	6	10 1/2'	(Similar to 4+5)					
	7	4'	10:57	11:05	11:05	11:23		15 min
	8	5 1/2'	10:55	No per	11:15			
	9	5 1/2' S	11:31	"	"			
	2	10 1/2' 0	12:12	Perched layer of water				

REMARKS: Hold Kan out of time - 11:30 - 12:00 (page 1+2)

TYPE OF SOIL: Clay heavy 5'-6'

TESTED BY: [Signature]

ALSO PRESENT: [Blank]