

370
60
210.00

APPROVED

WALK-THRU BUILDING PERMIT


BP# *Bonded* A# 17698

APP. SAN *Facetman* DATE: 6/1/05
DESC. OF WORK: *inground pool "AS IS" or "As Built"*

PRIVATE WELL
& SEPTIC


NOTE: A VACUUM BREAKER
WILL BE INSTALLED
ON JOB AS PER
CODE.

SETBACKS:
REAR PL. 10'
SIDE PL. 10'
HOUSE 10'
SEPTIC 20'
WELL 10'

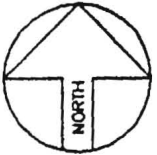

TRIADELPHIA ROAD

FOLLY QUARTER ROAD

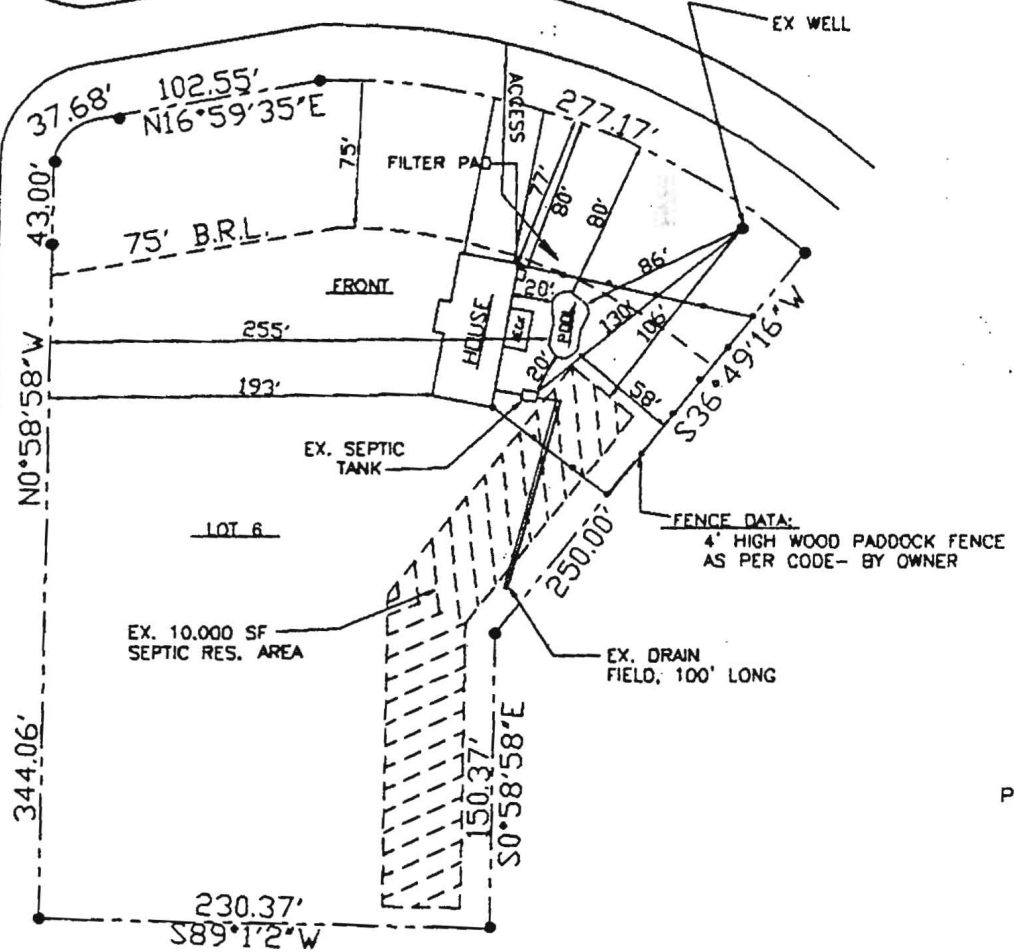

FENCE DATA:
4' HIGH WOOD Paddock FENCE
AS PER CODE- BY OWNER


460 SQ.FT. BRUSHED
FINISH CONCRETE
DECK- BY MPM

SITE PLAN
SCALE: 1" = 50'

13411 TRIADELPHIA ROAD
HOWARD COUNTY, MD. 21042

THE CORNERS

LOT 6, LIBER 1328, FOLIO 491
PLAT BOOK 30/ 40

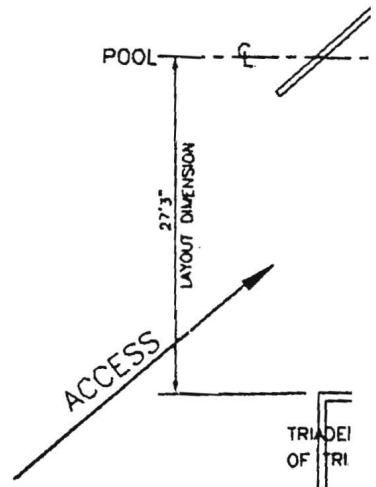

Both Customer and Salesman agree that this drawing, access, elevation & location of all equipment and appurtenances are in agreement. Any changes from this drawing must be

DIRECTIONS: RTE. 108 WEST TO HOMEWOOD RD., RD. LATER BECOMES FOLLY QUARTER RD., CONT. 7 MILES TO TRIADELPHIA RD., TURN RIGHT & FOLLOW TO SITE AT CORNER OF TRIADELPHIA & FOLLY QUARTER RDS.

Cross Section POOL E1
NON- ON WEDGE