


Carolyn "Nicky" Ratliff
778 W. Watersville Rd.
Mount Airy, MD 21771

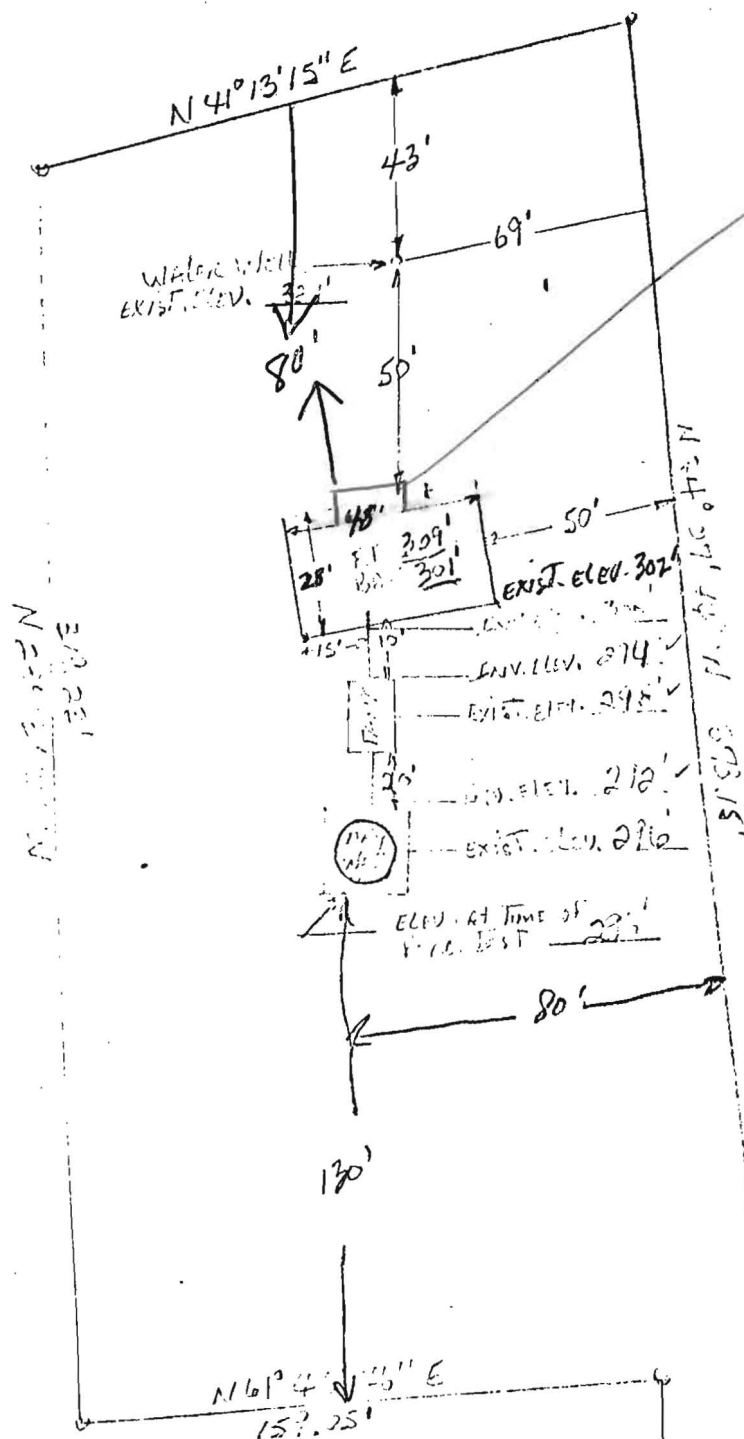

N
↑
Proposed
Cement Ratio
13' x 18'
w/ 30" Rebar

appears ok 5/21/76
C.B.S.

Scale 1" = 50'

Page 10. The above mentioned elevations
are actual + correct for this point.
Signed: () Ernest B. Byrnes

Road

Project

Project Number

Date

Page

Subject

Get sliders in front starting 18" up or 50 to give more view out from Dining room?

