


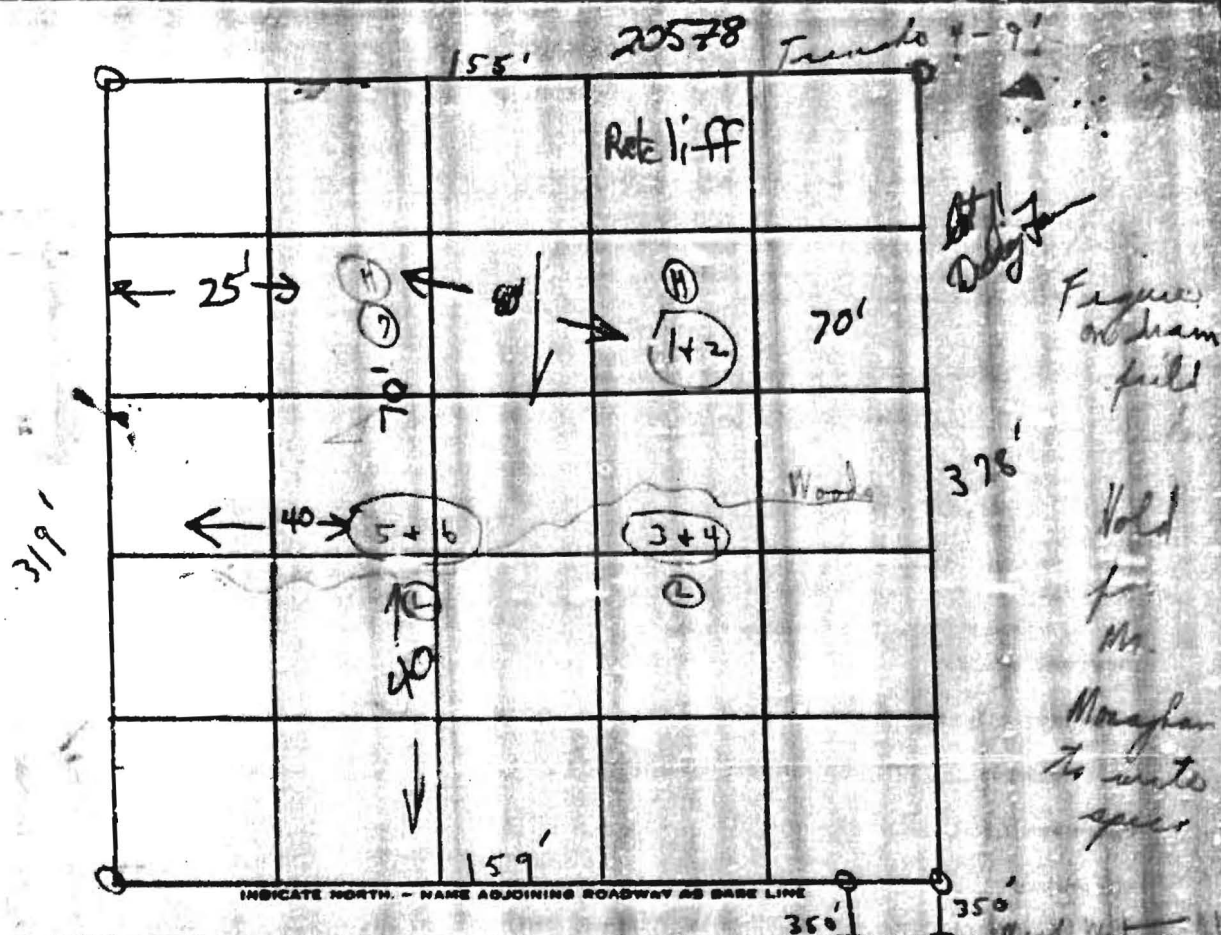

DATE	TEST NO.	DEPTH	PRE-WET		TEST - 1" DROP		TIME
			START	STOP	START	STOP	
7/10/74	1	4' s	1:33	1:45	1:45	2:12	27m
	⑩ 2	12' d	1:34	1:36	1:36	1:41	5m
	3	5' s	2:34	2:34	2:34	2:34	0m
	④ 4	12' d	2:30	2:32	2:32	2:36	4m
	5	5' s	2:02	2:03	2:08	2:17	9m
	⑥ 6	12' d	2:18	2:20	2:20	2:24	4m
	⑦ 7	(10 1/2' Visual remainder to 1+2)					
	→ 8'	6'	2:37	2:45	2:45	3:05	20m

REMARKS

TYPE OF SOIL

TESTED BY

ALSO PRESENT

Clear & empty (Antefix holes)

Clear & empty

C. S. S.

H. V. K. + Co