

4-12-75
2nd 10.00-47.
Preliminary

APPLICATION

SEWAGE DISPOSAL TESTING

STATE OF MARYLAND · DEPARTMENT OF HEALTH AND MENTAL HYGIENE

HOWARD COUNTY HEALTH DEPARTMENT
ENVIRONMENTAL HEALTH SERVICES

P. O. BOX 478, ELLICOTT CITY, MARYLAND 21043
TELEPHONE: 444-9999, EXT. 334

A 21364

P

DISTRICT 3

DATE 4/18/75

TO: THE COUNTY HEALTH OFFICER
ELLICOTT CITY, MARYLAND

I, HEREBY, APPLY FOR THE NECESSARY TEST IN ORDER TO CONSTRUCT (OR RECONSTRUCT) A SEWAGE DISPOSAL SYSTEM.

PROPERTY OWNER John Mikalasho & A. A. Krombholz Bob Johnson

ADDRESS 7205 Dudley Road, Glenview, Md. 21093 PHONE WDC 765-2930
(Westinghouse)

PROPERTY LOCATION:

SUBDIVISION Rosemary Estates LOT NO. 16

ROAD AND DESCRIPTION 13080 Williamfield Drive

SIZE OF LOT 5.441 acres TYPE BLDG. 1 ST 4

IF NOT SINGLE RESIDENCE DESCRIBE NUMBER OF BEDROOMS
(Single Family, Duplex, etc.)

THE SYSTEM INSTALLED UNDER THIS APPLICATION IS ACCEPTABLE ONLY UNTIL PUBLIC FACILITIES BECOME AVAILABLE.

SIGNATURE OF APPLICANT /s/ John Mikalasho

APPROVED BY FOR DATE
(KIND OF SYSTEM)


REJECTED BY FOR DATE
(KIND OF SYSTEM)

HOLD PENDING FURTHER TESTS DATE

REASONS FOR REJECTION OR HOLDING 5/20/75 Hold for certification of Robert F. G.

ENGL. PERMIT SIGNED
AND RETURNED 3-7-87
BP 33956

THIS IS NOT A PERMIT

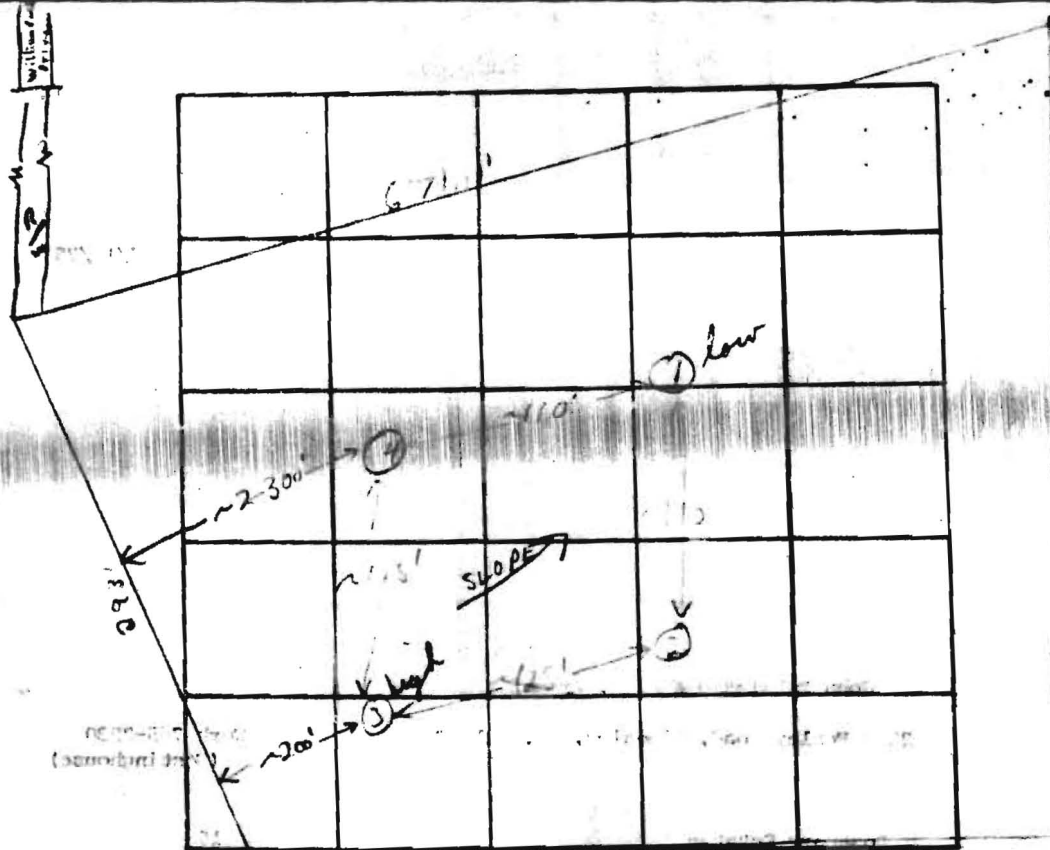

INDICATE NORTH - NAME ADJOINING ROADWAY AS BASE LINE

DATE	TEST NO.	DEPTH	PRE-WET		TEST - 1" DROP		TIME
			START	STOP	START	STOP	
5/22/79	1 low	5'	2:20	2:33	2:33	2:57	24min
	1A	12'	2:20	2:25	2:25	2:32	7min
	2	6'	2:33	2:35	2:35	2:39	4min
	2A	13'	2:35	2:39	2:39	2:48	9min
	3 high	5'	2:45	2:48	2:48	2:53	5min
	3A	12'	2:45	2:48	2:48	2:53	5min
	4	11 1/2'	Vicinity top of clay, silty loam below				

9 min. avg.
130.5 sec / 12.2 min
11.5 min

REMARKS

Certify all holes in soil lot

TYPE OF SOIL

Silty loam below top of clay soil

TESTED BY

F.S. H.T.

ALSO PRESENT: