

# PERMIT

SEWAGE DISPOSAL SYSTEM

MARYLAND STATE DEPARTMENT OF HEALTH

HOWARD COUNTY  
BUREAU OF ENVIRONMENTAL HEALTH  
60-202

ELICOTT CITY

DISTRICT 402

## INDEX

DATE 4/20/73

NO. OF PERMITS TO INSTALL 2 PERMITS TO INSTALL

ADDRESS 2400 Road, Mountain, Maryland

SECTION 2300 House No. LOT

PROPERTY OWNER

ADDRESS 2400 Road, Mountain, Maryland 20804

IF GARBAGE CHUTES IS USED REDUCE SEPTIC TANK CAPACITY BY 50% AND ABSORPTION AREA BY 50%.

GARBAGE CHUTES YES NO

SEPTIC TANK CAPACITY GALLONS NUMBER OF BEDROOMS

INSTALLER - I, [Name], do hereby certify that I am a duly licensed professional engineer and have prepared the plans for the installation of the above described sewage disposal system. I have also verified the location of the sewer line and the location of the absorption area. The system is designed to serve a house with two bedrooms and a bathroom. The absorption area is located in the rear yard of the property and is 100 feet in length and 10 feet in width. The system is designed to have a capacity of 1000 gallons per day. I have also provided for the installation of a septic tank with a capacity of 1000 gallons. The system is designed to be installed in accordance with the requirements of the Maryland State Department of Health. (5) Provide a "clean" absorption area and all septic tank and absorption area shall be installed in accordance with the requirements of the Maryland State Department of Health. (6) If a Garbage Chute is used, the absorption area shall be reduced by 50% and the septic tank capacity shall be reduced by 50%.

PLANS APPROVED BY [Signature] DATE

COVER NO WORK UNTIL INSPECTED AND APPROVED

OWNER THE HOWARD COUNTY BOARD AND THE HEALTH DEPARTMENT IS RESPONSIBLE FOR THE SUCCESSFUL OPERATION OF ANY SYSTEM.

NOTE IF TRENCH IS USED FILL PER INSPECTOR BEFORE AND AFTER PLACING GRADE IN TRENCH

NOTE NO SEW WELL SHALL BE LESS THAN 18 INCHES IN DIAMETER AND ABSORPTION TRENCHES SHALL BE 18 INCHES IN WIDTH

NOTE ALL PIPE FROM HOUSE TO SEPTIC TANK MUST BE CAST IRON OR SCHEDULE 40 STEEL PIPE


PERMIT VALID AFTER THREE YEARS

NOTE INSTALLER OF SEPTIC TANK AND SEW WELL STAND PIPES MUST BE 6 INCHES IN DIAMETER CAST IRON, COPPER OR TYPICALLY OF PVC OR ABS ACCEPTED IF TOP OF SEPTIC TANK IS DEEPER THAN 5 FEET MINIMUM VC SPACE REQUIRED.

**INSTALLER IS RESPONSIBLE FOR OBTAINING FINAL APPROVAL ON THIS PERMIT**

CALL 686-2330 FOR INSPECTION OF SEPTIC SYSTEMS.

60-3-1002

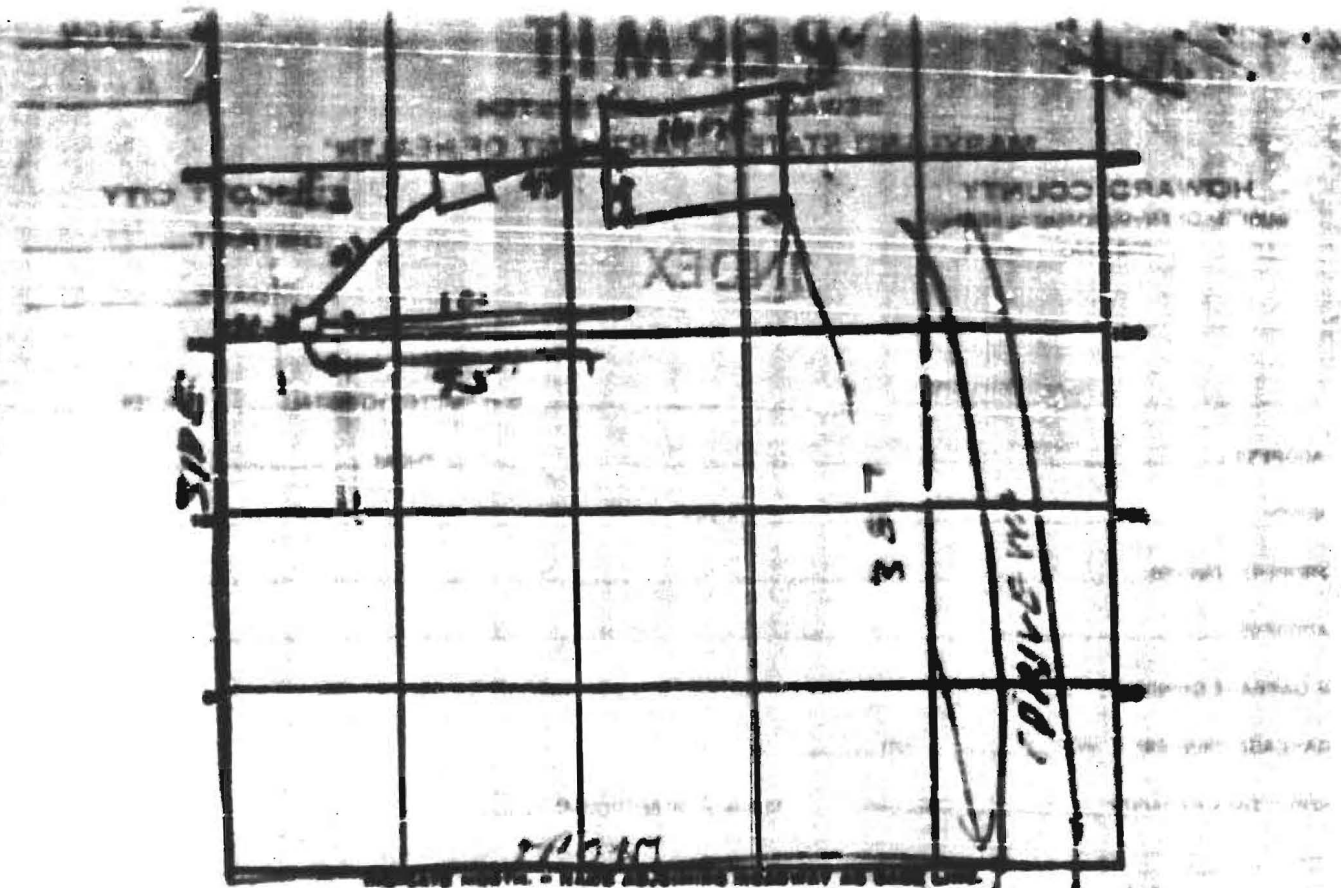

PERMIT CARD 1 TANK MANHOLE / TANK PIPE

OPTIC TANK LEVEL 1000 TAP ELEVATION OK / OK

DISTRIBUTION BOX LEVEL 3 FT BELOW GROUND

TILE FIELD, DEPTH 2 FT. TRENCH WIDTH 2 FT. 1.95

GRAVEL DEPTH 3 IN. TOTAL LENGTH 1.95 1.95  
5.85

NUMBER OF TRENCHES 2 TOTAL COVERED AREA 5.85

DEEPAGE PYS, INSIDE DIAMETER \_\_\_\_\_ FT. DEPTH BELOW GLEY \_\_\_\_\_ FT.

AGREEMENT AREA 5.85 SQ. FT.

REMARKS 9/2/83 - LOCATION OK OK TO COVER TANK

& PIPES ADD STONE TO DITCHES & CALL RTH

8/8/83 OK to cover all work. jr

INTEGRITY IS RESPONSIBLE FOR OBTAINING FINAL APPROVAL OF THE PERMIT

DATE SYSTEM APPROVED 8/8/83 SIGNATURE Stayer