

# APPLICATION

A 30988

PERCOLATION TESTING

A 51359

P \_\_\_\_\_

HOWARD COUNTY HEALTH DEPARTMENT  
BUREAU OF ENVIRONMENTAL HEALTH  
3525-H ELLICOTT MILLS DRIVE/ELLICOTT CITY, MARYLAND 21043  
TELEPHONE: 313-2840

DISTRICT \_\_\_\_\_

DATE 3/31/2000

TO: THE COUNTY HEALTH OFFICER  
ELLICOTT CITY, MARYLAND

I HEREBY APPLY FOR THE NECESSARY TEST PRIOR TO APPLICATION FOR PERMIT TO CONSTRUCT (OR RECONSTRUCT) A SEWAGE DISPOSAL SY:

PROPERTY OWNER Campbell Donald

ADDRESS 3000 RT 32 WEST FRIENDSHIP MD. 21794 PHONE \_\_\_\_\_

AGENT OR PROSPECTIVE BUYER Hailey Development L.C. (Rich Thomas, Peter Moore)

ADDRESS 3905 NATIONAL DRIVE, SUITE 410 PHONE (301) 476-7715  
BURTONSVILLE MD. 20866 301 775-2881 cell

PROPERTY LOCATION:

SUBDIVISION CAMPBELL PROPERTY LOT NO. 1

ROAD AND DESCRIPTION 3000 MD. RT 32

TAX MAP 15 PARCEL # 25

SIZE OF LOT 1 AC. TYPE BLDG. S.F.D.  
(SINGLE FAMILY DWELLING OR COMMERCIAL)

THE SYSTEM INSTALLED UNDER THIS APPLICATION IS ACCEPTABLE ONLY UNTIL PUBLIC FACILITIES BECOME AVAILABLE. I FULLY UNDERSTAND THE FEE CONNECTED WITH THE FILING OF THIS PERC TEST APPLICATION IS NON-REFUNDABLE UNDER ANY CIRCUMSTANCES. I ALSO AGREE TO COMPLY WITH ALL M.O.S.H.A. REQUIREMENTS IN TESTING THIS LOT.

Facharia W. Fisch (agent)  
(SIGNATURE OF APPLICANT)

APPROVED BY \_\_\_\_\_ FOR \_\_\_\_\_ DATE \_\_\_\_\_

DISAPPROVED BY \_\_\_\_\_ FOR \_\_\_\_\_ DATE \_\_\_\_\_

HOLD PENDING FURTHER TESTS \_\_\_\_\_

REASONS FOR REJECTION OR HOLDING \_\_\_\_\_

PERCOLATION TEST PLAT/PRELIMINARY PLAT - TITLE OR I.D. # \_\_\_\_\_ DATE \_\_\_\_\_

SITE DEVELOPMENT PLAN/FINAL PLAT - TITLE OR I.D. # \_\_\_\_\_ DATE \_\_\_\_\_

## THIS IS NOT A PERMIT

COUNTY #

SOIL PROFILE

0' 6028 29

bright red orange  
silt lm  
red sa  
silt lm  
tan orange  
fine sa  
lm  
10-15%  
frags

3-3 1/2

5 1/2

13

6026 25

brn tan  
silt lm  
red silty  
sa lm  
tan fine  
sa lm  
5-7%  
frags

3

5


6027 24

red orange  
tan  
silt lm  
orange tan  
gray  
sa lm  
gray mica  
sa  
lm  
15-20%  
frags


3

6

1 1/2

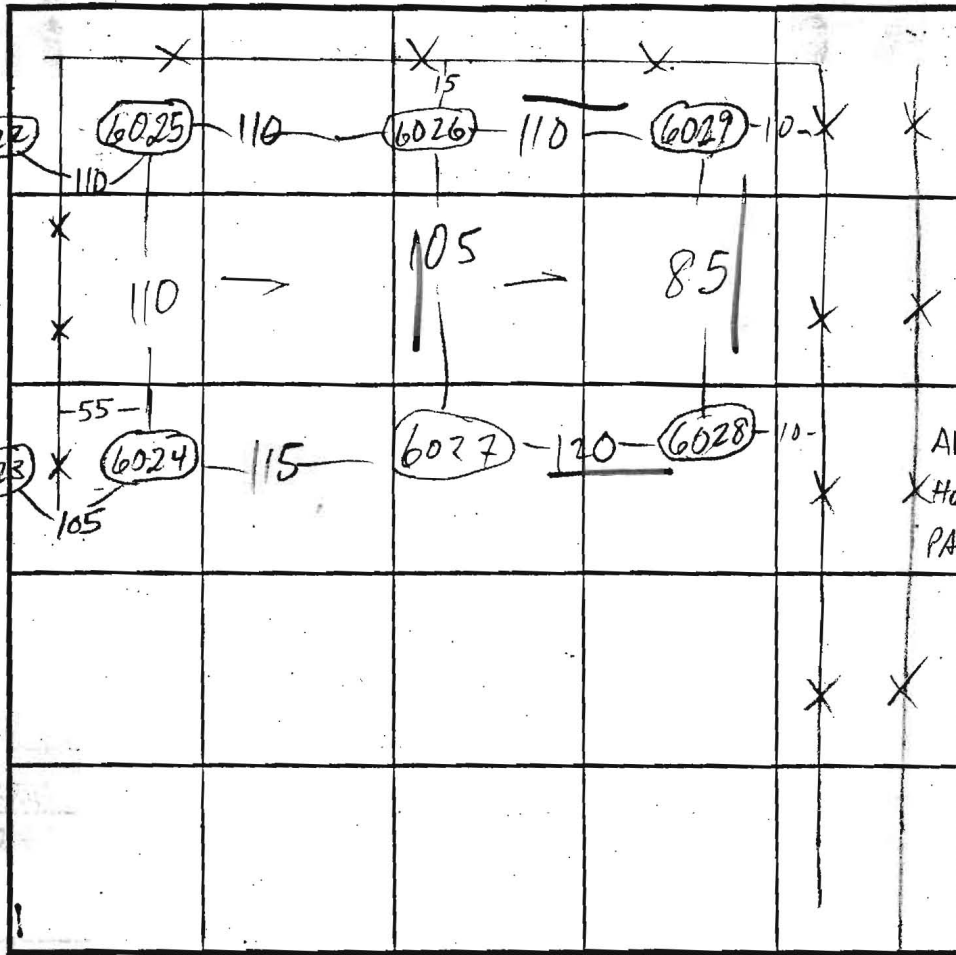

SOIL PROFILE

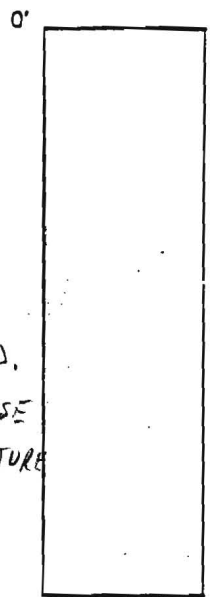

ADJ.  
HORSE  
PASTURE

INDICATE NORTH - NAME ADJOINING ROADWAY AS BASE LINE.

DATE	TEST NO.	DEPTH	PRE-WET		TEST - 1" DROP		TIME
			START	STOP	START	STOP	
6/16/00	6028 ✓	13	OK	see pro			
	6029 ✓	3' 8"	10:27	10:30	10:30	10:33	3
	✓	12 1/2	OK	see pro			
	6026 ✓	4'	10:30	10:31	10:31	10:33	2
	✓	12	OK	see pro			
	6025 ✓	4'	10:32	10:34	10:34	10:37	3
	✓	12' 9"	OK	see pro w/ some yel to bot.			
	6027 ✓	4	10:41	10:44	10:44	10:50	6
	M	7 1/2	10:39	10:40	10:40	10:42	2
	✓	11 1/2	OK	see pro			
	6024 ✓	13 1/2	OK	see pro			

REMARKS

TYPE OF SOIL

TESTED BY

M. Rifkin

ALSO PRESENT

OK Jr + crew

TRENCH DESIGN DATA: AVERAGE PERCOLATION TIME

3

TRENCH WIDTH

3

INLET DEPTH


3

MAXIMUM BOTTOM DEPTH

5

SQ. FT./BEDROOM

180

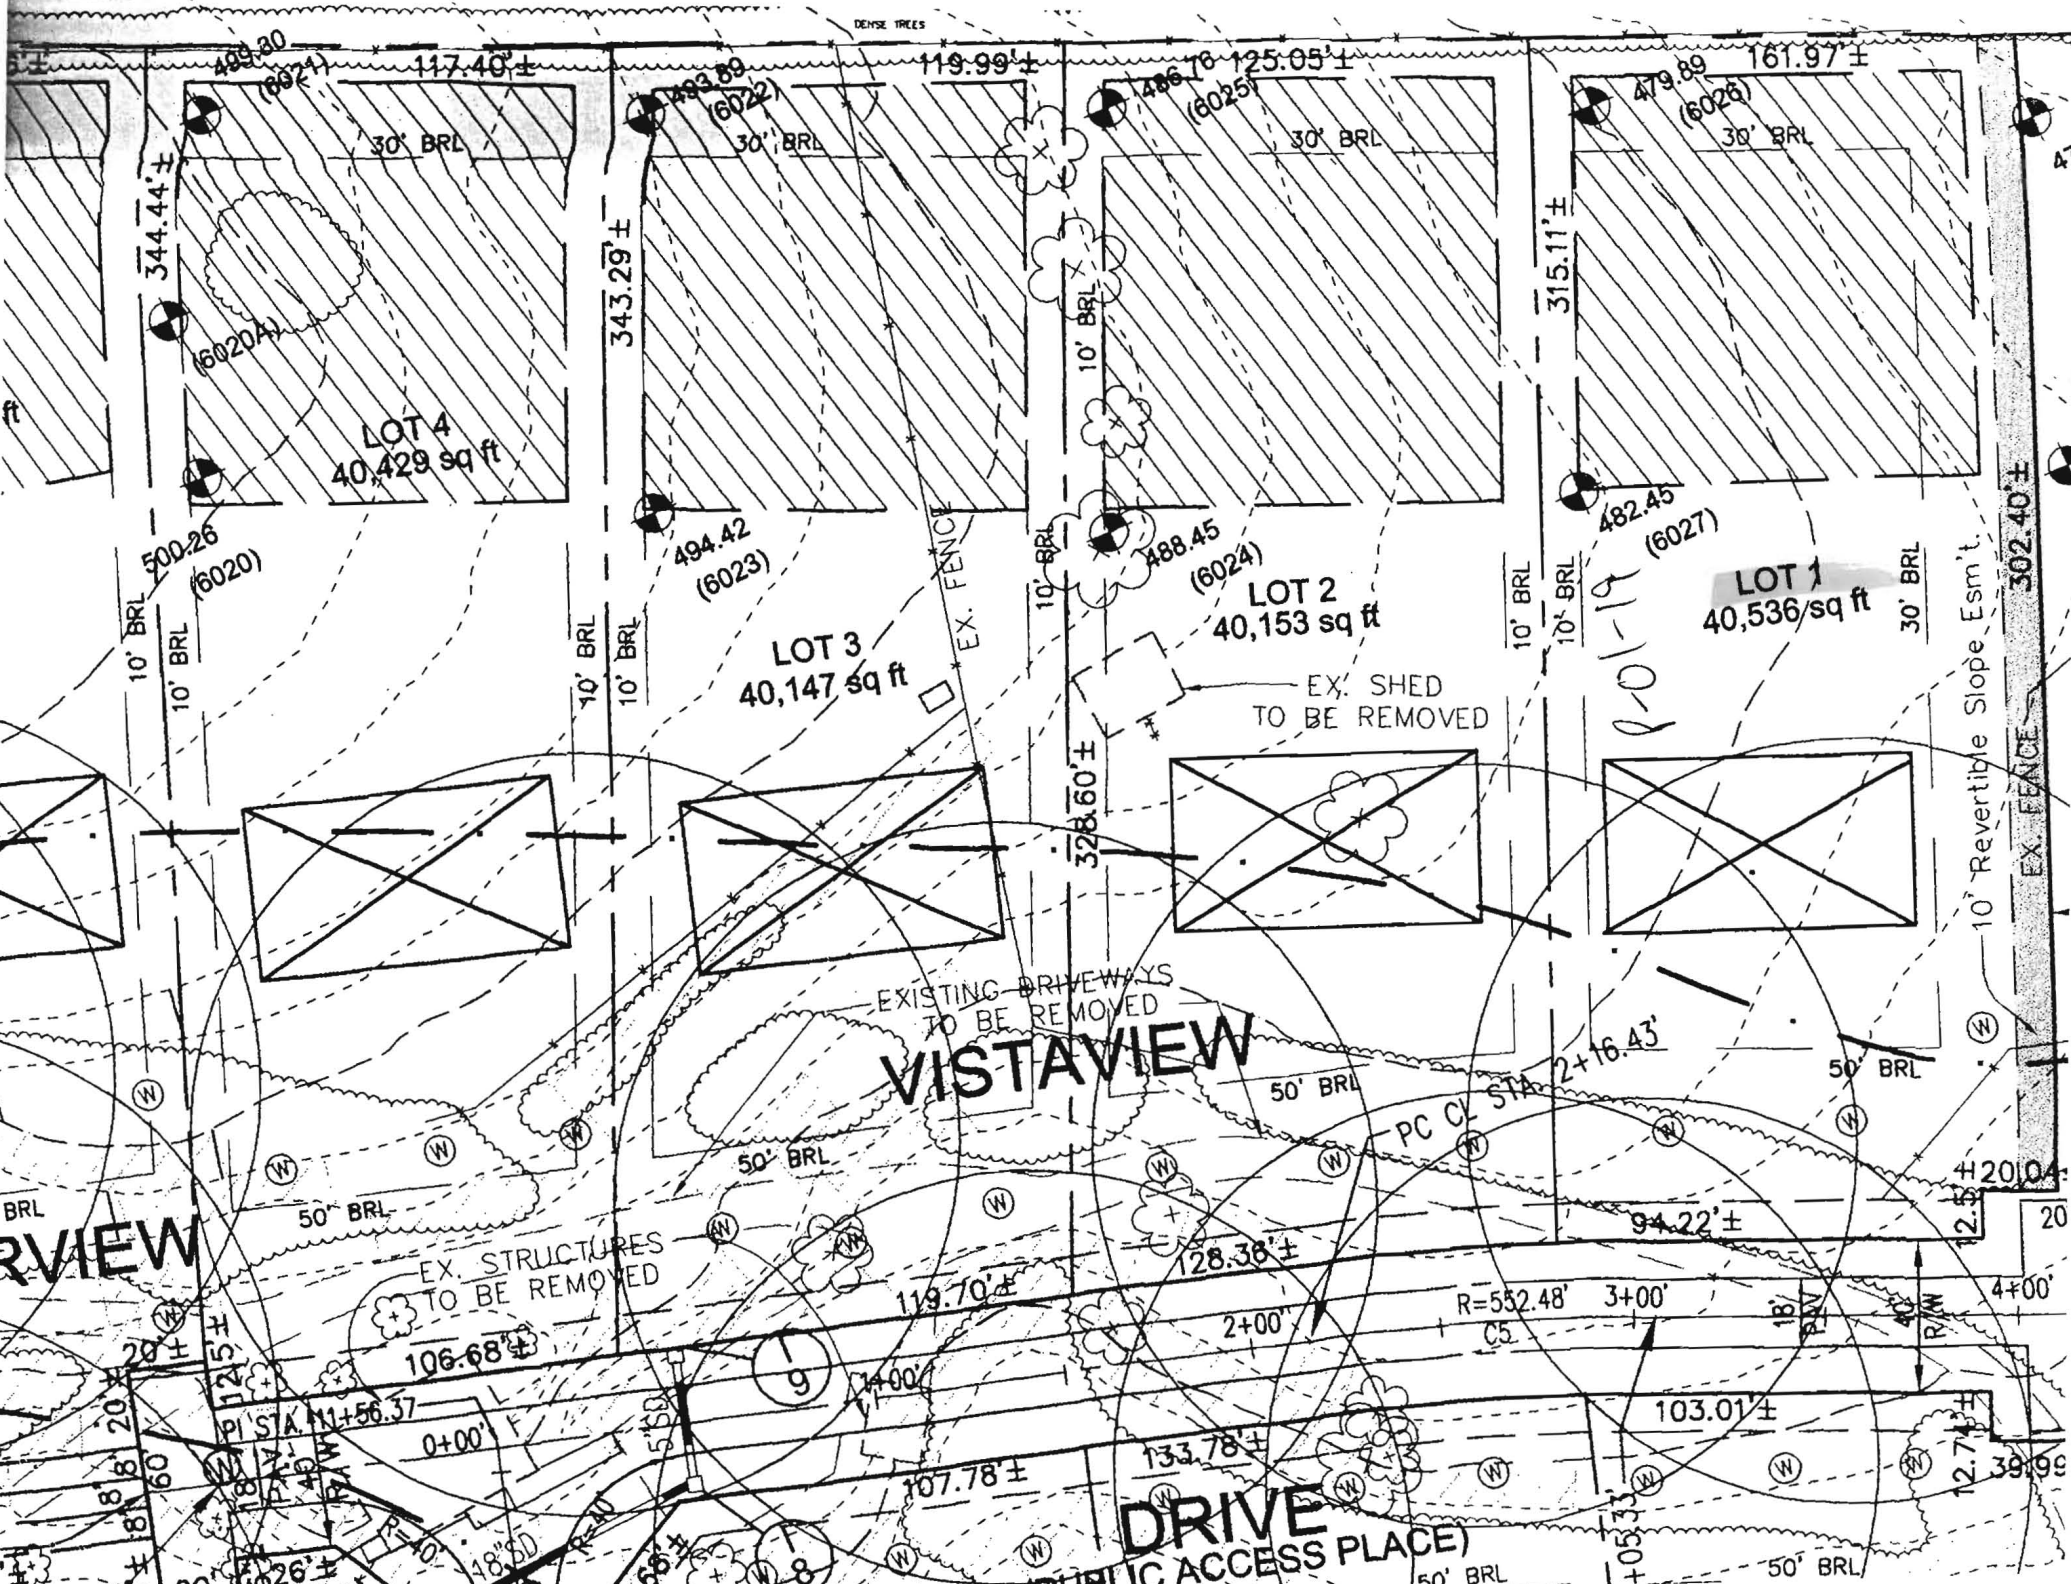

LOT 4  
40,429 sq ft

LOT 3  
40,147 sq ft

LOT 2  
40,153 sq ft

LOT 1  
40,536/sq ft

VISTAVIEW

DRIVE  
(PUBLIC ACCESS PLACE)

VIEW

DENSE TREES

EX. SHED  
TO BE REMOVED

EXISTING DRIVEWAYS  
TO BE REMOVED

EX. STRUCTURES  
TO BE REMOVED

2-01-19

10' Reversible Slope Esm't.

EX. FENCE

302.40'±

47

H 20.04'

12.5'

20

4+00'

12.7'

39.99'

103.01'±

128.36'±

119.70'±

107.78'±

133.78'±

94.22'±

R=552.48' 3+00'

C5

106.68'±

PI STA N1+56.37

125'±

20'±

8'±

8'±

20'±

20'±

BRL

50' BRL

50' BRL

500.26 (6020)

344.44'±

(6020A)

(6021)

(6022)

(6023)

(6268)

# VISTAVIEW DRIVE (Public Access Place)

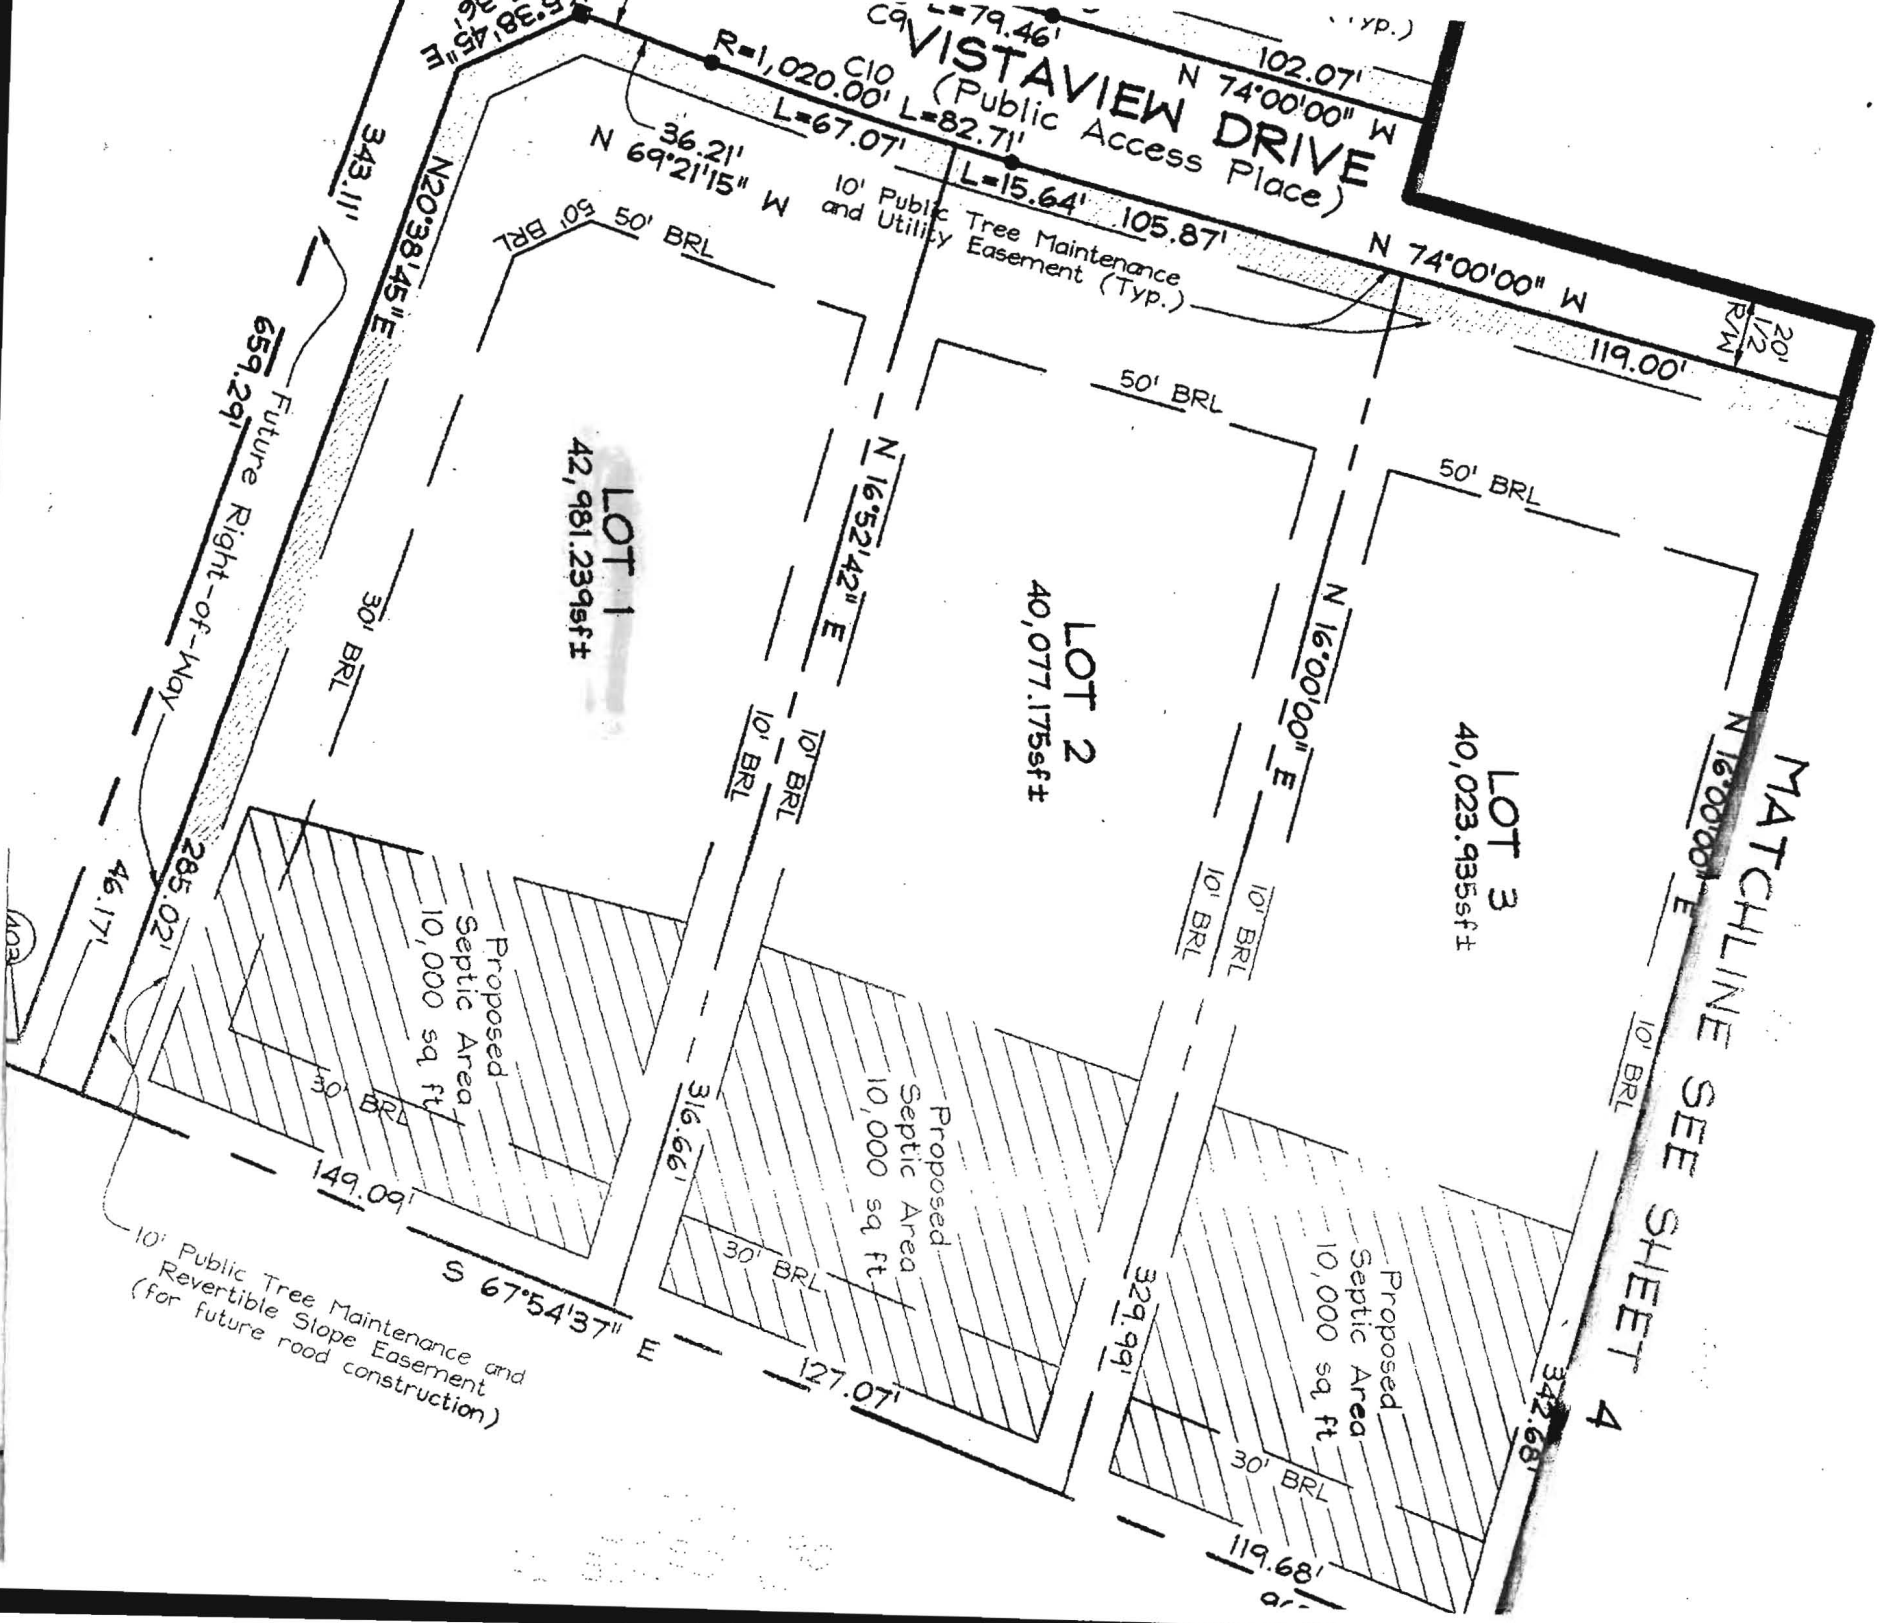

E-02-48

5/16/2018 8:33:02