

LAYOUT 1/2/03 11 AM INSP 4 _____

INSP 2 _____ INSP 5 _____

INSP 3 _____ INSP 6 _____

ISSUE DATE: 1/2/03APPROVAL DATE: 1/21/03**PERMIT
INDEXED**P 518502A REPAIR**ON-SITE SEWAGE DISPOSAL SYSTEM
HOWARD COUNTY HEALTH DEPARTMENT
BUREAU OF ENVIRONMENTAL HEALTH
03-292665**Typock IS PERMITTED TO INSTALL ☒ ALTER ☐

ADDRESS: _____ PHONE NUMBER: _____

SUBDIVISION: _____ LOT NUMBER: _____

ADDRESS: 13260 Triadelphia Rd PROPERTY OWNER: Shirley MitchellSEPTIC TANK CAPACITY (GALLONS): Ex 1250 OUTLET BAFFLE FILTER REQUIRED ☐PUMP CHAMBER CAPACITY (GALLONS): _____ COMPARTMENTED TANK REQUIRED ☐NUMBER OF BEDROOMS: 4 - sized for 5SQUARE FEET PER BEDROOM: 210LINEAR FEET OF TRENCH REQUIRED: 100

TRENCHES:	Trench to be 2 feet wide. Inlet 4 feet below original grade. Bottom maximum depth 1/2 feet below original grade. Effective area begins at 5 feet below original grade. 8 feet of stone below distribution pipe.
LOCATION:	Install (2) 50' trenches hook into dry well pipe to D.B.
NOTES:	FAILING

PLANS APPROVED: [Signature] DATE: 1/2/03

NOTE: PERMIT VOID AFTER 2 YEARS

NOTE: CONTRACTOR RESPONSIBLE FOR SCHEDULING A PRE-CONSTRUCTION INSPECTION FOR ALL INSTALLATIONS

NOTE: WATERTIGHT SEPTIC TANKS REQUIRED


NOTE: ALL PARTS OF SEPTIC SYSTEM SHALL BE 100 FEET FROM ANY WATER WELL

NOTE: MANHOLE RISERS REQUIRED ON ALL SEPTIC TANKS AND PUMP CHAMBERS UNLESS SPECIFICALLY AUTHORIZED

**NEITHER THE HOWARD COUNTY COUNCIL NOR THE HEALTH DEPARTMENT IS
RESPONSIBLE FOR THE SUCCESSFUL OPERATION OF ANY SYSTEM
PERMITTEE RESPONSIBLE FOR OBTAINING FINAL APPROVAL ON THIS PERMIT
CALL 410-313-2640 FOR INSPECTION OF SEPTIC SYSTEM**

P518502

NOT TO SCALE

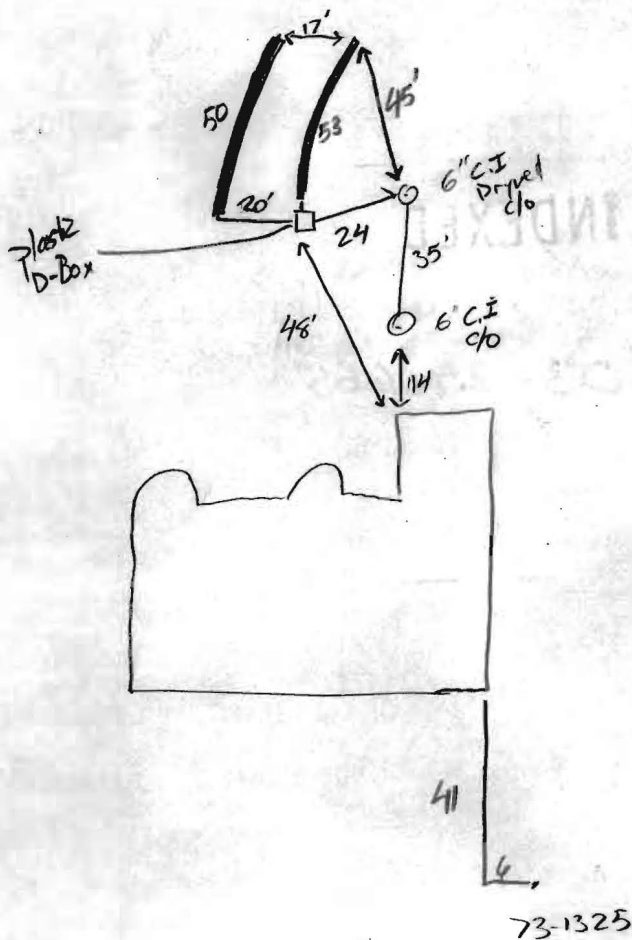

ROAD

TRENCH/DRAINFIELD DATA		
WIDTH	INLET	BOTTOM
2	4	12
NUMBER OF TRENCHES		
2		
TOTAL LENGTH		
103		
ABSORPTION AREA		
1200 ft ²		
DISTRIBUTION BOX LEVEL		
✓		
DISTRIBUTION BOX BAFFLE		
✓		
DISTRIBUTION BOX PORT		

SEPTIC TANK DATA	
SEPTIC TANK 1 LEVEL	N/A
CAPACITY	_____ GAL
SEAM LOC	_____
TANK LID DEPTH	_____
BAFFLES	_____
BAFFLE FILTER	_____
MANHOLE LOC	_____
6" PORT LOC	_____
WATERTIGHT TEST	_____
SEPTIC TANK 2 LEVEL	N/A
CAPACITY	_____ GAL
SEAM LOC	_____
TANK LID DEPTH	_____
BAFFLES	_____
BAFFLE FILTER	_____
MANHOLE LOC	_____
6" PORT LOC	_____
WATERTIGHT TEST	_____

PRE-CONSTRUCTION 1/2/03 - Home owner said they want to add a bedroom sometime (?) in the future and ask me to size
 INSTALLATION trenches using 5 bedrooms. Used faded D.W. as additional area for S.T. Possibly won't have to install 1500 gal S.T. when addition is done. (50) 1/2/03 Verified trench width & lengths O.K. to back fill (50)

FINAL INSPECTOR

[Signature]

DATE OF APPROVAL

1/21/03