


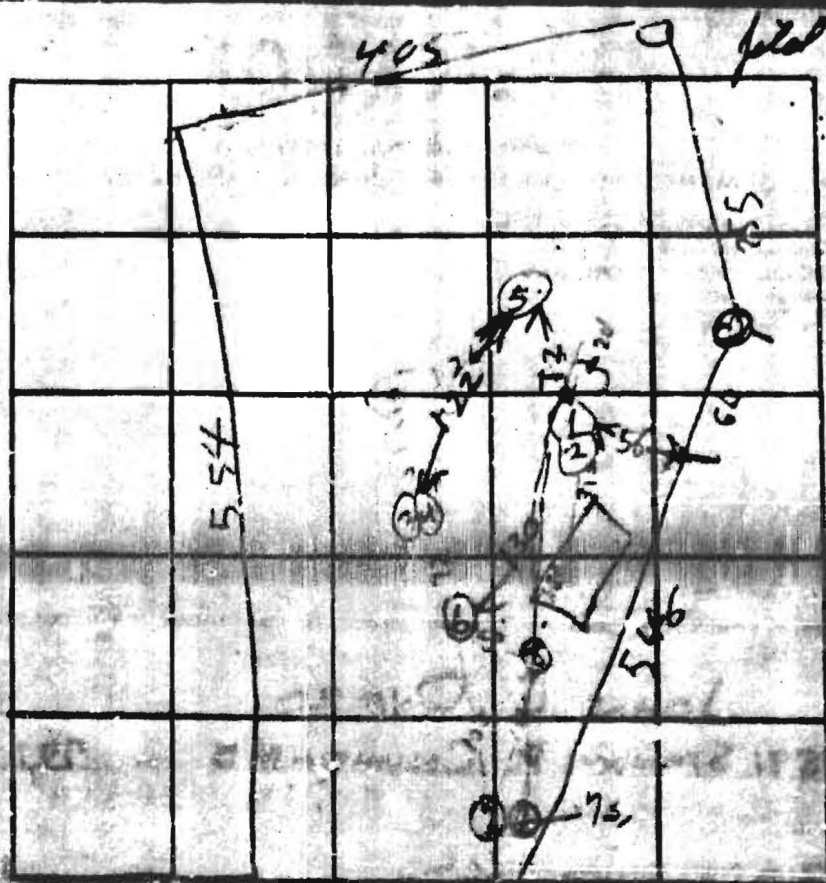

zu
attischen
Plat

lot 11

13260
Sundberg

AP 59116

INDICATE NORTH. - NAME ADJUTANT COMPANY AS BASE LINE

DATE	TEST NO.	DEPTH	PDC-401		TEST #1 8000		PSI
			START	STOP	START	STOP	
4/1/74	1	4	920	921	921	923	2
4/1/74	2	11	920	924	921	923	2
	3	3 1/2	944	945	945	946	1
	4	11	945	947	949	952	5
	5	10	FOR BOT	TEST CLAY 2 FT SANDY DR			
4/1/74	6	11 1/2	FOR BOT	TEST CLAY 2 1/2 FT CLAY DR			
4/1/74	7d	13 1/2	10 ²⁵	10 ²⁶	10 ²⁶	10 ²⁶	14
	7s	3 1/2	10 ³⁰	10 ⁵⁰	Fail at top		
	8	4'	940	945	945	950	5
	7s	6'	920	1000	1000	1010	10

STEWART


TYPE OF SOIL.

TESTED BY

ALSO PRESENT:

$$5 \times 180 \div 9.5 = 106 - 23 = 43$$

Plans OK for Septic System
2904 12-31-75

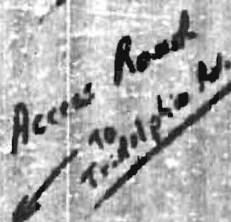

LARRY L. and C. L. SMITH

Lot 11

Trinidadia Faint