


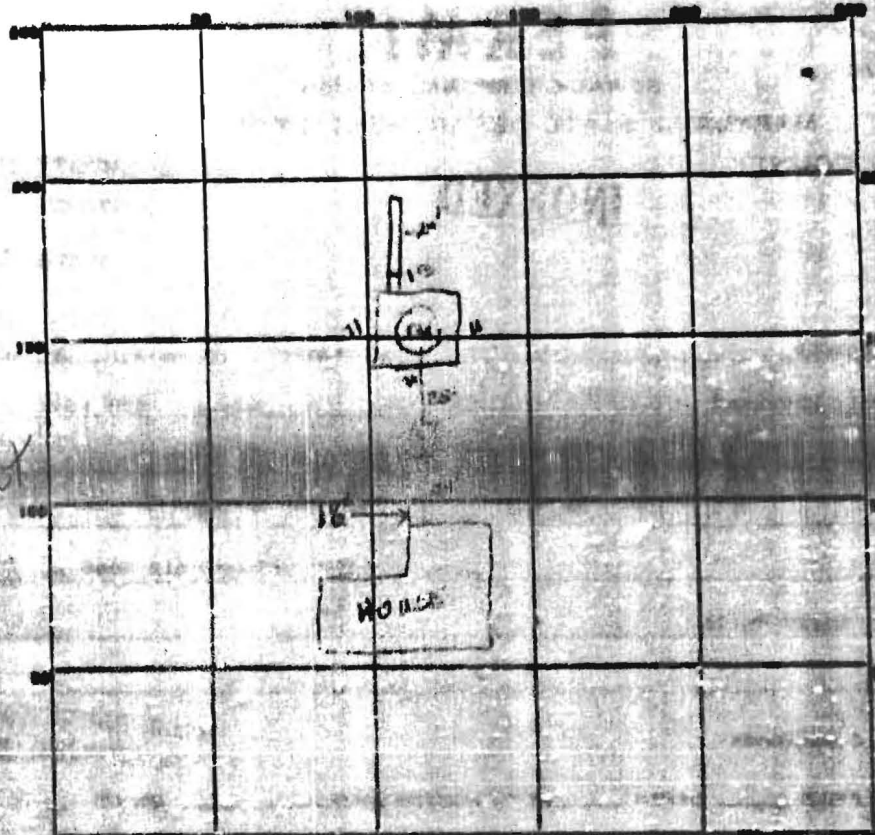

45
 74
 300
 12
 15
 24
 18
 142
 304

INDICATE NORTH - NAME ADJOINING ROADWAY AS SHOWN ON
 UNNAMED ROAD

PERMIT CARD

ST DW

SEPTIC TANK LEVEL

1250 gal

CLEANOUTS

DISTRIBUTION BOX LEVEL

TRENCH DEPTH

12 FT.

TRENCH WIDTH

2 FT.

GRAVEL DEPTH

8 1/2 FT.

TOTAL LENGTH

24 FT.

NUMBER OF TRENCHES

1

SIDEWALL

204

SEEPAGE RATE/INCH-DIAMETER

45

DEPTH BELOW INLET

3 1/2 FT.

ABSORBENT AREA

302 SQ. FT.

IN RW

TOTAL d = 576 d

REMARKS

5/12/76 AM Partial inst. Trench 12' deep

5/12/76 PM Final OK

DATE SYSTEM APPROVED

5/12/76

INSPECTOR

William H. Tupper

1422644