

ere
for

Miss Sachs

Re. Friendship Manor
Lot 37 - Scheel Const. Co.

1. will have to uncover
sewer line where it enters
& leaves septic tank & enters
Dry Well
2. will have to uncover
Septic tank.

3. will have to add trench
off D.W. - leave 5' earth
buffer between D.W. & trench.

Trench to be 25 ft long - 2 ft
wide, 10 ft deep - with at least
6 ft of gravel under pipe.

Trench to be laid on level
ground - towards road

Mrs. Sacks - 647-9213
1305 Holliben Road
Sevin Park, Md 21146

Ref: 2558 Willworth Way
Friendship Manor
Lot 37

Septic has never been
approved by us -

HOWARD COUNTY HEALTH DEPARTMENT

JOYCE M. BOYD, M.D., M.P.H.
DEPUTY STATE AND
COUNTY HEALTH OFFICER



P.O. BOX 476
ELLICOTT CITY, MARYLAND 21043
TELEPHONE: 992-2333

May 11, 1979

Mrs. Sachs
1305 Holliben Road
Severn Park, Md. 21146

RE: Friendship Manor - Lot 37
2558 Wellwoth Way
Scheel Construction Company

Dear Mrs. Sachs,

As per our phone conversation on May 11, 1979, the following procedure was discussed:


1. Will have to uncover sewer line where it enters and leaves septic tank and where it enters dry well.
2. Will have to uncover septic tank.
3. Will have to add trench off dry well - leave 5 feet earth buffer between dry well and trench. Trench to be 25 feet long - 2 feet wide - 10 feet deep - with at least 6 feet of gravel under pipe. Trench to be laid on level ground - towards road.

Very truly yours,

A handwritten signature in cursive script, reading "Donald W. Monaghan".

Donald W. Monaghan, Sanitarian
Water and Sewerage Program

DWM:jr

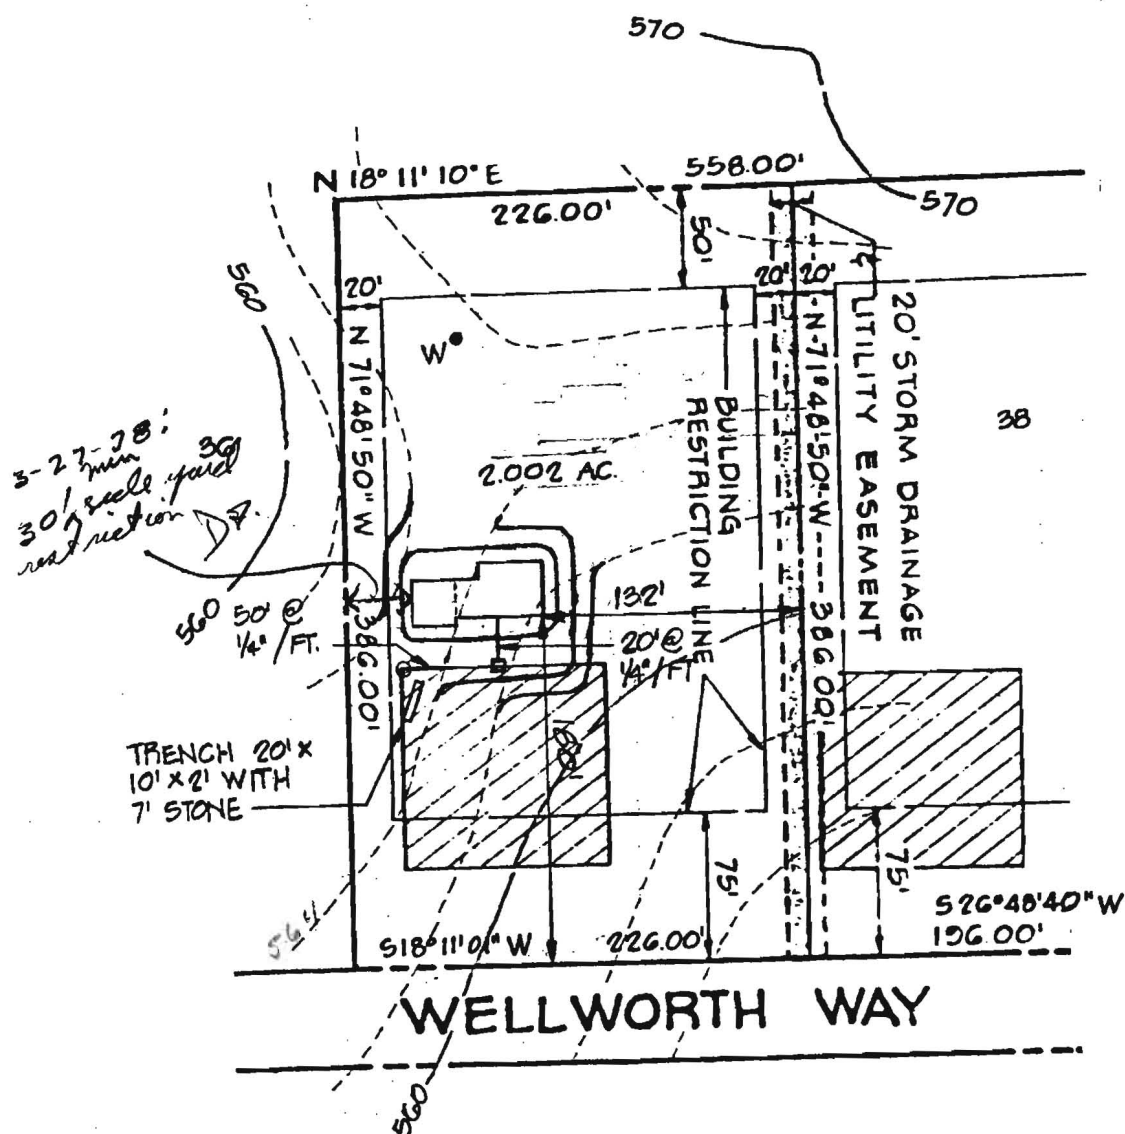

HOUSE:		DRYWELL:	
F.F. ELEV.	566.8	EX. GRADE	565.0 ✓
BSMT. ELEV.	558.0	PROP. GRADE	565.0 ✓
INV. OUT	564.9	INV. IN	562.0 OK ✓
SEPTIC TANK:		WELL:	
EX. GRADE	563.0	EX. GRADE	565.5 ✓
PROP. GRADE	564.5 ✓	PROP. GRADE	565.5 ✓
INV. IN	563.3 ✓		
INV. OUT	563.0		

NOTE: Topography shown hereon is based on Howard County Aerial Topography Maps. Contractor to set grades in the field.

1" Fall St to Dw. 50' run


TITLE			
GRADING STUDY			
PROJECT			
FRIENDSHIP MANOR - SECTION 2 - LOT 37			
LOCATION			
THIRD ELECTION DISTRICT - HOWARD COUNTY, MARYLAND			
DATE:	DESIGN BY:	DRAWN BY:	CHECKED BY:
FEB. 15, 1978	RM	DMR	RM
SCALE:	JOB NO.:	DRAWING NO.:	
1" = 100'	7768	1	

boender associates

engineers
surveyors
planners


THIS PLAT CAN NOT BE USED TO ESTABLISH PROPERTY LINES OR CORNERS.

SECTION 2
 MAP MAJOR PLAT #3886
 SECTION DISTRICT HOWARD CO. MD

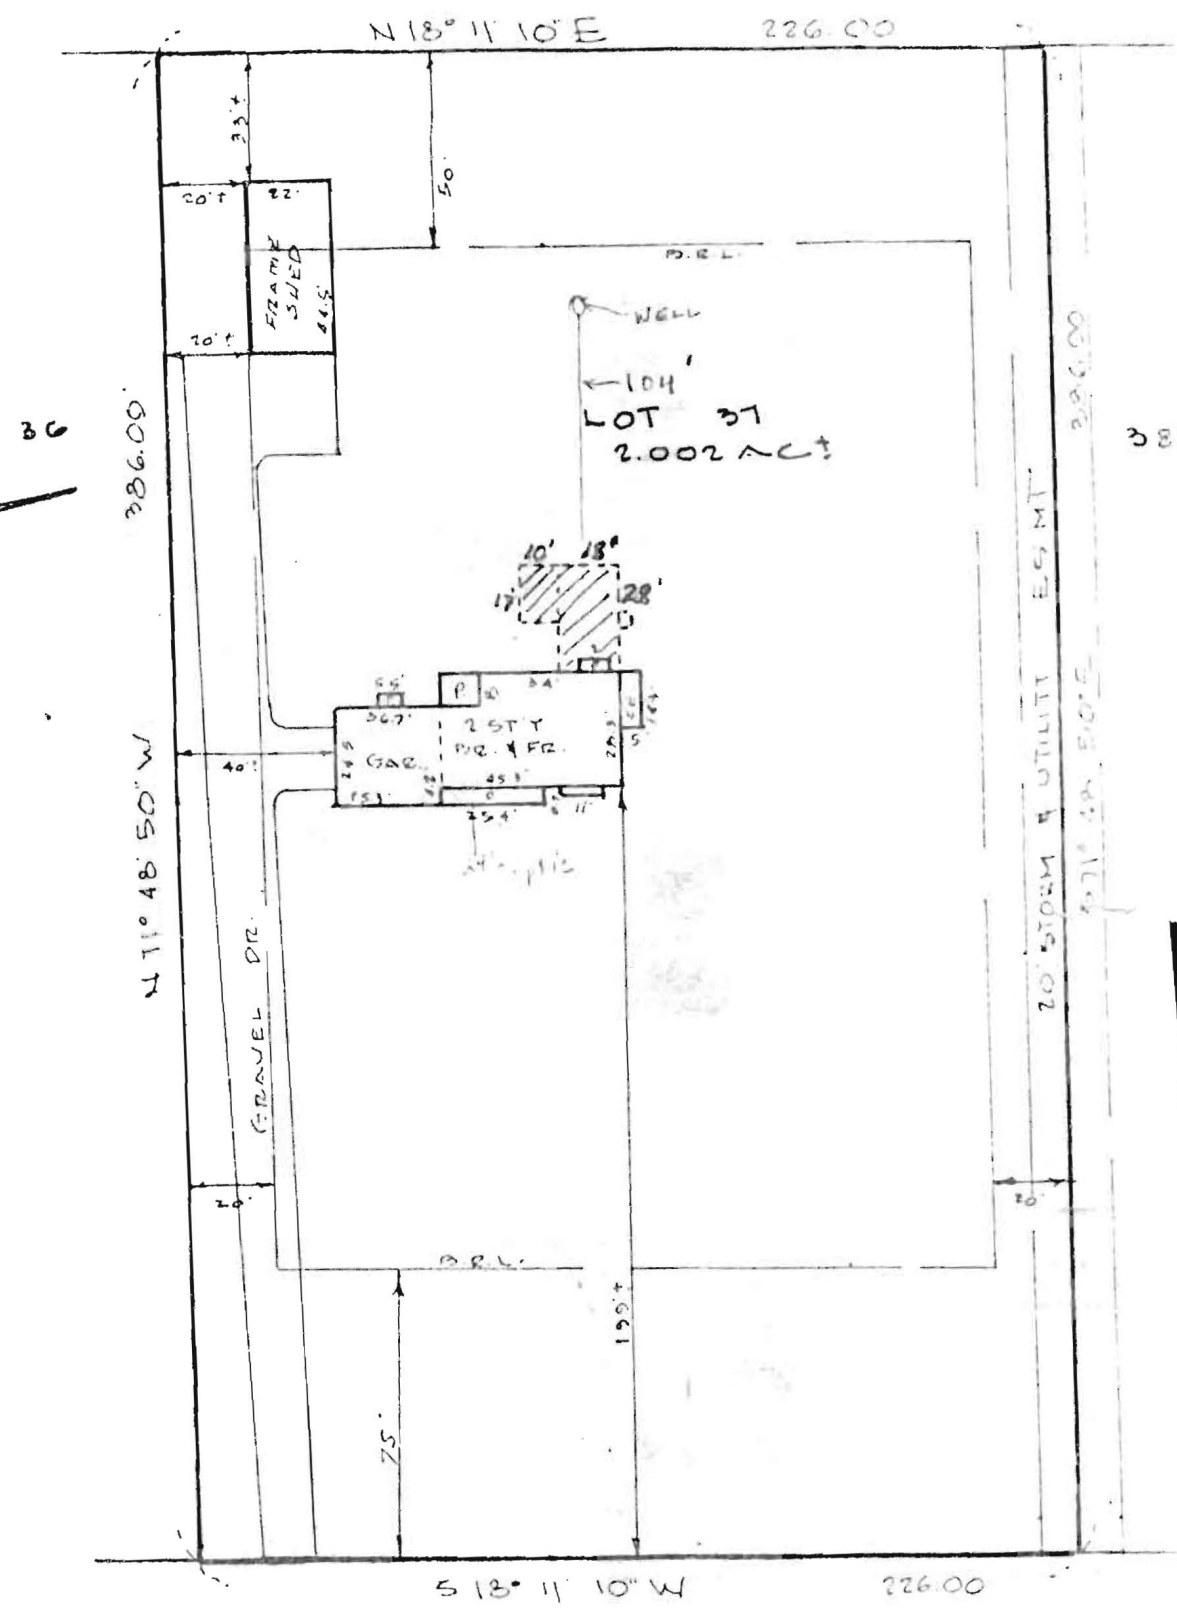

WELLWORTH WAY
 50' E/W

CERTIFICATION	SEAL	SCALE 1"=50' DATES 5/21/8
This is to certify that I have surveyed the property known as: <u>2598 WELLWORTH WAY</u> for the purpose of locating the improvements thereon, and the improvements are located as shown.	 Walter Park WALTER PARK, L. S.	PROJ. 828,000.00 TOWSON 730,000.00 COLUMBIA HUDKINS ASSOCIATES, INC. <i>Surveyors and Subdivision Designers</i> SUITE 211 JOSEPH SQUARE 5185 HARPERS FARM ROAD COLUMBIA, MARYLAND 21044

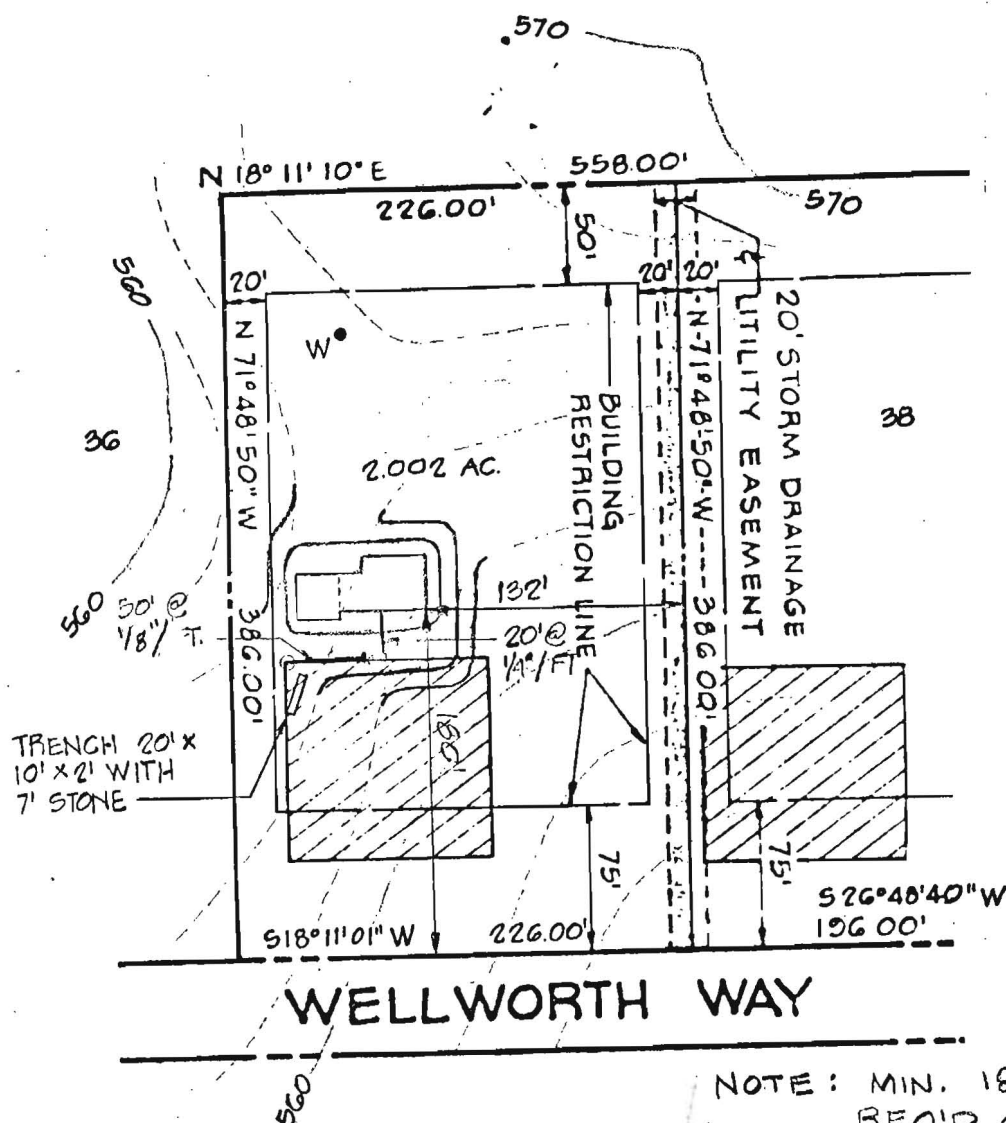

HOUSE:		DRYWELL:	
FF. ELEV.	566.8	EX. GRADE	565.0
BSMT. ELEV.	558.0	PROP. GRADE	565.0
INV. OUT	569.2	INV. IN	562.0
SEPTIC TANK:		WELL:	
EX. GRADE	563.0	EX. GRADE	565.5
PROP. GRADE	564.5	PROP. GRADE	565.5
INV. IN	562.8		
INV. OUT	562.5		


NOTE: Topography shown hereon is based on Howard County Aerial Topography Maps. Contractor to set grades in the field.

NOTE: ALL SEWER JOINTS WHICH ARE ABOVE EXISTING GRADE WILL BE SUPPORTED BY CONCRETE PILES WHICH ARE ON ORIGINAL GRADE.

TITLE GRADING STUDY			
PROJECT FRIENDSHIP MANOR - SECTION 2 - LOT 37			
LOCATION THIRD ELECTION DISTRICT - HOWARD COUNTY, MARYLAND			
DATE: FEB. 15, 1978	DESIGN BY: RM	DRAWN BY: DMR	CHECKED BY: RM
SCALE: 1" = 100'	JOB NO.: 7768	DRAWING NO.: 1	

boender associates

engineers
surveyors
planners

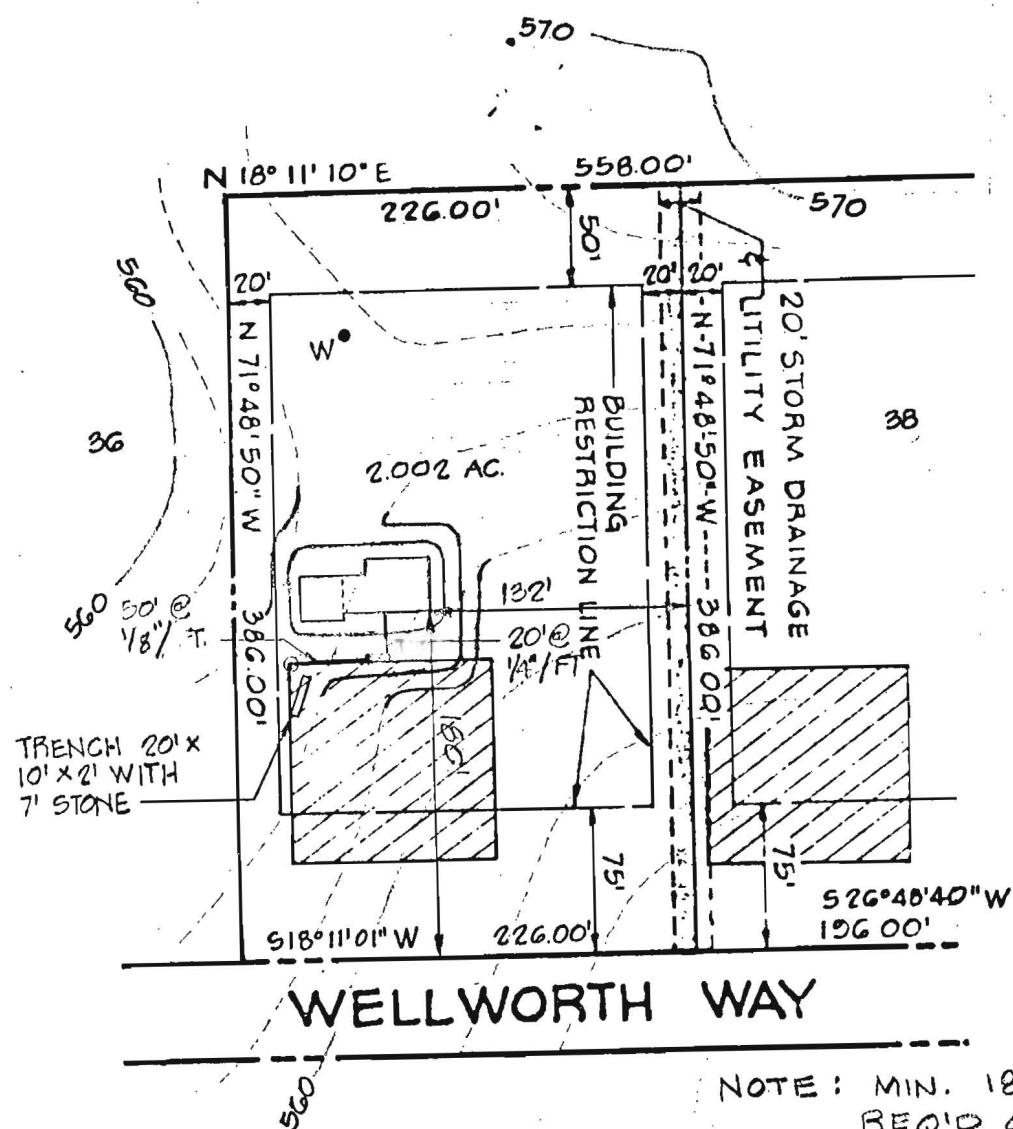

APP. 4-21-78
D.M.R.

NOTE: MIN. 18" FILL
REQ'D OVER
SEWER CONN.

HOUSE:		DRYWELL:	
FF. ELEV.	566.8	EX. GRADE	565.0
BSMT. ELEV.	558.0	PROP. GRADE	565.0
INV. OUT	569.2	INV. IN	562.0
SEPTIC TANK:		WELL:	
EX. GRADE	563.0	EX. GRADE	565.5
PROP. GRADE	564.5	PROP. GRADE	565.5
INV. IN	562.8		
INV. OUT	562.5		

NOTE: Topography shown hereon is based on Howard County Aerial Topography Maps. Contractor to set grades in the field.

NOTE: ALL SEWER JOINTS WHICH ARE ABOVE EXISTING GRADE WILL BE SUPPORTED BY CONCRETE PILES WHICH ARE ON ORIGINAL GRADE.

TITLE GRADING STUDY			
PROJECT FRIENDSHIP MANOR - SECTION 2 - LOT 37			
LOCATION THIRD ELECTION DISTRICT - HOWARD COUNTY, MARYLAND			
DATE: FEB. 15, 1978	DESIGN BY: RM	DRAWN BY: DMR	CHECKED BY: RM
SCALE: 1" = 100'	JOB NO.: 7768	DRAWING NO.: 1	

boender associates

engineers
surveyors
planners