



Approved for Release
OK KB

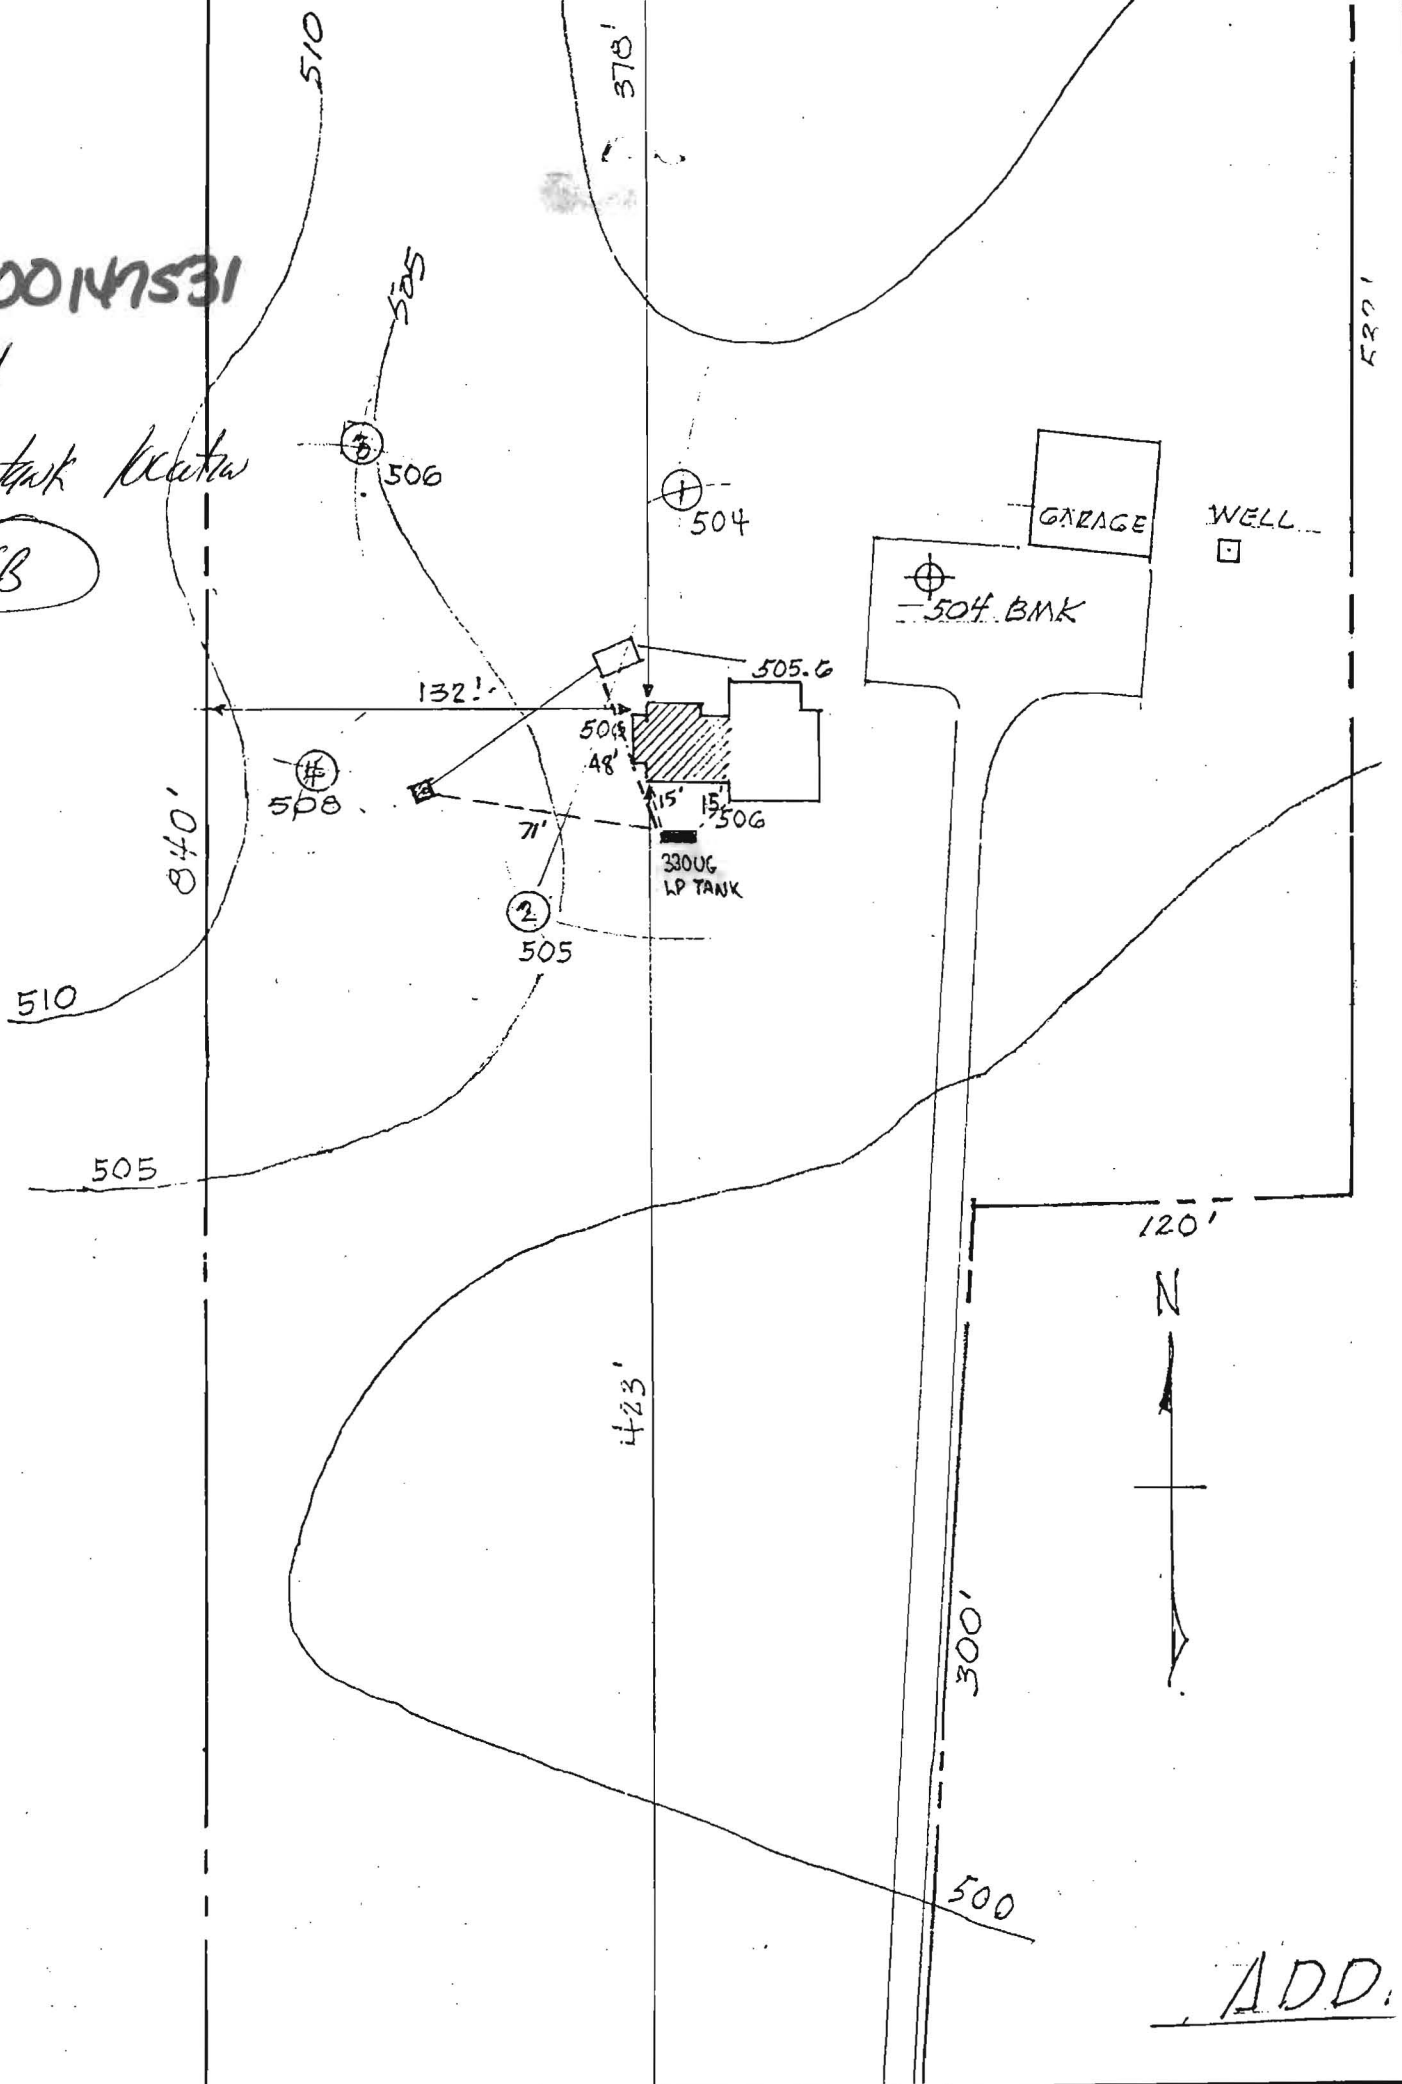

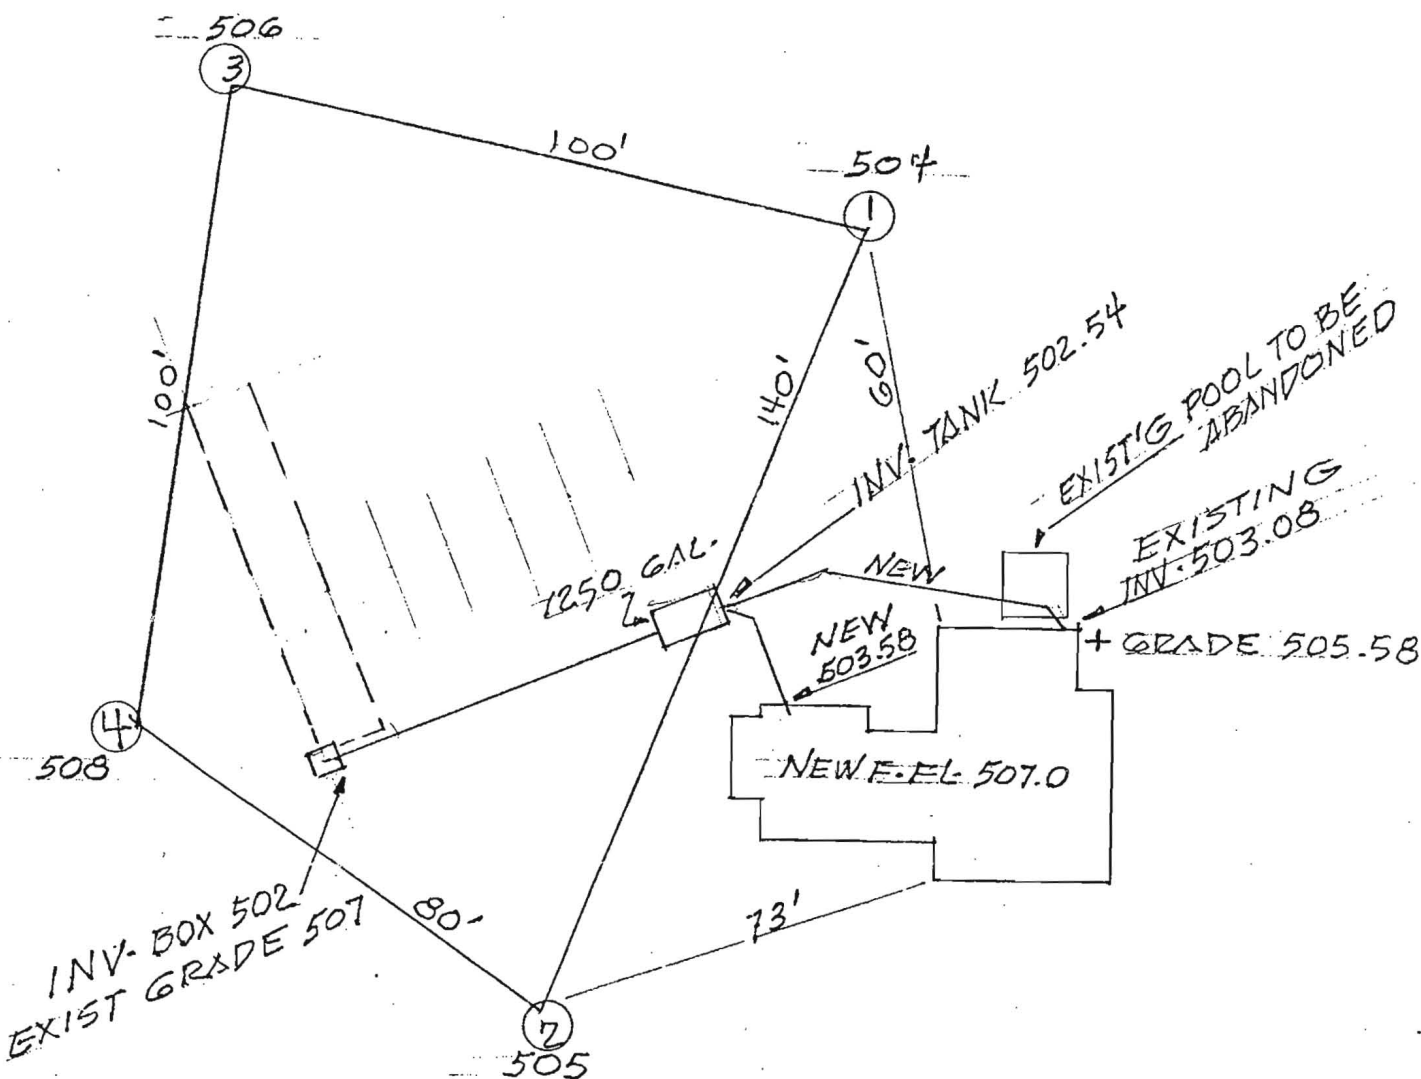

SEPTIC DIAGRAM

1" = 30'