

PUB. SEWER STATUS VERIFIED BY _____

ISSUE DATE: _____

APPROVAL DATE: _____

PERMIT INDEXED

P 518570-A #

A re-index

ON-SITE SEWAGE DISPOSAL SYSTEM HOWARD COUNTY HEALTH DEPARTMENT BUREAU OF ENVIRONMENTAL HEALTH

03-287289

IS PERMITTED TO INSTALL ALTER

ADDRESS: _____ PHONE NUMBER: _____

SUBDIVISION: Turf Valley LOT NUMBER: 4

ADDRESS: 2622 Turf Valley Road PROPERTY OWNER: Linda Wolf

SEPTIC TANK CAPACITY (GALLONS): _____

PUMP CHAMBER CAPACITY (GALLONS): _____

NUMBER OF BEDROOMS: _____

SQUARE FEET PER BEDROOM: _____

LINEAR FEET OF TRENCH REQUIRED: _____

TRENCHES:	Trench to be _____ feet wide. Inlet _____ feet below original grade. Bottom maximum depth _____ feet below original grade. Effective area begins at _____ feet below original grade. _____ feet of stone below distribution pipe.
LOCATION:	
PURPOSE:	Re-index file, building permit addition approved 3/13/03 for new deck

PLANS APPROVED: _____ DATE: _____

- NOTE: PERMIT VOID AFTER 2 YEARS
- NOTE: CONTRACTOR RESPONSIBLE FOR SCHEDULING A PRE-CONSTRUCTION INSPECTION FOR ALL INSTALLATIONS
- NOTE: WATERTIGHT SEPTIC TANKS REQUIRED
- NOTE: ALL PARTS OF SEPTIC SYSTEM SHALL BE 100 FEET FROM ANY WATER WELL
- NOTE: MANHOLE RISERS REQUIRED ON ALL SEPTIC TANKS AND PUMP CHAMBERS

**NEITHER THE HOWARD COUNTY COUNCIL NOR THE HEALTH DEPARTMENT IS
RESPONSIBLE FOR THE SUCCESSFUL OPERATION OF ANY SYSTEM
PERMITTEE RESPONSIBLE FOR OBTAINING FINAL APPROVAL ON THIS PERMIT
CALL 410-313-2640 FOR INSPECTION OF SEPTIC SYSTEM**

P518570-H

3/23/65

approved 2/23/65

PERMIT

SEWAGE DISPOSAL SYSTEM

P. 0000
A. 0000

MARYLAND STATE DEPARTMENT OF HEALTH

HOWARD COUNTY

INDEXED

ELLICOTT CITY

DISTRICT 2

DATE 3/23/65

5/24/65

IS PERMITTED TO INSTALL X ALTS

ADDRESS 8 Main Street, Ellicott City, Md. PHONE NO 5-1000

A SEWAGE DISPOSAL SYSTEM LOCATED AT _____

SUBDIVISION Part 10000 ROAD East Valley Rd. LOT 5 A, Sec. 1

PROPERTY OWNER Mr. Hanson

ADDRESS _____

SPECIFICATION 3

DEPTH _____ FEET. BOTTOM AREA _____ SQ. FT.

CREASE FITS _____ ABSORBENT SIDE-WALL AREA _____ SQ. FT.

SEPTIC TANK CAPACITY 750 GALLONS

FOR BATTERY GRINDER, INCREASE DISPOSAL AREA 25% & TANK CAPACITY 50%.

OTHER Sept. tank on 300 sq. ft. absorbent sidewall area below inlet pipe.

Sept. tank wall from 75 to 95 ft. from back lot line and from 25 to

45 ft. from 2-10 sidewalk on lot in front from East Valley Rd.


PLANS APPROVED BY [Signature] DATE 2/23/65

FILL SEPTIC TANK AND DISTRIBUTION BOX WITH WATER BEFORE CALLING FOR AN INSPECTION. COVER HO W/TK UNTIL INSPECTED AND APPROVED.

NEITHER THE HOWARD COUNTY COMMISSIONERS NOR THE HEALTH DEPARTMENT IS RESPONSIBLE FOR THE SUCCESSFUL OPERATION OF ANY SYSTEM.

1171

A07978

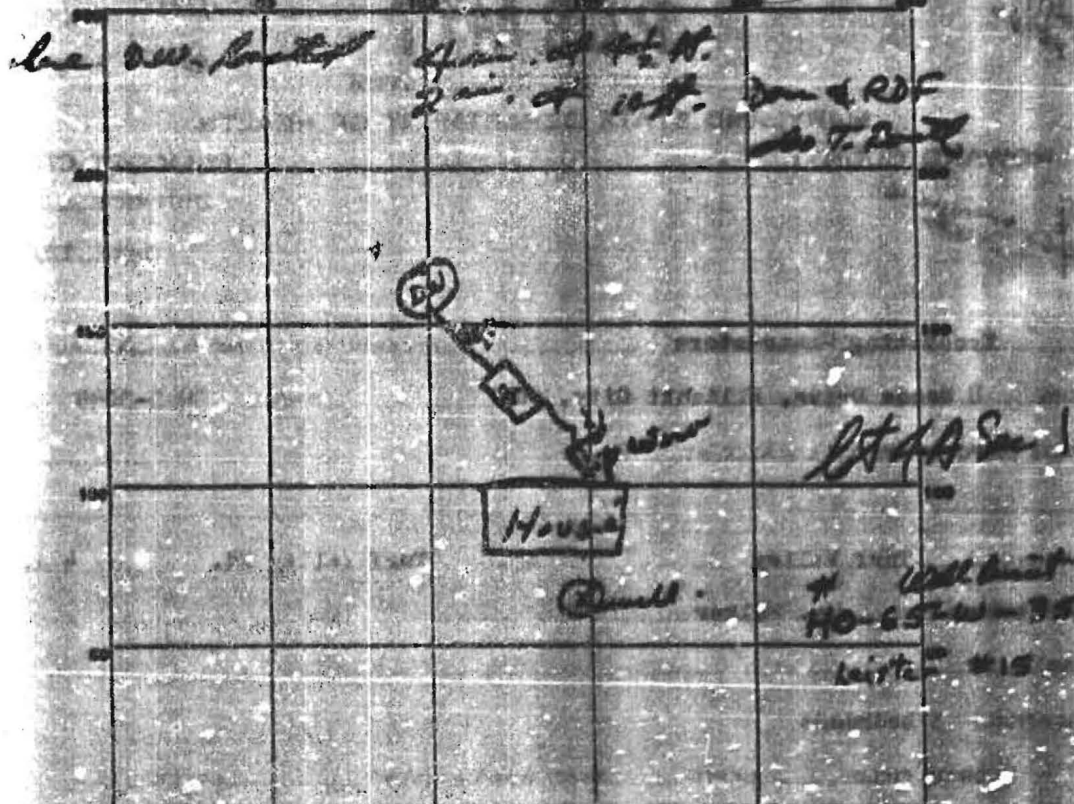

INDICATE NORTH OR MAIN APPROXIMATE DIRECTION AS BASE LINE.
 not posted on job *Trinity Valley Ra*
 CARD

TANK LEVEL 2A CLEARINGS OK
 BUTTER BOX LEVEL _____
 FIELD DEPTH _____ FT. TRENCH WIDTH _____ FT.
 GRAVEL DEPTH _____ IN. TOTAL LENGTH _____ FT.
 NUMBER OF TRENCHES _____ TOTAL BOTTOM AREA _____
 SIZE PITS, DEPTH DIAMETER _____ FT. DEPTH BELOW W/LCT _____ FT.
 ABSORBENT AREA _____ SQ. FT.

OK 1/24/55 - have sewer to ^{front of house} ~~main~~ ^{main} ~~main~~ not installed and used
 final inspection when this is done OK to come Tank & Dig Well
 3/29/55 - pipe installed

SYSTEM APPROVED 5-21-55 INSPECTOR W. H. Henry