

PUB. SEWER STATUS VERIFIED BY _____

ISSUE DATE: _____

APPROVAL DATE: _____

PERMIT

P 518570-A

A re-index

INDEXED

ON-SITE SEWAGE DISPOSAL SYSTEM HOWARD COUNTY HEALTH DEPARTMENT BUREAU OF ENVIRONMENTAL HEALTH

04-325168

IS PERMITTED TO INSTALL ☐ ALTER ☒

ADDRESS: _____ PHONE NUMBER: _____

SUBDIVISION: Daisy Hill Estates LOT NUMBER: PARCEL 4

ADDRESS: 15867 Union Chapel Road PROPERTY OWNER: Dean

SEPTIC TANK CAPACITY (GALLONS): _____

PUMP CHAMBER CAPACITY (GALLONS): _____

NUMBER OF BEDROOMS: _____

SQUARE FEET PER BEDROOM: _____

LINEAR FEET OF TRENCH REQUIRED: _____

**BUILDING PERMIT SIGNED
AND RETURNED**

5/19/03 BOV141680 -UG LP TANK

TRENCHES:	Trench to be _____ feet wide. Inlet _____ feet below original grade. Bottom maximum depth _____ feet below original grade. Effective area begins at _____ feet below original grade. _____ feet of stone below distribution pipe.
LOCATION:	
PURPOSE:	Re-index file, building permit addition approved 3/27/03

PLANS APPROVED: _____ DATE: _____

NOTE: PERMIT VOID AFTER 2 YEARS

NOTE: CONTRACTOR RESPONSIBLE FOR SCHEDULING A PRE-CONSTRUCTION INSPECTION FOR ALL INSTALLATIONS

NOTE: WATERTIGHT SEPTIC TANKS REQUIRED

NOTE: ALL PARTS OF SEPTIC SYSTEM SHALL BE 100 FEET FROM ANY WATER WELL

NOTE: MANHOLE RISERS REQUIRED ON ALL SEPTIC TANKS AND PUMP CHAMBERS

**NEITHER THE HOWARD COUNTY COUNCIL NOR THE HEALTH DEPARTMENT IS
RESPONSIBLE FOR THE SUCCESSFUL OPERATION OF ANY SYSTEM
PERMITTEE RESPONSIBLE FOR OBTAINING FINAL APPROVAL ON THIS PERMIT
CALL 410-313-2640 FOR INSPECTION OF SEPTIC SYSTEM**

P518570-A

PERMIT

SEWAGE DISPOSAL SYSTEM

MARYLAND STATE DEPARTMENT OF HEALTH

HOWARD COUNTY

INDEXED

ELLCOTT CITY

DISTRICT 4th

DATE 8/3/78

Liberty Brothers Service, Inc.

IS PERMITTED TO INSTALL ☒ ALTER

ADDRESS 7311 Brangles Road, Marriottsville, Md.

PHONE 795-2642

SUBDIVISION Daisy Hill Estates

ROAD 15867 Union Chapel Road LOT 6, Blk. A, Sec. 2

PROPERTY OWNER Mrs. N. Wright, III

ADDRESS 6421 Jodie Street, New Carrollton, Md.

SPECIFICATIONS 4 bedrooms

SEPTIC TANK CAPACITY 1250 GALLONS

DRAIN FIELD DEPTH FEET, BOTTOM AREA SQ. FT.

DEEP TRENCH DEPTH FEET, BOTTOM AREA SQ. FT.

SEEPAGE PTS ABSORBENT SIDE WALL AREA 156 SQ. FT. per bedroom

INLET PIPE 4 FT. BELOW ORIGINAL GRADE. MAXIMUM DEPTH 11 FT. BELOW ORIGINAL GRADE

EFFECTIVE DEPTH AT 175 - 300 FT. BELOW ORIGINAL GRADE.

LOCATE DISPOSAL AREA 385 FT. FROM front LOT LINE AND 30 FT. FROM left LOT LINE AS SEEN WHEN

FACING LOT FROM Union Chapel Road.

OK for trench off dry well. Trench to follow the contour of the ground after

a 5 ft. earth buffer.

PLANS APPROVED BY Robert Torre

DATE 1/2/73

COVER NO WORK UNTIL INSPECTED AND APPROVED.

NEITHER THE HOWARD COUNTY COUNCIL NOR THE HEALTH DEPARTMENT IS RESPONSIBLE FOR THE SUCCESSFUL OPERATION OF ANY SYSTEM.

NOTE IF TRENCH IS USED CALL FOR INSPECTION BEFORE PLACING GRAVEL IN TRENCH.

NOTE NO DRY WELL SHALL EXCEED 15 FOOT IN DIAMETER.


NOTE ALL PIPE FROM HOUSE TO DISPOSAL AREA MUST BE CAST IRON.

PERMIT VOID AFTER THREE YEARS.

NOTE INSTALL STAND PIPE ON SEPTIC TANK AND DRY WELL. STAND PIPES MUST BE 6 INCHES IN DIAMETER. CAST IRON, CONCRETE OR TERRA COTTA ACCEPTED.

*INSTALLER IS RESPONSIBLE FOR OBTAINING FINAL APPROVAL ON THIS PERMIT.

16454

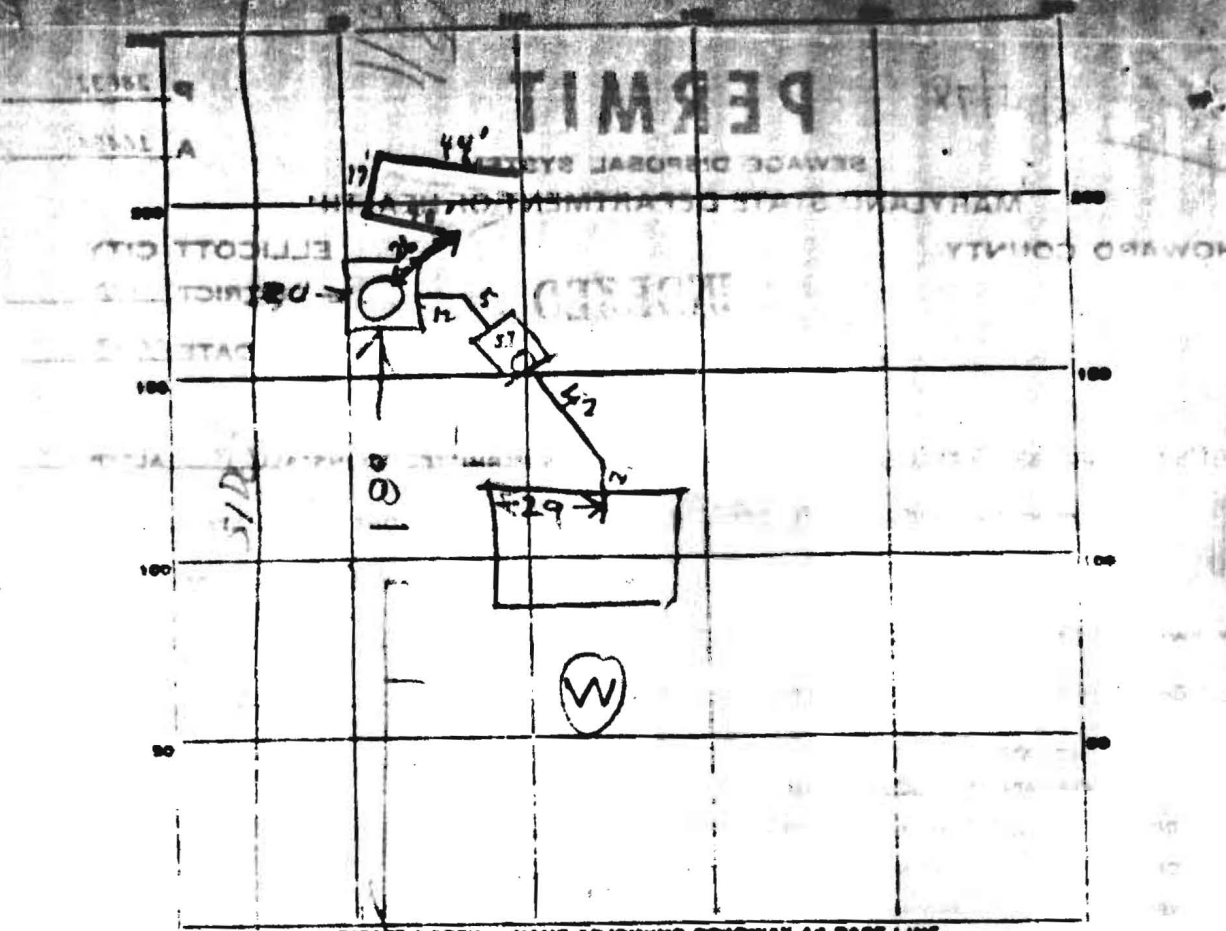

INDICATE NORTH - NAME ADJOINING ROADWAY AS BASE LINE.

PERMIT CARD _____

SEPTIC TANK, LEVEL 1250 CLEANOUTS O/K

DISTRIBUTION BOX, LEVEL 1250 2-3 FT BELOW GRADE

DITCH DEPTH ? FT. TRENCH WIDTH 3 FT.

GRAVEL DEPTH ↓ IN. TOTAL LENGTH 101 FT.

NUMBER OF TRENCHES 1 TOTAL BOTTOM AREA 303 (1)

SEEPAGE PITS, INSIDE DIAMETER 52 FT. DEPTH BELOW INLET 7 FT.

ABSORBENT AREA 364 (2) = 667

REMARKS 3/11/78 DW 1 1/2 4-5 FT BELOW GRADE

9/11/78 OK TO COVER TANK & DW DITCH

CAVED IN, DECIDED TO PUT TILE FIELD

3 TO 5 FT DEEP FILLED WITH 1 1/2

FT STONE 90 FT LONG X 3 FT WIDE

Trench 3' wide, 3' deep, 90' long, 3' wide

DATE SYSTEM APPROVED 3/14/78 INSPECTOR C.P. Tucker