

9878

STATE OF MISSISSIPPI
NATURAL RESOURCES ADMINISTRATION
TAMM STATE OFFICE BLDG., ANNAPOIS, MD. 20601
WELL COMPLETION REPORT

WELL NO. 10454

DEPTH OF WELL 225
(TO NEAREST FOOT)

PERMIT NO. FROM "PERMIT TO DRILL WELL"
40-718-0723

OWNER Wright

STREET OR RFD 6421 POST OFFICE Thibodaux La

DRILLER IDENTIFICATION NO. 202

WELL LOG

STATE THE KIND OF FORMATIONS PENETRATED, THEIR COLOR, DEPTH, THICKNESS AND IF MAJOR CHANGES

DESCRIPTION	FEET	TO	FROM
1000' Sand	40		
1000' Sand	110		
1000' Sand	110		
1000' Sand	110		

WELL DESCRIPTION

WELL HAS BEEN DRILLED (CIRCLE APPROPRIATE BOX)

TYPE OF DRILLING MATERIAL (CIRCLE NO.)

CONCRETE ☒ CEMENT ☒ CLAY ☒

NO. OF DAYS 12 NO. OF PUMPS 112

GALLONS OF WATER 72

DEPTH OF GROUT SEAL (TO NEAREST FOOT)

FROM 40 FT. TO 50 FT.

WELL IS IF FROM SURFACE

CASING RECORD

CASING TYPES

INSERT APPROPRIATE CODE BELOW

STEEL ☒ CONCRETE ☒ PLASTIC ☒ OTHER ☒

MAIN CASING TYPE S-L

NOMINAL DIAMETER TOP MAGNIFYING (NEAREST INCH) 6

TOTAL DEPTH OF CASING (NEAREST FOOT) 110

OTHER CASING (IF USED)

DIAMETER (INCH) 6 DEPTH (FEET) 110

SCREEN RECORD

SCREEN TYPE (CIRCLE NO.)

INSERT APPROPRIATE CODE BELOW

STEEL ☒ BRASS ☒ OPEN MESH ☒ PLASTIC ☒ OTHER ☒

DEPT. NO. 1

DEPTH (NEAREST WHOLE FOOT) FROM 40 TO 225

SCREEN NO. 1

SCREEN SIZE 1. 20 2. 40 3. 60

DIAMETER OF SCREEN 6 (NEAREST INCH)

GRAVEL PACK 50

IF WELL DRILLED WAS A FLOWING WELL CIRCLE BOX ☒

PUMP TEST

WELL PUMPED (TO NEAREST HOUR) 2

PUMPING RATE (GALLONS PER MINUTE TO NEAREST GALLON) 10

METHOD USED TO MEASURE PUMPING RATE

WATER LEVEL (DISTANCE FROM LAND SURFACE)

BEFORE PUMPING 15 FEET

AFTER PUMPING 5 FEET

TYPE OF PUMPER USED (CIRCLE APPROPRIATE BOX)

A AIR ☒ P PISTON ☒ T TURBINE ☒ C CENTRIFUGAL ☒ R ROTARY ☒ S OTHER (SPECIFY BELOW) ☒ J JET ☒ B SUBMERSIBLE ☒

PUMP INSTALLED

TYPE OF PUMP (CIRCLE APPROPRIATE LETTER IN BOX - SEE ABOVE: A, C, J, P, R, S, T, V, W)

DRILLER WILL INSTALL PUMP (CIRCLE APPROPRIATE BOX)

CAPACITY: GALLONS PER MINUTE (TO NEAREST GALLON) 10

PUMP HORSE POWER 37

PUMP COLUMN LENGTH (NEAREST FOOT) 40

CASING HEIGHT (CIRCLE APPROPRIATE BOX AND ENTER CASING HEIGHT)

ABOVE ☒ BELOW ☒ LAND SURFACE 2 FEET

CIRCLE APPROPRIATE BOXES

☒ A WELL WAS ABANDONED AND SEALED WHEN THIS WELL WAS COMPLETED

☒ ELECTRIC LOG OBTAINED

☒ TEST WELL CONVERTED TO PRODUCTION WELL

REBY CERTIFY THAT I HAVE COMPLIED WITH ALL DIRECTIONS STATED ON THE ABOVE-CAPTIONED "PERMIT TO DRILL WELL", AND THAT INFORMATION CONTAINED IN THIS REPORT IS TRUE, ACCURATE, AND COMPLETE TO THE BEST OF MY KNOWLEDGE, INFORMATION AND OPINION.

LESS NAME Wright

DATE 10/10/60

TITLE Driller

LOCATION OF WELL ON LOT

SHOW PERMANENT STRUCTURE SUCH AS BUILDING, SEPTIC TANK, AND FOR OTHER LAND MARKS AND INDICATE NOT LESS THAN TWO DISTANCES MEASUREMENTS TO WELL.


Front lot line

50 ft

Right lot line



UNION CHAPEL ROAD

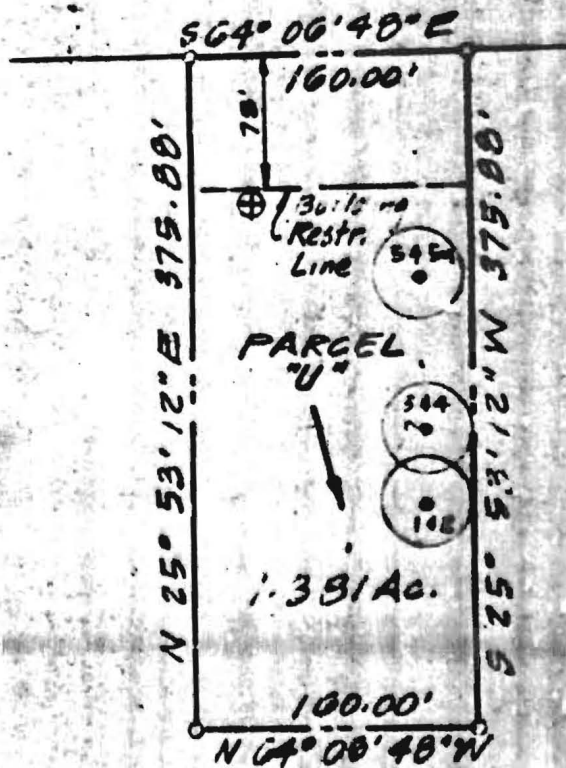

TEST NO.	DEPTH	TIME
1	4 1/2'	11 min.
2	10 1/2'	10 "
3	5'	7 "
4	11'	18 "
5	11'	7 "
5a	4'	5 "

LEGEND

- Core Hole Test
-  Sewage Disposal Area
- ⊕ Water Well



Robert A. Mahand
 ROBERT MAHAND
 No. 7560