

1750


MARYLAND STATE DEPARTMENT OF HEALTH

ELLCOTT CITY

DISTRICT 4th

DATE 10/31/72

THIS IS NOT A PERMIT

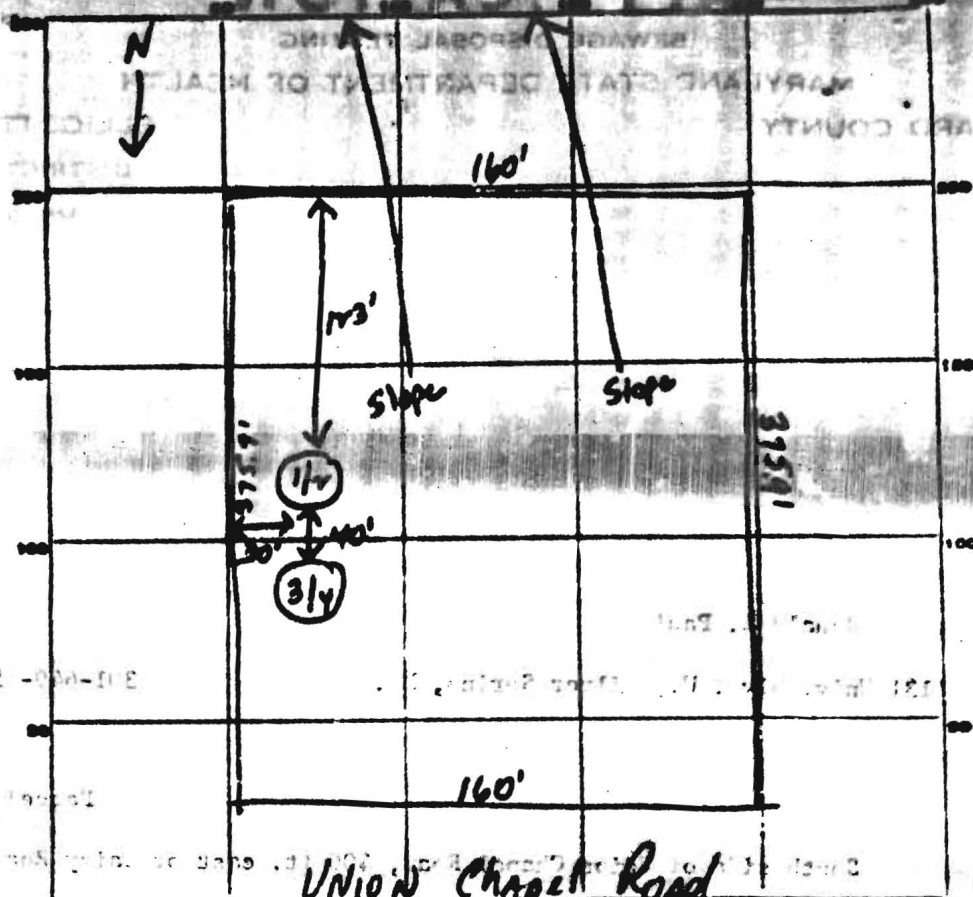

INDICATE NORTH. - NAME ADJOINING ROADWAY AS BASE LINE.

Parcel 4

DATE	TEST NO.	DEPTH	PRE-WET		TEST - 1" DROP		TIME
			START	STOP	START	STOP	
	1	4 1/4'	12:30	12:43	12:43	12:54	11 min
	2	10 1/4'	12:30	12:36	12:36	12:46	10 "
E	3	5'	12:33	12:38	12:38	12:45	7 "
	4	11'	12:34	12:44	12:44	1:10	18 "

SOIL AUGER FINDING

TESTED BY

REMARKS

APPLICATION

SEWAGE DISPOSAL TESTING

MARYLAND STATE DEPARTMENT OF HEALTH

HOWARD COUNTY *Septic Tank - 1000 gal - 3 bedrooms*
1250 gal - 4 "

ELLICOTT CITY

DISTRICT *4*

DATE *11/10/71*

*One Well - 110 sq. ft. absorbent material and
new bottom to begin below the
first 4 ft. of non porous mat. Maximum
depth permitted for dry well is 11 ft.
Install dry well 125 ft from front lot line
and 30 ft from left side line as seen
from Union Chapel Rd.*

TO THE COUNTY HEALTH OFFICER
ELLICOTT CITY, MARYLAND

I, HEREBY, APPLY FOR THE NECESSARY TESTS IN ORDER TO CONSTRUCT OR RECONSTRUCT A SEWAGE
DISPOSAL SYSTEM.

PROPERTY OWNER Daisy Hill, Joint Venture

ADDRESS 1131 Univ. Blvd. N., Silver Spring, MD PHONE 649-1506

PROPERTY LOCATION:

SUBDIVISION Daisy Hill Estates LOT NO. 6, Block A, Sec. Two

ROAD AND DESCRIPTION South side of Union Chapel Road, 330' east of Daisy Road

OCCUPANT None PHONE None

PERSON TO CONSTRUCT SYSTEM _____

ADDRESS _____ PHONE _____

SIZE OF LOT 60,141 sq. ft. TYPE BLDG. Three

IF NOT SINGLE RESIDENCE DESCRIBE _____

SIGNATURE OF APPLICANT Daisy Hill, Joint Venture, by Shirley R. Rantley Partner


APPROVED BY Robert Tuma FOR One Well DATE 11/2/73

REJECTED BY _____ FOR _____ DATE _____

HOLD PENDING FURTHER TESTS _____ DATE _____

REASONS FOR REJECTION OR HOLDING _____

THIS IS NOT A PERMIT

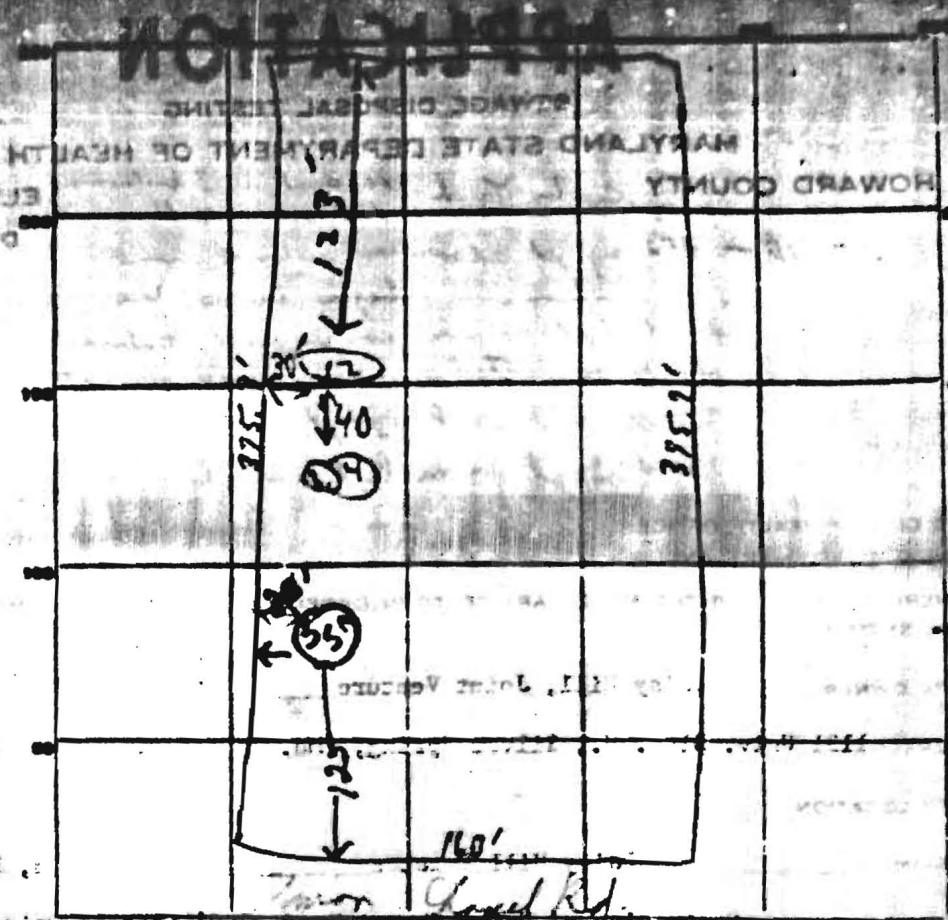

DATE	TEST NO.	DEPTH	PRE-WET		TEST - 1" DROP		TIME
			START	STOP	START	STOP	
4/1/72	1	4 1/2'	11:30	12:43	11:43	12:54	11
	2	10 1/2'	12:30	11:36	11:36	12:46	10
	3	5'	11:23	11:38	11:38	12:45	7
	4	11'	11:34	12:47	12:42	1:10	18
11/2/72	5	11 1/2'	11:46	11:51	11:51	11:58	7
	5A	4 1/2'	11:46	11:49	11:49	11:54	5

SOIL AUGER FINDING

TESTED BY

REMARKS

see below 3 & 4 for notes 11/2/72 5A

THIS IS NOT A PERMIT