

PUB. SEWER STATUS VERIFIED BY SRK N/A

ISSUE DATE: 3/12/03

APPROVAL DATE: 3/19/03

PERMIT
INDEXED

P 518568

A REPAIR

ON-SITE SEWAGE DISPOSAL SYSTEM
HOWARD COUNTY HEALTH DEPARTMENT
BUREAU OF ENVIRONMENTAL HEALTH

cell 410-952-4619

04-325079

Harrison Contractors, Inc.

IS PERMITTED TO INSTALL ☐ ALTER ☒

ADDRESS: _____ PHONE NUMBER: _____

SUBDIVISION: Daisy Hill Estates LOT NUMBER: 6

ADDRESS: 15890 Union Chapel Road PROPERTY OWNER: Robert Parrish

SEPTIC TANK CAPACITY (GALLONS): existing

PUMP CHAMBER CAPACITY (GALLONS): NA

NUMBER OF BEDROOMS: 6 (5 existing) 1 additional proposed

SQUARE FEET PER BEDROOM: NA Tie plumbing from new

LINEAR FEET OF TRENCH REQUIRED: NA addition into existing system
No increase in trenches.

TRENCHES:	Trench to be _____ feet wide. Inlet _____ feet below original grade. Bottom maximum depth _____ feet below original grade. Effective area begins at _____ feet below original grade. _____ feet of stone below distribution pipe.
LOCATION:	
PURPOSE:	In support of Building Permit Issued for bedroom addition approved on 10/16/2002.

PLANS APPROVED: Steven R. Krieg DATE: 3/19/03

NOTE: PERMIT VOID AFTER 2 YEARS

NOTE: CONTRACTOR RESPONSIBLE FOR SCHEDULING A PRE-CONSTRUCTION INSPECTION FOR ALL INSTALLATIONS

NOTE: WATERTIGHT SEPTIC TANKS REQUIRED

NOTE: ALL PARTS OF SEPTIC SYSTEM SHALL BE 100 FEET FROM ANY WATER WELL

NOTE: MANHOLE RISERS REQUIRED ON ALL SEPTIC TANKS AND PUMP CHAMBERS


**NEITHER THE HOWARD COUNTY COUNCIL NOR THE HEALTH DEPARTMENT IS
RESPONSIBLE FOR THE SUCCESSFUL OPERATION OF ANY SYSTEM
PERMITTEE RESPONSIBLE FOR OBTAINING FINAL APPROVAL ON THIS PERMIT
CALL 410-313-2640 FOR INSPECTION OF SEPTIC SYSTEM**

**BUILDING PERMIT SIGNED
AND RETURNED**

9/10/03 BOC 143929 PROPANE TANK

518568

NOT TO SCALE

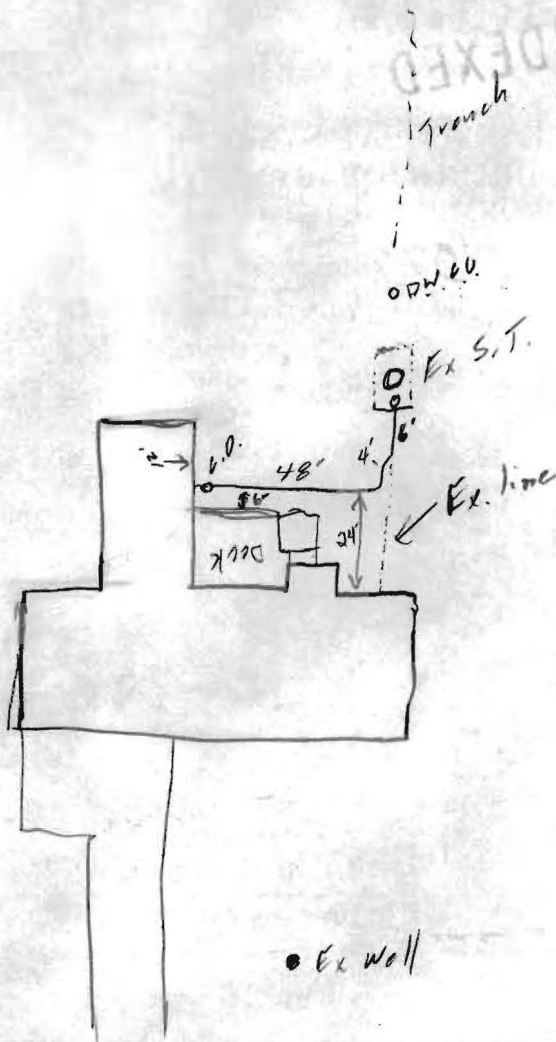

TRENCH/DRAINFIELD DATA		
WIDTH	INLET	BOTTOM
<u>Existing</u>		
NUMBER OF TRENCHES _____		
TOTAL LENGTH _____		
ABSORPTION AREA _____		
DISTRIBUTION BOX LEVEL _____		
DISTRIBUTION BOX BAFFLE _____		
DISTRIBUTION BOX PORT _____		

SEPTIC TANK DATA	
SEPTIC TANK 1 LEVEL	
CAPACITY	<u>EX 1250</u> GAL
SEAM LOC	<u>M.D</u>
TANK LID DEPTH	<u>2'</u>
BAFFLES	_____
BAFFLE FILTER	_____
MANHOLE LOC	_____
6" PORT LOC	_____
WATERTIGHT TEST	_____
SEPTIC TANK 2 LEVEL	
CAPACITY	_____ GAL
SEAM LOC	_____
TANK LID DEPTH	_____
BAFFLES	_____
BAFFLE FILTER	_____
MANHOLE LOC	_____
6" PORT LOC	_____
WATERTIGHT TEST	_____

PRE-CONSTRUCTION _____

INSTALLATION

3/19/03 OK to cover all work (SD)

FINAL INSPECTOR

[Signature]


DATE OF APPROVAL

3/19/03

BUILDING PERMIT SIGNED
AND RETURNED

9/10/03
 Proposed LP
 Tank OX
 (SQ)

Maryland State Archives

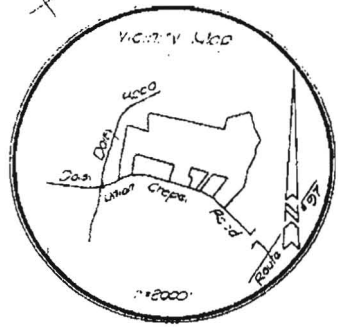

Total No. of Lots = 7
 Area of Lots = 179.9 Ac
 Total Area = 24634 Ac

Developer:
 American Builders and Developers
 Suite 215 - Warwick Towers
 1131 University Boulevard West
 Silver Spring, Maryland 20902

APPROVED: For Private Water and
 Private Sewage Systems, Howard County
 Health Department.


[Signature]
 County Health Officer Date

APPROVED: Howard County Office
 of Planning and Zoning.

[Signature] 1-5-77
 Director Date

APPROVED: For Storm Drainage
 Systems & Public Roads, Howard County
 Department of Public Works.

[Signature] 4/7/77
 Director Date

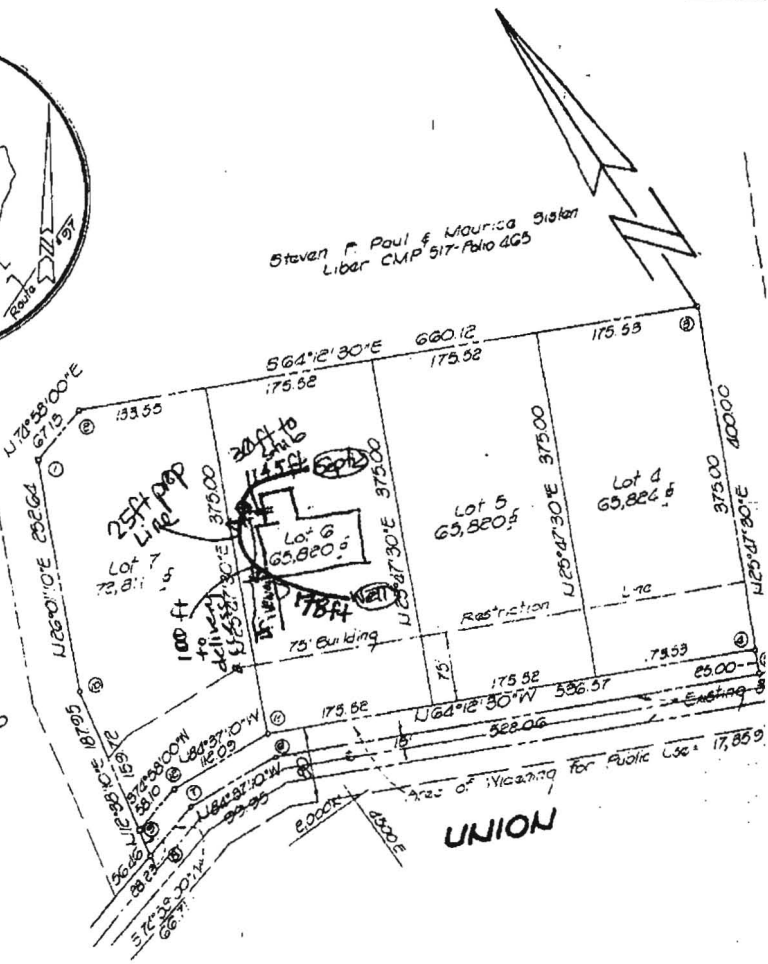

Note: The lots shown herein comply
 with minimum ownership width and lot area
 as required by the Regulations of the
 Maryland State Health Department.

• Denotes 6" Diameter Conc. Monument

COMPLETED	RAH
DRAWN	RAH
CHECKED	WFO

OWNERS' DEDICATION

We, Steven F. Paul & Maurice Sisten, owners of the property
 shown and described herein adopt this plan of subdivision and
 reserve the fee simple title to the beds of the streets or road
 herein and in consideration of the approval of the plat by the
 Office of Planning & Zoning grant unto Howard County, Maryland
 the right and option to acquire for the consideration of a
 Dollar the fee simple title to the beds of the streets shown
 herein within the period of five years from the date of
 recording of this plat among the Land Records of Howard
 County, Maryland.

November 19, 1979

[Signature]
 Witness

[Signature]
 Witness

[Signature]
 Witness

[Signature]
 Witness

[Signature]
 Steven F. Paul

[Signature]
 Maurice C. Paul

[Signature]
 Maurice Sisten

[Signature]
 Ann Sisten