

6/13/90 A.M. + P.M.  
6/18/90 8 AM  
6/12/90 11:00  
Noachon  
6/12 P.M. Visual hole only  
c.B.D.

6/13/90 (2) P.C.O. -  
c.B.D.

File

# PERMIT

SEWAGE DISPOSAL SYSTEM

MARYLAND STATE DEPARTMENT OF HEALTH

HOWARD COUNTY

BUREAU OF ENVIRONMENTAL HEALTH

461-9933

F 46038  
A 15387  
REPAIR

DISTRICT

DATE

DATE SYSTEM APPROVED

INSPECTOR

4/2/90  
6/18/90

c.B.D.

(410) 795-8691  
Harrison Contracting

IN Detexed

William T. Cumberland, III

IS PERMITTED TO INSTALL \_\_\_\_\_ ALTER X

ADDRESS 1820 Gillis Falls Road, Woodbine, Maryland 21797 PHONE 489-4457

SUBDIVISION Daisy Hill Estates ROAD 15890 Union Chapel Rd LOT 6

PROPERTY OWNER Robert Parish

ADDRESS 15890 Union Chapel Road  
Woodbine, Maryland 21797

IF GARBAGE GRINDER IS USED INCREASE SEPTIC TANK CAPACITY BY 50% AND ABSORPTION AREA BY 22%

GARBAGE GRINDER? YES ~~XXXXXXXXXXXX~~ NO ~~XXXXXX~~

SEPTIC TANK CAPACITY 1500 GALLONS NUMBER OF BEDROOMS 5

REPAIR - CALL FOR INSPECTION WHEN GROUND IS OPENED SO SANITARIAN CAN RECOMMEND REPAIR.

6/12/90 Visual hole - ok for deep trench.  
See Remarks of 9/13/74 initial installation for  
specs of repair.

{ C.B.D. }  
for

PLANS APPROVED BY C. Williams DATE 6/08/90

COVER NO WORK UNTIL INSPECTED AND APPROVED

NEITHER THE HOWARD COUNTY COUNCIL NOR THE HEALTH DEPARTMENT IS RESPONSIBLE FOR THE SUCCESSFUL OPERATION OF ANY SYSTEM

NOTE: CLEANOUT REQUIRED EVERY 70 FEET OF SEWER LINE AND/OR AT 90° SWEEPS IN LINES FROM HOUSE TO DRAIN FIELDS

NOTE: ALL PARTS OF SEPTIC SYSTEMS (I.E. TANK, DISTRIBUTION BOX, TRENCHES) TO BE 100 FEET FROM WELL (UNLESS OTHERWISE SPECIFICALLY AUTHORIZED)

NOTE: IF DEEP TRENCH(IES) ARE USED CALL FOR INSPECTION BEFORE AND AFTER PLACING GRAVEL IN TRENCH(IES)

NOTE: NO DRY WELL SHALL EXCEED 15 FOOT IN DIAMETER NO ABSORPTION TRENCH TO EXCEED 100 FEET IN LENGTH

NOTE: ALL PIPE FROM HOUSE TO SEPTIC TANK MUST BE CAST IRON OR SCHEDULE 40 PVC OR ABS

PERMIT VOID AFTER TWO YEARS

NOTE: INSTALL STAND PIPE ON SEPTIC TANK AND DRY WELL. STAND PIPES MUST BE 6 INCHES IN DIAMETER. CAST IRON, CONCRETE OR TERRA COTTA OR PVC OR ABS ACCEPTED. IF TOP OF SEPTIC TANK IS DEEPER THAN 3 FEET, MANHOLE TO GRADE REQUIRED

NOTE: DISTRIBUTION BOXES MUST HAVE BAFFLES


**BUILDING PERMIT SIGNED  
AND RETURNED**

10/16/2002 B00138884 BEDROOM,  
BATH & CRAWL SPACE

**\*INSTALLER IS RESPONSIBLE FOR OBTAINING FINAL APPROVAL ON THIS PERMIT**

**\*CALL 461-9933 FOR INSPECTION OF SEPTIC SYSTEMS.**

46038

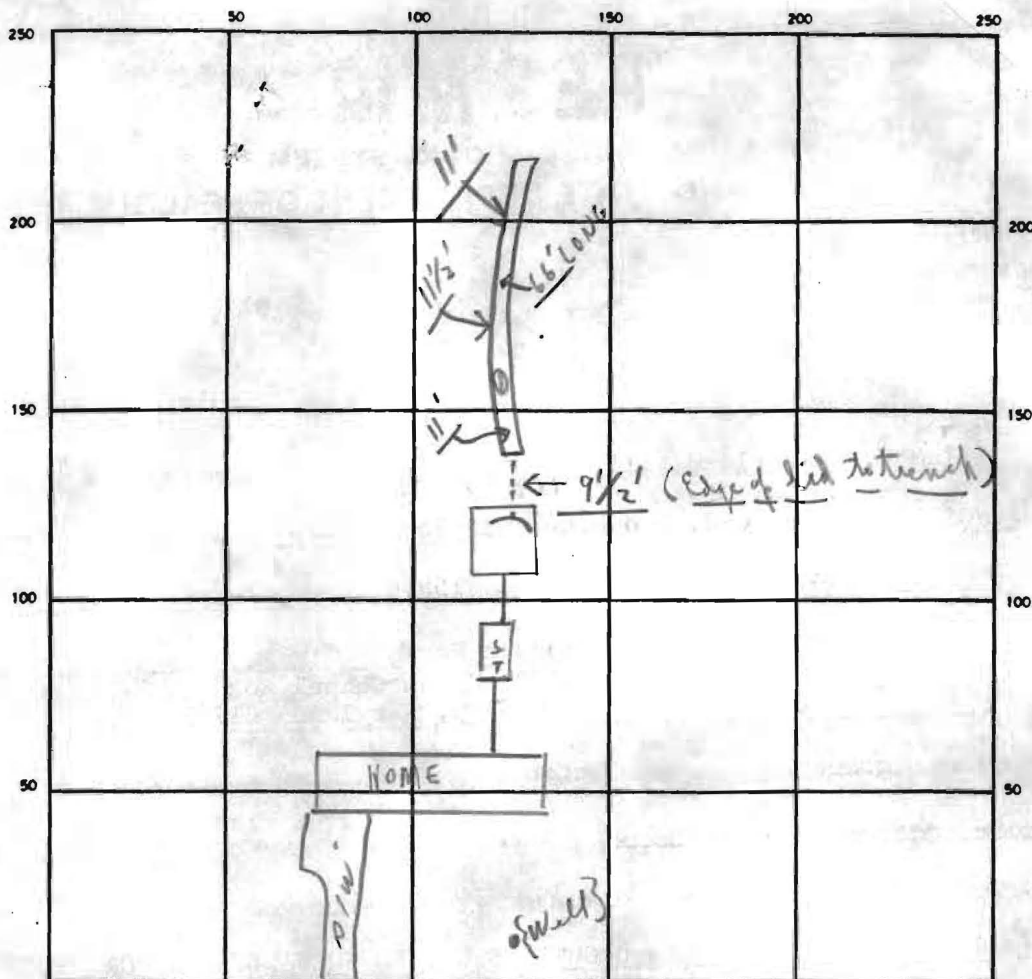

INDICATE NORTH — NAME ADJOINING ROADWAY AS BASE LINE

Union Chapel Road

D.W. Needs ONE 6/13

SEPTIC TANK. LEVEL Existing CLEANOUTS Existing  
 DISTRIBUTION BOX. LEVEL (Using dry well)  
 DRAIN FIELD/TILE FIELD. DEPTH 11 + FT. TRENCH WIDTH 2 FT. INLET DEPTH 4 FT.  
 EFFECTIVE GRAVEL DEPTH 7 + FT. TOTAL LENGTH 66 FT.  
 NUMBER OF TRENCHES 1 ONE SIDEWALL/BOTTOM AREA 462 SQ. FT.  
 DRYWELL INSIDE DIAMETER 2 + FT. EFFECTIVE DEPTH BELOW INLET 2 + FT.  
 ABSORBENT AREA 2 + SQ. FT.

REMARKS 6/12/90 P.M. - Visual hole only. HOLD for a call.  
6/13/90 Trench ok for stone in A.M. P.M. - partial no charge  
equipment as in A.M. HOLD FOR A CALL ON 6/18/90; 6/18/90  
Final - after putting a dry well plug on cleanout and  
paper around drywell opening where pipe goes to  
trench - ok to cover as finish.

DATE SYSTEM APPROVED 6/18/90 INSPECTOR Charles Bryan Thack