


LOT 6 Daisy Hill Estates
65,820 sq ft
15890 Union Chapel Rd Woodbridge, MD 21797

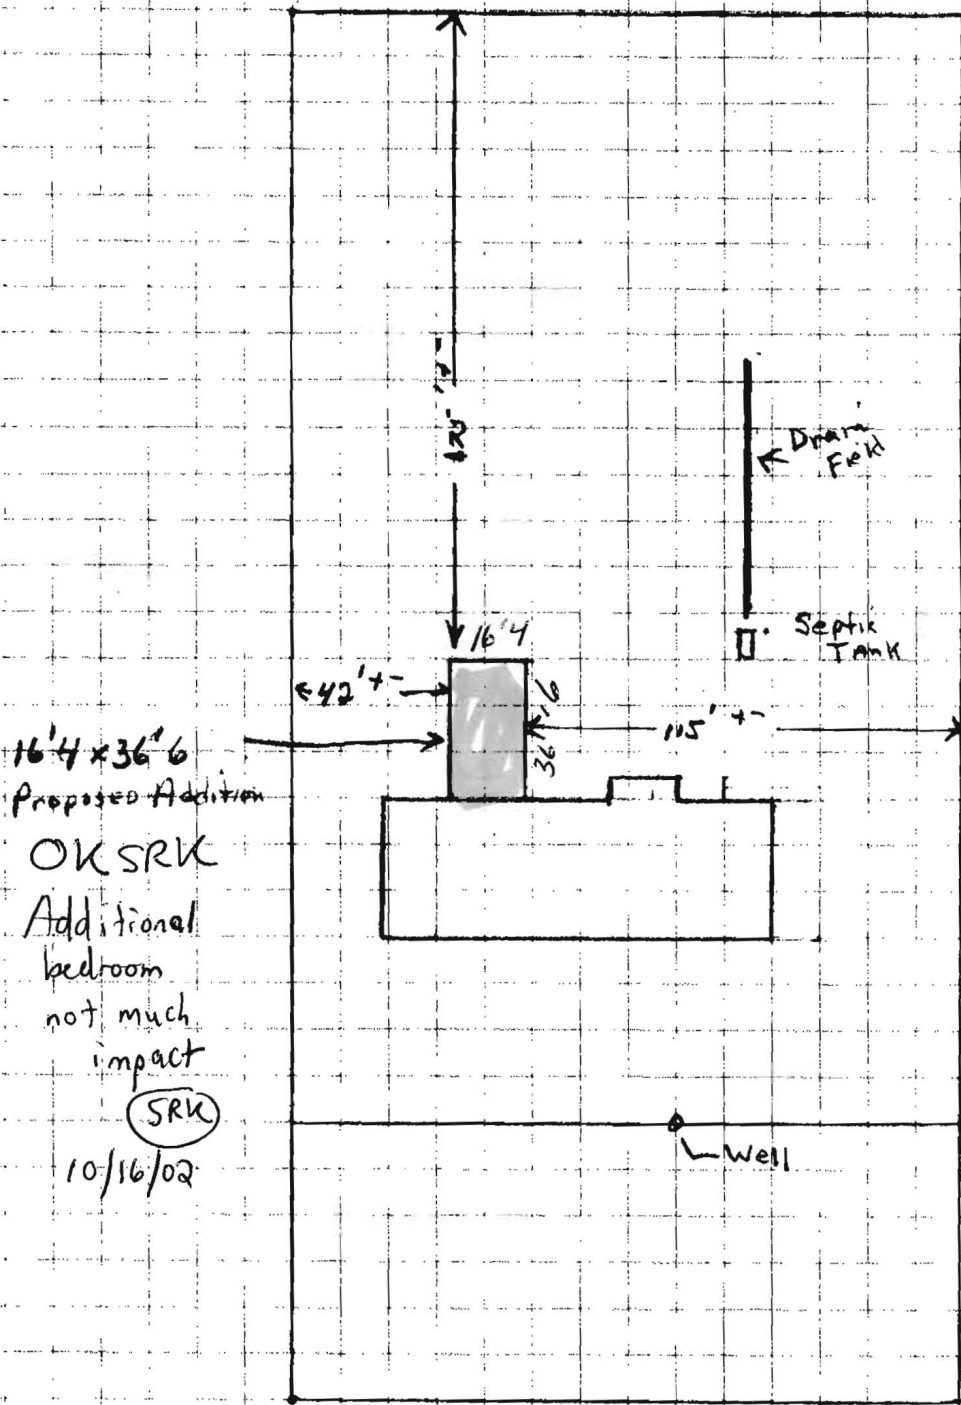

16'4" x 36'6"
Proposed Addition

OK SRK


Additional
bedroom
not much
impact

(SRK)

10/16/02

Union Chapel Rd

Scale 1" = 50'

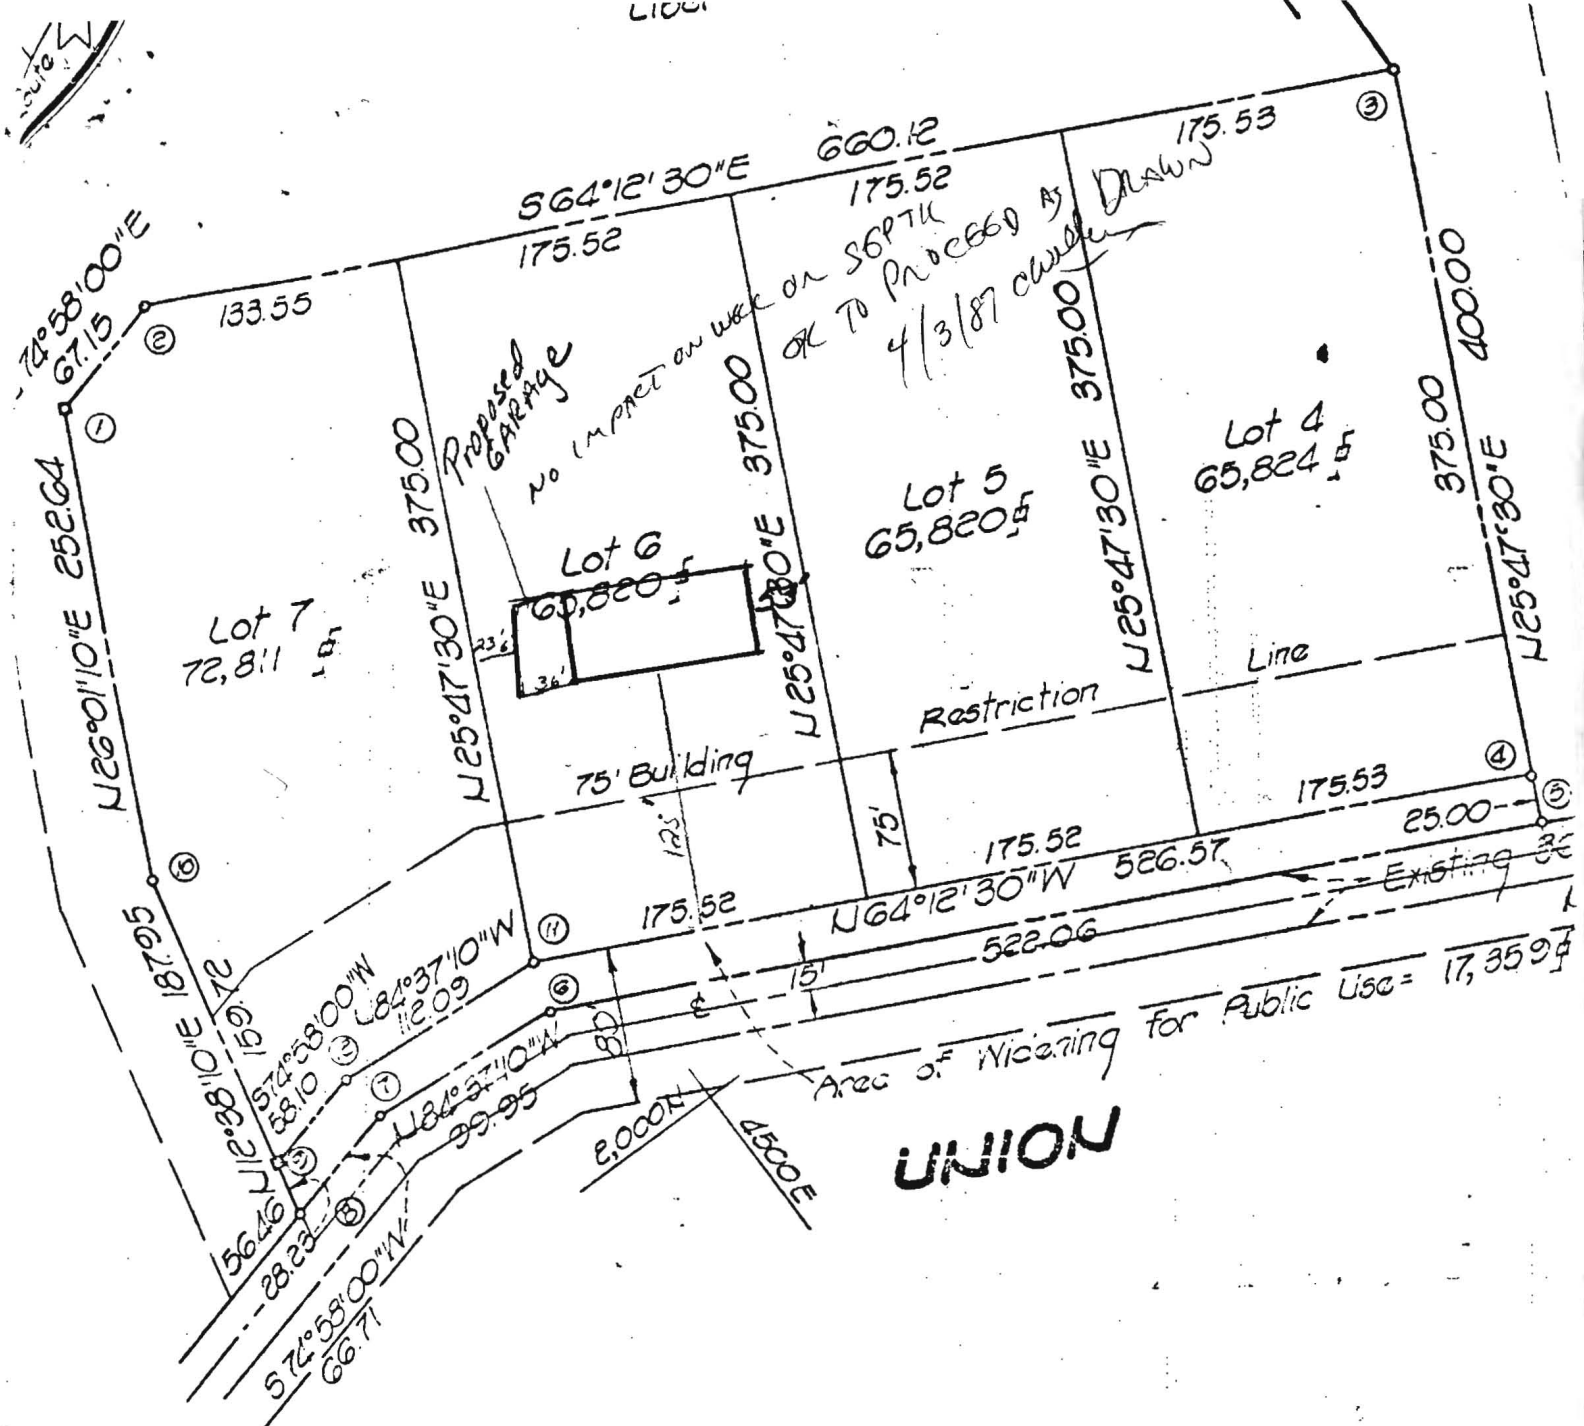

Note: The lots shown hereon comply with minimum ownership width and lot area as required by the Regulations of the Maryland State Health Department.

□ Denotes 6" Diameter Conc. Monument.

Developers
West
20902

COMPUTED	RAH
DRAWN	RAH
CHECKED	WFG

Water and
Howard County

OWNERS' DEDICATION

We, Steven F. Paul & Maurice Sisen, owners of the property shown and described hereon adopt this plan of subdivision and reserve the fee simple title to the beds of the streets/or roads hereon and in consideration of the approval of the plat by the