

APPLICATION

SEWAGE DISPOSAL TESTING

A 15586

P _____

MARYLAND STATE DEPARTMENT OF HEALTH

HOWARD COUNTY Septic tank to be 1000 gallons ELLICOTT CITY

DISTRICT 4th

DATE Oct. 14, 1970

Dry well to be 300 sq ft of asphalt sidewalk
area below the inlet pipe maximum depth of dry well
to be 9 1/2 ft below original grade. Inlet pipe to be 3 ft
below original grade. Locate system 190 ft from front property
line and 69 ft from right side line as lot is situated on
Union Chapel Rd facing lot.

TO: THE COUNTY HEALTH OFFICER
ELLICOTT CITY, MARYLAND

I, HEREBY, APPLY FOR THE NECESSARY TESTS IN ORDER TO CONSTRUCT (OR RECONSTRUCT) A SEWAGE DISPOSAL SYSTEM.

PROPERTY OWNER Steven F. Paul et al.

ADDRESS 1131 Univ. Blvd., W., #215, Silver Spring, MD 20902 PHONE 649-1500

PROPERTY LOCATION:

SUBDIVISION Daisy Hill Estates LOT NO. Six

ROAD AND DESCRIPTION Union Chapel Road, 350' east of Daisy Road

OCCUPANT NONE

PHONE _____

PERSON TO CONSTRUCT SYSTEM _____

ADDRESS _____

PHONE _____

SIZE OF LOT 65,625 sq. ft.

TYPE BLDG. Three

NUMBER OF BEDROOMS _____

IF NOT SINGLE RESIDENCE DESCRIBE _____

SIGNATURE OF APPLICANT Steven F. Paul

APPROVED BY James T. Wright

FOR

(KIND OF SYSTEM)

DATE

10/29/70

REJECTED BY _____

FOR

(KIND OF SYSTEM)

DATE _____

HOLD PENDING FURTHER TESTS _____

DATE _____

REASONS FOR REJECTION OR HOLDING _____


THIS IS NOT A PERMIT

REMARKS

Lot #6 Daisy Hill Estates
Platbook 21 Folio 34

Elev. at time of Perc. Test ————— 36"
 Elev. where house Sewer leaves Found. Wall → 21"
 Elev. of Sewer at entry to Septic tank → 14"
 Elev. of Sewer at entry to Dry Well → 0"
 Elev. of Water Supply —————→ 46"

Robert Partridge
3/10/74

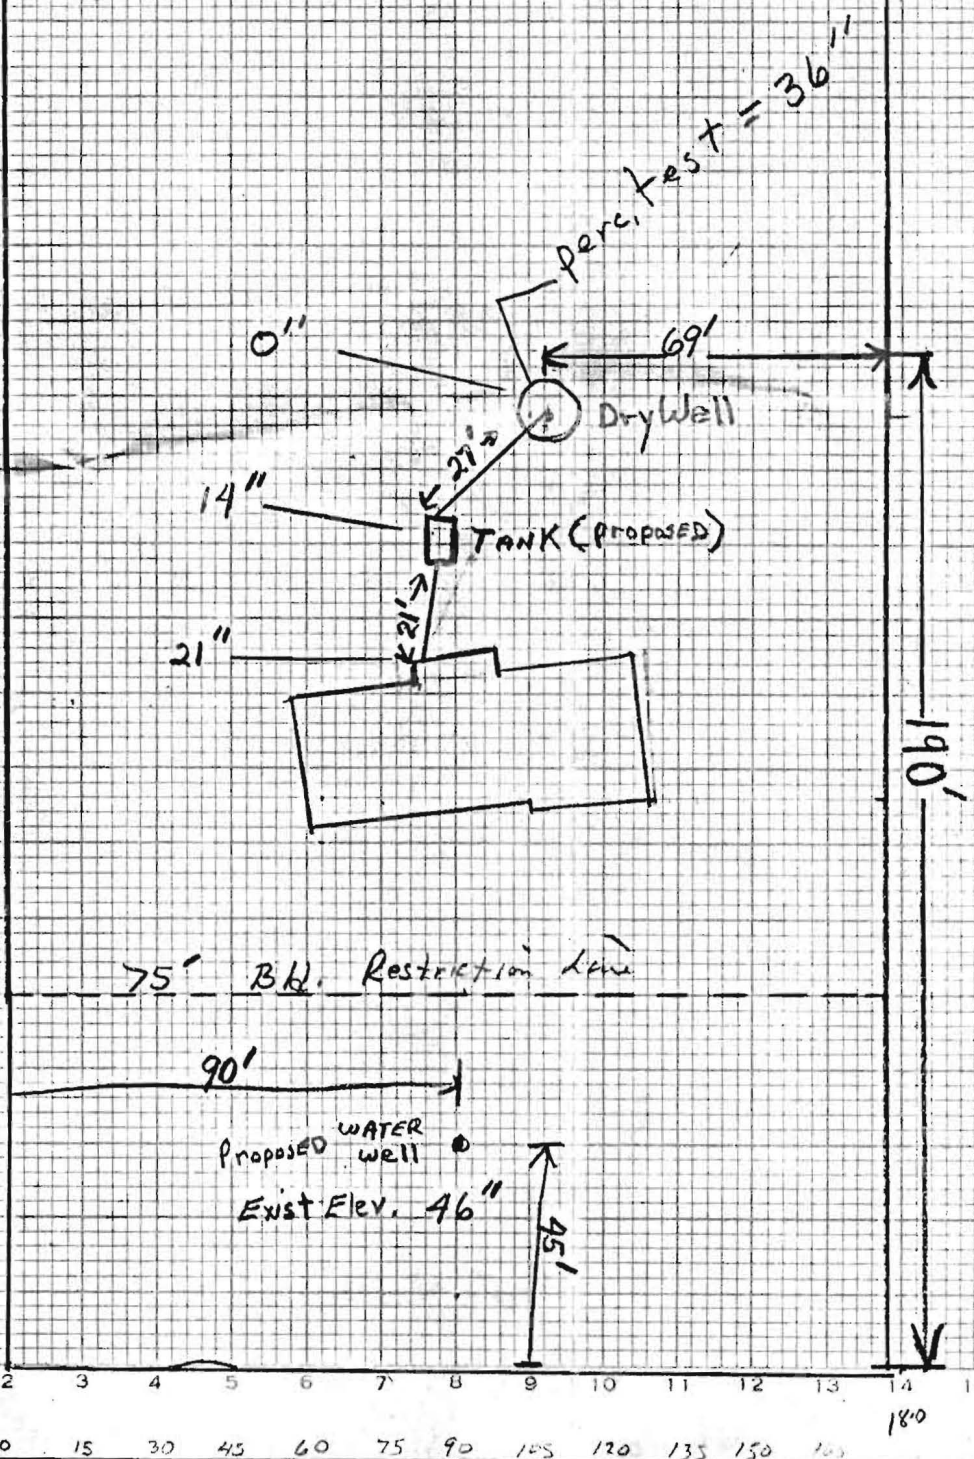

I Certify the above Measurements and Elev. Differences
are actual and Correct for this property, Signed