

APPLICATION

A 14991

P _____

SEWAGE DISPOSAL TESTING

MARYLAND STATE DEPARTMENT OF HEALTH

HOWARD COUNTY

ELLICOTT CITY

*3 BED ROOMS**4 BED ROOMS*DISTRICT 3*1000 Gal Tank**1250 Gal Tank*DATE 12/1/69*Dry Well 300 sq ft sidewalk area below Top 5 FT clay with max depth of 14 FT**Dry Well 400 sq ft sidewalk area below Top 5 FT Clay with max depth of 14 FT*TO: THE COUNTY HEALTH OFFICER
ELLICOTT CITY, MARYLAND

I, HEREBY, APPLY FOR THE NECESSARY TESTS IN ORDER TO CONSTRUCT (OR RECONSTRUCT) A SEWAGE DISPOSAL SYSTEM.

PROPERTY OWNER

Elmer J. Brown

ADDRESS

13335 Triadelphia Road, Rt. 2, Ellicott City, Md.

PHONE

286-2896

PROPERTY LOCATION:

SUBDIVISION

LOT NO.

ROAD AND DESCRIPTION

beside 13335 Triadelphia Rd. nr. Shepherd's Glen number on mail box

OCCUPANT

PHONE

PERSON TO CONSTRUCT SYSTEM

ADDRESS

PHONE

SIZE OF LOT

4.25 acres

TYPE BLDG.

3 or 4

NUMBER OF BEDROOMS

IF NOT SINGLE RESIDENCE DESCRIBE

SIGNATURE OF APPLICANT

Florence C. Brown

APPROVED BY

FOR

DATE

(KIND OF SYSTEM)

REJECTED BY

FOR

DATE

(KIND OF SYSTEM)

HOLD PENDING FURTHER TESTS


DATE

4 DEC 69

REASONS FOR REJECTION OR HOLDING

4 DEC 69 - Hold for final Plat

THIS IS NOT A PERMIT

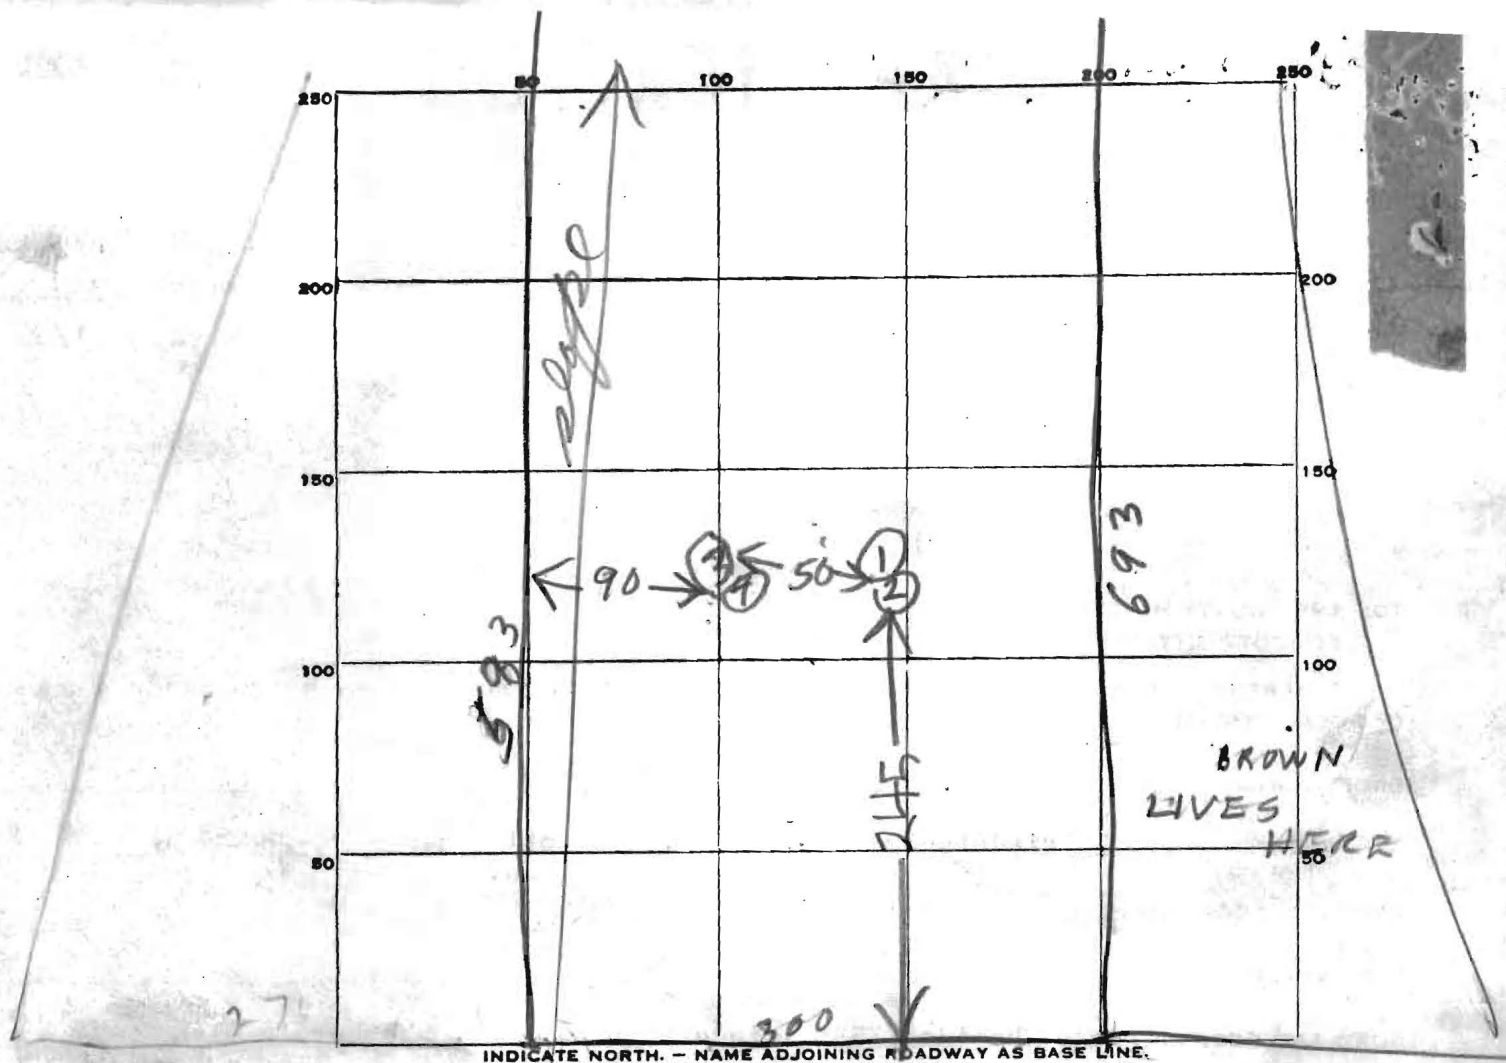

TRIDELPHIA RD

	DATE	TEST NO.	DEPTH	PRE-WET		TEST - 1" DROP		TIME
				START	STOP	START	STOP	
TOP 6' CLAY BOT 4' SAND	12/4/69	1	10	940	944	944	947	3
		2	5	940	1000	little pers		
TOP 5' CLAY BOT 4' SAND		3	10	945	946	945	948	2
		4	6	945	951	951	958	7

SOIL AUGER FINDING

TESTED BY

REMARKS

APPLICATION

SEWAGE DISPOSAL TESTING

MARYLAND STATE DEPARTMENT OF HEALTH

HOWARD COUNTY

ELLICOTT CITY

DISTRICT 3

DATE 12/1/69

TO: THE COUNTY HEALTH OFFICER
ELLICOTT CITY, MARYLAND

I, HEREBY, APPLY FOR THE NECESSARY TESTS IN ORDER TO CONSTRUCT (OR RECONSTRUCT) A SEWAGE DISPOSAL SYSTEM.

PROPERTY OWNER Elmer J. Brown

ADDRESS 13335 Triadelphia Road, Rt. 2, Ellicott PHONE 286-2096
City, Md.

PROPERTY LOCATION:

SUBDIVISION _____ LOT NO. _____

ROAD AND DESCRIPTION beside 13335 Triadelphia Rd. nr. Shepherd's Glen
number on mail box

OCCUPANT _____ PHONE _____

PERSON TO CONSTRUCT SYSTEM _____

ADDRESS _____ PHONE _____

SIZE OF LOT 4.25 acres TYPE BLDG. 3 or 4
NUMBER OF BEDROOMS

IF NOT SINGLE RESIDENCE DESCRIBE _____

SIGNATURE OF APPLICANT Florence C. Brown

APPROVED BY _____ FOR _____ DATE _____

(KIND OF SYSTEM)

REJECTED BY _____ FOR _____ DATE _____

(KIND OF SYSTEM)

HOLD PENDING FURTHER TESTS BH DATE 4 DEC 69


REASONS FOR REJECTION OR HOLDING 4 DEC 69 - Hold for final Plat

THIS IS NOT A PERMIT

12/16/69

Review of Final
Plat

Plat does
not have
place for
Dr Shrop
to sign let R/R
but holes are
not affected

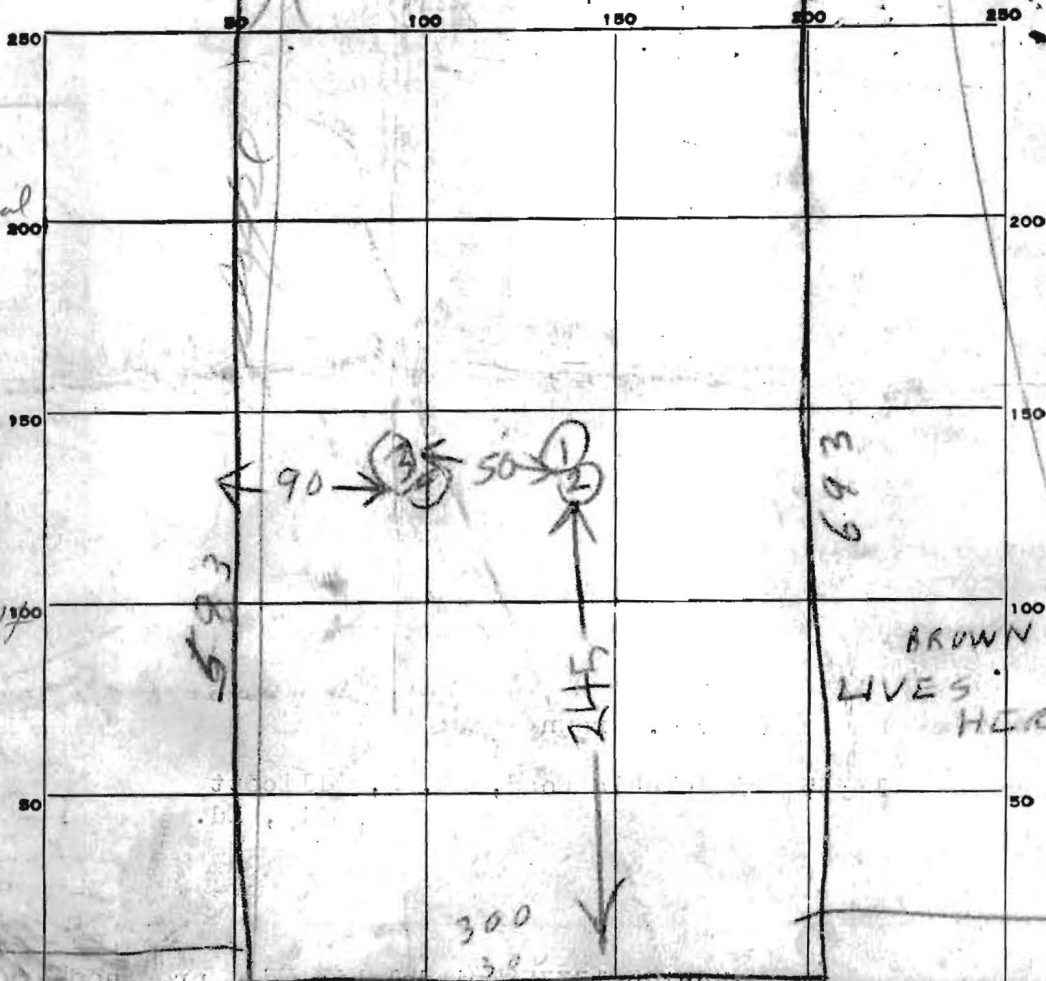

INDICATE NORTH - NAME ADJOINING ROADWAY AS BASE LINE.

TOP 6' CLAY

BOT. 4' SAND

TOP 5' CLAY

BOT 4' SAND

DATE	TEST NO.	DEPTH	PRE-WET		TEST - 1" DROP		TIME
			START	STOP	START	STOP	
12/4/69	1	10	940	944	944	947	3
	2	5	940	1000	little per		
	3	10	945	946	946	948	2
	4	6	945	951	951	958	7

SOIL AUGER FINDING _____

TESTED BY _____

REMARKS _____

ROAD

BROWN
L. 556 F. 748
1.714 AC.
04/30/1971

BROWN
L. 556 F. 748
SAVING & EXCEPTING
5.014 AC.
04/30/1971

ALBERT J. KAPPE'S PROPERTY
LOTS 1 & 2
PLAT NO. 4253

MAP OF SHEPHERD'S GLEN
PLAT BOOK 10 PAGE 37

ZELLER PROPERTY
LOTS 1 THRU 3
PLAT 9496

10/20/04
House located
asper B.P. plan.
BB