



# APPLICATION

## FOR PERCOLATION TESTING AND SITE EVALUATION

TEST DATE(S) \_\_\_\_\_ TEST TIME \_\_\_\_\_ *AP 520022*

AGENCY REVIEW: \_\_\_\_\_ DATE *1/8/2004*

DO NOT WRITE ABOVE THIS LINE

I HEREBY APPLY FOR THE NECESSARY TESTING/EVALUATION PRIOR TO ISSUANCE OF SEWAGE DISPOSAL SYSTEM PERMIT(S) TO:

CHECK AS NEEDED:

- CONSTRUCT NEW SEPTIC SYSTEM(S)
- REPAIR/ADD TO AN EXISTING SEPTIC SYSTEM
- REPLACE AN EXISTING SEPTIC SYSTEM

CHECK AS NEEDED:

- NEW STRUCTURE(S)
- ADDITION TO AN EXISTING STRUCTURE
- REPLACE AN EXISTING STRUCTURE

CHECK ONE:

- CREATE NEW LOT(S)
- BUILD ON AN EXISTING LOT IN A SUBDIVISION
- BUILD ON AN EXISTING PARCEL OF RECORD

IS THE PROPERTY WITHIN 2500' OF ANY RESERVOIR?

- YES
- NO

THE TYPE OF STRUCTURE IS:

- RESIDENTIAL WITH \_\_\_\_\_ PROPOSED BEDROOMS IN THE COMPLETED STRUCTURE (NOTE *UNKNOWN* IF APPROPRIATE)
- COMMERCIAL (PROVIDE DETAIL OF NUMBERS AND TYPES OF EMPLOYEES/ CUSTOMERS ON ACCOMPANYING PLAN)
- INSTITUTIONAL/GOVERNMENT (PROVIDE DETAIL OF NUMBERS AND TYPES OF EMPLOYEES/USERS ON ACCOMPANYING PLAN)

PROPERTY OWNER(S) Rudy and Lorraine Marshall

DAYTIME PHONE (Rudy) 443-259-8000 CELL Beeper 410-748-4964 FAX \_\_\_\_\_

MAILING ADDRESS 9088 Lambskin Lane Columbia MD 21045  
STREET CITY/TOWN STATE ZIP

APPLICANT Omega Construction

DAYTIME PHONE 443-864-0582 CELL same FAX 410-997-4771

MAILING ADDRESS PO Box 1229 Sykesville MD 21784  
STREET CITY/TOWN STATE ZIP

APPLICANT'S ROLE: DEVELOPER  BUILDER BUYER RELATIVE/FRIEND REALTOR CONSULTANT

PROPERTY LOCATION  
SUBDIVISION/PROPERTY NAME Braeburn II LOT NO. 31

PROPERTY ADDRESS 6440 Lochridge Rd, Columbia 21044  
STREET TOWN/POST OFFICE

TAX MAP PAGE(S) 35 GRID 110 PARCEL(S) 246 PROPOSED LOT SIZE N/C

AS APPLICANT, I UNDERSTAND THE FOLLOWING: THE SYSTEM INSTALLED SUBSEQUENT TO THIS APPLICATION IS ACCEPTABLE ONLY UNTIL PUBLIC SEWERAGE IS AVAILABLE. THIS APPLICATION IS COMPLETE WHEN ALL APPLICABLE FEES AND A SUITABLE SITE PLAN HAVE BEEN RECEIVED. I ACCEPT THE RESPONSIBILITY FOR COMPLIANCE WITH ALL M.O.S.H.A. AND "MISS UTILITY" REQUIREMENTS. APPROVAL IS BASED UPON SATISFACTORY REVIEW OF A PERC CERTIFICATION PLAN.

TEST RESULTS WILL BE MAILED TO APPLICANT. \_\_\_\_\_  
SIGNATURE OF APPLICANT

HOWARD COUNTY HEALTH DEPARTMENT, BUREAU OF ENVIRONMENTAL HEALTH, WELL AND SEPTIC PROGRAM  
3525-H ELLICOTT MILLS DRIVE, ELLICOTT CITY, MARYLAND 21043-4544 (410) 313-1771 FAX (410) 313-2648  
TDD (410) 313-2323 TOLL FREE 1-877-4MD-DHMH

A/P \_\_\_\_\_

DATE	TEST #	DEPTH	START	BREAK 1" DROP	STOP 2" DROP	TIME OF 2nd INCH	P/F/H

REMARKS \_\_\_\_\_


SANITARIAN \_\_\_\_\_ BACKHOE \_\_\_\_\_ OTHERS \_\_\_\_\_

TEST HOLES USED IN SDA \_\_\_\_\_ AVG. PERC TIME \_\_\_\_\_ SQ. FT/BR \_\_\_\_\_

TRENCH WIDTH \_\_\_\_\_ INLET DEPTH \_\_\_\_\_ MAX. BOT DEPTH \_\_\_\_\_ EFFECTIVE SW \_\_\_\_\_

1/16/04 MTG W/FRED NUTTLE (BLDR)  
 SDA, TOPO, TEST HOLES ADDED AS SHOWN  
 HE WILL ADD EX. WELL 227.67  
 S.S. & ADJ. S.S.

- ① EX. WELL, SEPTIC
- ③ ADJ WELLS/SEPTICS

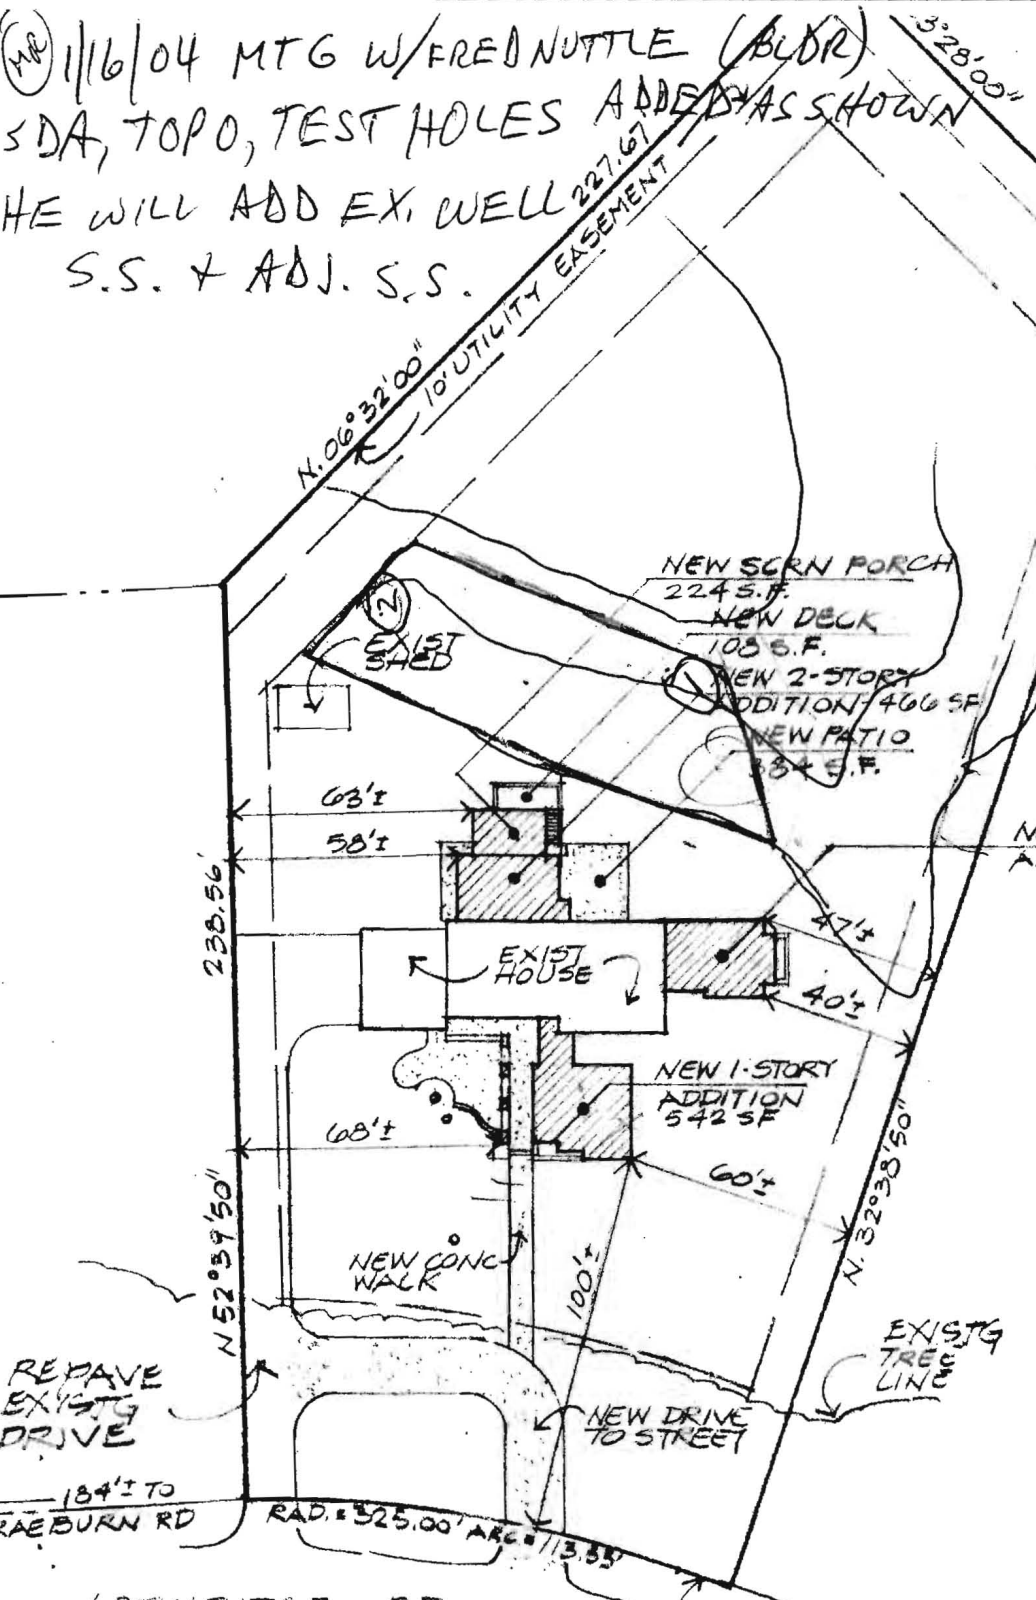

No plan  
 No 1-5 BR HOUSE  
 7/29/04

NEW 2-STORY ADDITION-196 S.F.

1-5 BR HOUSE @ COMPLETION

ADDITIONS & ALTERATIONS  
 TO THE RESIDENCE OF:  
LORRAINE & RUDY MARSHALL  
 6440 LOCHRIDGE RD.  
 COLUMBIA, MD 21044-4033

LOT 31 SECTION 2 BRAEBURN  
 5TH ELECTION DISTRICT  
 SIMPSONVILLE, MD


CLAUDE SKINNER - SURVEYOR

ANDRE' G FONTAINE, ARCHITECT

(410) 531-3925

*Penny E. Borenstein, M.D., M.P.H., Health Officer*

**F A X**

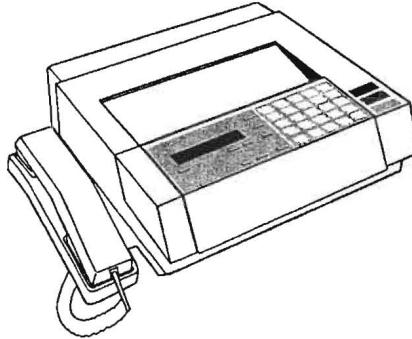

Date 1-5-04  
To FRED NUTTLE  
Department Omega Construction  
FAX # 410-997-4771

From Stephanie

Telephone 410-313-1771 FAX (410) 313-2648

# Of Pages 2 (including cover page)

Comments RE: PERC Application for 6440 LOCKRIDGE RD  
PERC APP = \$ 22500  
SEPTIC PERMIT = \$ 180.00

**CONFIDENTIALITY NOTICE**

**"WARNING: UNAUTHORIZED INTERCEPTION OF THIS TELEPHONIC COMMUNICATION COULD BE A VIOLATION OF FEDERAL AND MARYLAND LAW"**

The documents accompanying this telecopy transmission contain confidential information belonging to the sender which is legally privileged. The information is intended only for the use of the individual or entity named above. If you are not the intended recipient, you are hereby notified that any discourse, copying, distribution or the taking of any action in reliance on the contents of this telephonic information is strictly prohibited. If you have received this telecopy in error, please immediately notify sender by telephone to arrange for return of the original documents to us.

**Date:** Monday, January 05, 2004

**To:** HOWARD COUNTY HEALTH DEPARTMENT  
BUREAU OF ENVIRONMENTAL HEALTH  
**Phone:** (410) 313-1771  
**Fax:** (410) 313-2648

**From:** Omega Construction  
Fred Nuttle  
**Phone:** 443-864-0582  
**Fax:** 410-997-4771

**Pages:** 1

**Subject:** perk test

I would like to have a perk test done for a residence: - ADDING 2 BATHROOMS + 2 BEDROOMS

6440 Lochridge Road  
Columbia, MD 21044

*SYSTEM UPGRADE*

The owners names are Rudy and Lorraine Marshall.

*1/5/04 - INFORMED*

Please call me at your earliest convenience to arrange for this to be done. Mr. Nuttle of

Please advise on cost and schedule. The homeowner will pay you with a check. fees +  
process.

Thank you very much.

Fred Nuttle  
Omega Construction  
443-864-0582

*Stef*

**Date:** Tuesday, January 06, 2004

**To:** HOWARD COUNTY HEALTH DEPARTMENT  
BUREAU OF ENVIRONMENTAL HEALTH  
Phone: (410) 313-1771  
Fax: (410) 313-2648

**From:** Omega Construction  
Fred Nuttle  
Phone: 443-864-0582  
Fax: 410-997-4771

**Pages:** 2

**Subject:** application for Perk Test

Attached is the application for a Perk test to be done at:

6440 Lockridge Road  
Columbia, MD 21044

I would like this done at the earliest time possible as we are about to sign a building contract for home improvements including the addition of two bathrooms and three bedrooms.

Call me any time to schedule and to acknowledge receipt of this application.

Thanks

Fred Nuttle

1/15/04 T/C: W/FRED NUTTLE  
MR NEED ADD'L PLAN DETAIL; MTG FOR 1/16 @ 1:00