

2-6-62

PERMIT

app. rec'd 5/26/63
advised

P 05853
A 05230
06443
A 58905-K

SEWAGE DISPOSAL SYSTEM

MARYLAND STATE DEPARTMENT OF HEALTH

HOWARD COUNTY

ELLICOTT CITY

DISTRICT

DATE 10/1/62

INDEXED

INDEXED

10/1/62
Rudis
W. H. H. H.

Souder Bldg.

IS PERMITTED TO INSTALL ALTER

ADDRESS

PHONE

A SEWAGE DISPOSAL SYSTEM LOCATED AT

Underwood Rd - 1/2 mile from Forsythe Rd - on right going north

SUBDIVISION

ROAD

LOT

PROPERTY OWNER

Rolland A. Hollis, Jr.

ADDRESS

SPECIFICATIONS

DRAIN FIELD _____ DEPTH _____ FEET, BOTTOM AREA _____ SQ. FT.

SEEPAGE PITS 1 ABSORBENT SIDE-WALL AREA 10' X 10' deep below inlet

SEPTIC TANK CAPACITY 750 GALLONS

FOR GARBAGE GRINDER, INCREASE DISPOSAL AREA 22% & TANK CAPACITY 50%.

OTHER

Locate dry well 100 ft. from front property line which is parallel to Underwood Rd and 80 ft. from the right side property line (determined when facing lot from Underwood Rd) First 3 feet of original ground not to be counted as sidewall area.

PLANS APPROVED BY

J. E. Henningan


DATE

6/1/62

FILL SEPTIC TANK AND DISTRIBUTION BOX WITH WATER BEFORE CALLING FOR AN INSPECTION. COVER NO WORK UNTIL INSPECTED AND APPROVED.

NEITHER THE HOWARD COUNTY COMMISSIONERS NOR THE HEALTH DEPARTMENT IS RESPONSIBLE FOR THE SUCCESSFUL OPERATION OF ANY SYSTEM.

A 58905
A 06443

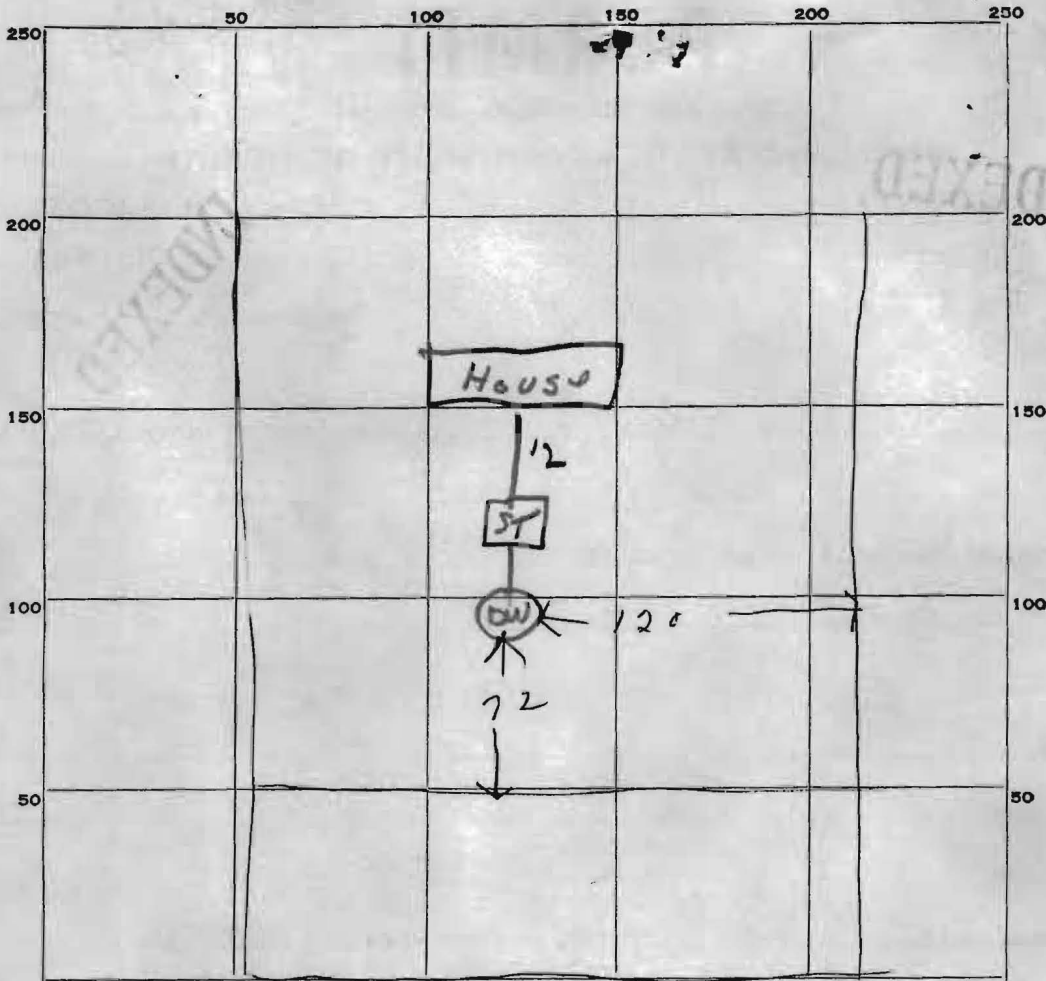

3.14
25.12

INDICATE NORTH. - NAME ADJOINING ROADWAY AS BASE LINE.

Underwood Rd

PERMIT CARD _____

SEPTIC TANK, LEVEL ✓ CLEANOUTS _____

DISTRIBUTION BOX, LEVEL _____

TILE FIELD, DEPTH _____ FT. TRENCH WIDTH _____ FT.

GRAVEL DEPTH _____ IN. TOTAL LENGTH _____ FT.

NUMBER OF TRENCHES _____ TOTAL BOTTOM AREA _____

SEEPAGE PITS, INSIDE DIAMETER 8 FT. DEPTH BELOW INLET 10 FT.

ABSORBENT AREA 251. SQ. FT.

REMARKS ^{13/10/62} Dry well Wall to Wall diameter is 10ft including gravel giving sidewall area of 314 sq ft.

System is about 120ft from right sideline - is supposed to be 80 ft therefore requiring retest DW/M 12/10/62. OK to cover system with the exception of Dry Well.

3/26/63. ground tested at bottom of dry well - system OK DW

DATE SYSTEM APPROVED 3/26/63 INSPECTOR Deu Hong Han