

4/2/71  
9:30  
2:30

Approved 4/2/71 gfw

# PERMIT

15760  
A

SEWAGE DISPOSAL SYSTEM

MARYLAND STATE DEPARTMENT OF HEALTH

HOWARD COUNTY

ELLICOTT CITY

## INDEXED

DISTRICT 3

DATE 3/22/71

Jack Fyock IS PERMITTED TO INSTALL ALTER  X  
ADDRESS Ten Oaks Road, Glenely, Md. PHONE 286-2939

A SEWAGE DISPOSAL SYSTEM LOCATED AT \_\_\_\_\_

SUBDIVISION \_\_\_\_\_ ROAD 1231 Underwood Road - LOT \_\_\_\_\_  
off Old Frederick Rd. - equipment beside

PROPERTY OWNER Hellas Dwight Pader road

ADDRESS \_\_\_\_\_

### SPECIFICATIONS

DRAIN FIELD \_\_\_\_\_ DEPTH \_\_\_\_\_ FEET. BOTTOM AREA \_\_\_\_\_ SQ. FT.

SEEPAGE PITS \_\_\_\_\_ ABSORBENT SIDE-WALL AREA \_\_\_\_\_ SQ. FT.

SEPTIC TANK CAPACITY \_\_\_\_\_ GALLONS

FOR GARBAGE GRINDER, INCREASE DISPOSAL AREA 22% & TANK CAPACITY 50%.

OTHER REPAIR - Call for inspection when ground is opened up and Sanitarian will

recommend repair system.

PLANS APPROVED BY Palmer F. Wine DATE 3/22/71

FILL SEPTIC TANK AND DISTRIBUTION BOX WITH WATER BEFORE CALLING FOR AN INSPECTION. COVER NO WORK UNTIL INSPECTED AND APPROVED.

NEITHER THE HOWARD COUNTY COMMISSIONERS NOR THE HEALTH DEPARTMENT IS RESPONSIBLE FOR THE SUCCESSFUL OPERATION OF ANY SYSTEM.

BLDG. PERMIT SIGNED  
AND RETURNED 12/31/91  
Serial # 48659  
addition

15760


80  
7  
08

12721

PERMIT

STATE DEPARTMENT OF HEALTH

INDEXED

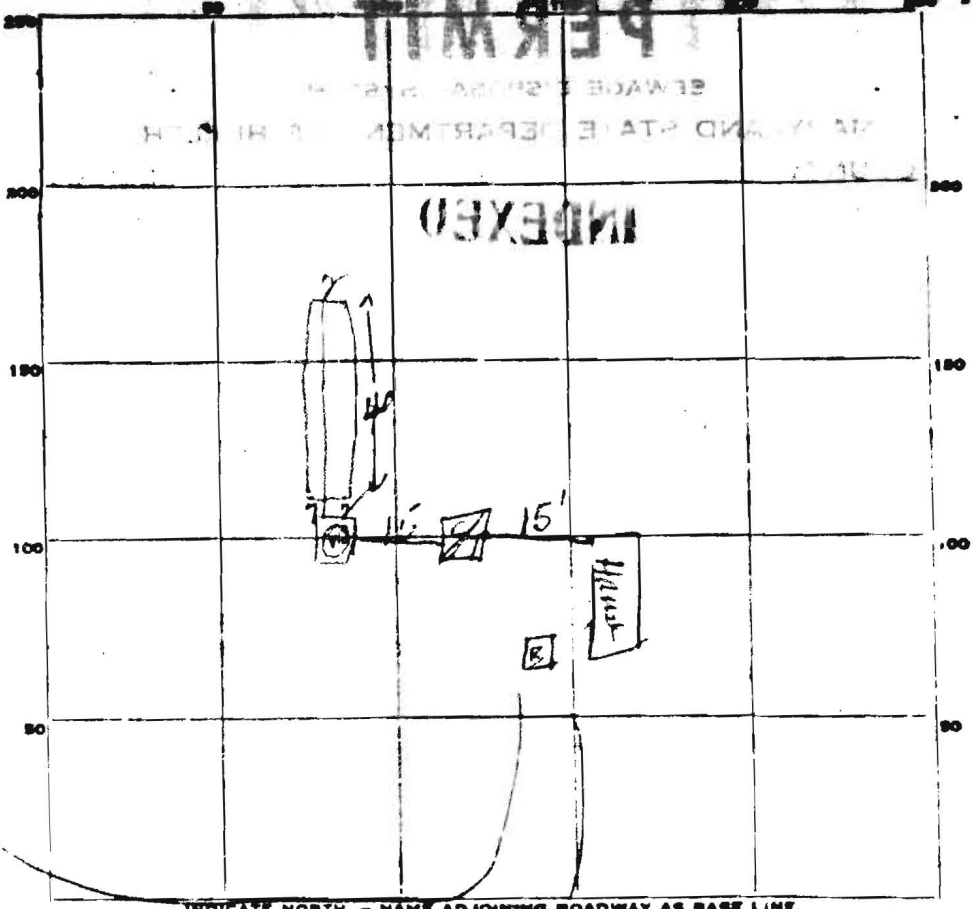

INDICATE NORTH. - NAME ADJOINING ROADWAY AS BASE LINE.

PERMIT CARD

SEPTIC TANK. LEVEL

CLEANOUTS

DISTRIBUTION BOX. LEVEL

TILE FIELD DEPTH 11 FT. TRENCH WIDTH 2 FT. Inlet 4"

GRAVEL DEPTH 24-3" IN. TOTAL LENGTH 40 FT.

NUMBER OF TRENCHES 1 TOTAL BOTTOM AREA 560+

SEEPAGE PITS. INSIDE DIA. (ETER) \_\_\_\_\_ FT. DEPTH BELOW INLET \_\_\_\_\_ FT.

ABSORBENT AREA \_\_\_\_\_ SQ. FT.

REMARKS

DATE SYSTEM APPROV. D

4/3/71

INSPECTOR

[Signature]