

2/7/59

PERMIT

SEWAGE DISPOSAL SYSTEM


MARYLAND STATE DEPARTMENT OF HEALTH

HOWARD COUNTY

ELICOTT CITY

DISTRICT A

INDEXED

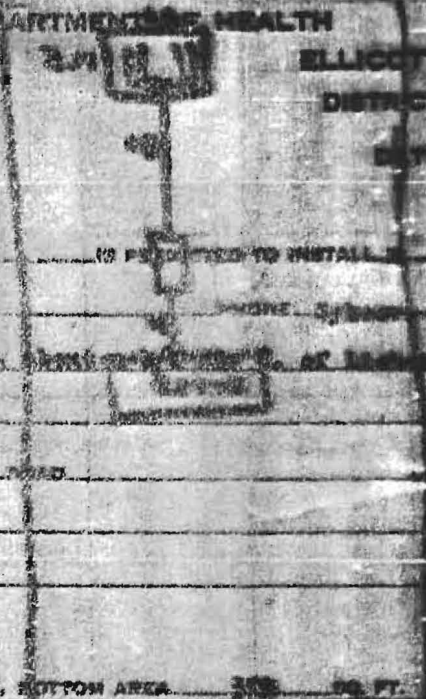

Capa Villiers

IS PERMITTED TO INSTALL ALTER

ADDRESS York Township

PHONE 366-411

A SEWAGE DISPOSAL SYSTEM LOCATED AT 310 St. Anthony's Church Rd. at corner of York
side of the road.

SUBDIVISION York

PROPERTY OWNER Leland O. Rowan

ADDRESS York

SPECIFICATIONS

DRAIN FIELD 1 DEPTH 3 FEET, BOTTOM AREA 300 SQ. FT.

SEPTIC TANK 1 CAPACITY 150 GALLONS

SEPTIC TANK CAPACITY 150

ANY CHANGE (INCREASE) DISPOSAL AREA OR TANK CAPACITY WILL BE AT OWNER'S RISK


OTHER System was to be installed in area that passed preliminary inspection

PLANS APPROVED BY James E. Hennigan DATE 2-6-59

FILL SEPTIC TANK AND DISTRIBUTION BOX WITH WATER BEFORE CALLING FOR AN INSPECTION. COVER NO MORE UNTIL INSPECTED AND APPROVED.

NEITHER THE HOWARD COUNTY COMMISSIONERS NOR THE HEALTH DEPARTMENT IS RESPONSIBLE FOR THE SUCCESSFUL OPERATION OF ANY SYSTEM.

Handwritten signatures and notes:
 James E. Hennigan
 2/11/59
 100 P. 55

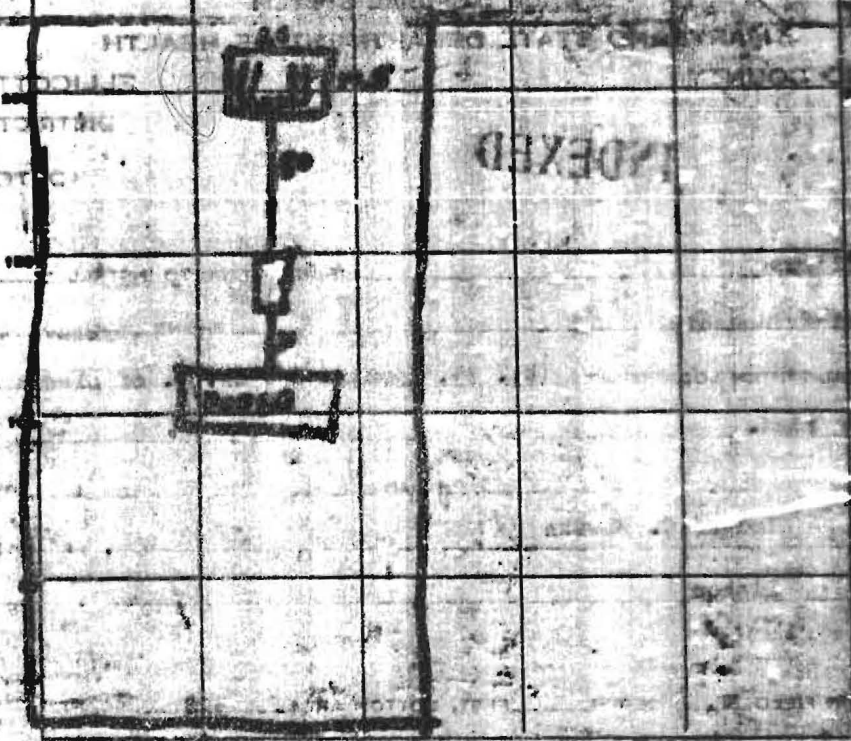

PERMIT CARD OK
 SEPTIC TANK, LEVEL OK CLEANOUT OK 8" in Tank
 DISTRIBUTION BOX, LEVEL _____
 TILE FIELD, DEPTH _____ FT. TRENCH WIDTH _____ FT.
 GRAVEL DEPTH _____ IN. TOTAL LENGTH _____ FT.
 NUMBER OF TRENCHES _____ TOTAL BOTTOM AREA _____
 SEEPAGE PITS, INSIDE DIAMETER _____ FT. DEPTH BELOW INLET _____ FT.

170
 290
 507

ABSORBENT AREA _____ SQ. FT.
 REMARKS: Leaching bed 26 X 19.5 = 507 sq ft
3-4 ft deep. 2" gravel over pipe
18" under the pipe. Only 2 pits
are to live in house. # of sq ft as enough
in this case.

DATE SYSTEM APPROVED 8/1/59 INSPECTOR Raymond H. [Signature]