

MARYLAND STATE DEPARTMENT OF HEALTH
HOWARD COUNTY *10000 ft.*

ELICOTT CITY

DISTRICT

DATE

*Day Well - 300 sq. ft. elevated sidewalk
area to begin below the first 5 ft. of
Maximum depth permitted is 15 ft. locate
day well 100 ft. from front property line
and 20 ft. from right side line as seen
from right of way.*

TO: THE COUNTY HEALTH OFFICER
ELICOTT CITY, MARYLAND

I HEREBY APPLY FOR THE NECESSARY TESTS IN ORDER TO CONSTRUCT OR RECONSTRUCT A SEW/
DISPOSAL SYSTEM.

PROPERTY OWNER *Felix E. Vestwood*

11511 Sand Flats, Silver Spring, Md.

PROPERTY LOCATION

SUBDIVISION *Courtney Place*

LOT NO. *15*

ROAD AND DESCRIPTION *Directions* *CT # 114, State Route # 94, About 3 miles south of Ithaca, Md.*

OCCUPANT

PHONE

PERSON TO CONSTRUCT SYSTEM

ADDRESS

PHONE

SIZE OF LOT *5, 522 sq. ft.*

TYPE BLDG. *3*
NUMBER OF SEWERINGS

IF NOT SINGLE RESIDENCE DESCRIBE

SIGNATURE OF APPLICANT *Felix E. Vestwood*


APPROVED BY *Robert V. Jones* FOR *Day Well* DATE *12/14/72*

REJECTED BY _____ FOR _____ DATE _____

HOLD PENDING FURTHER TESTS _____ DATE _____

REASONS FOR REJECTION OR HOLDING _____

THIS IS NOT A PERMIT

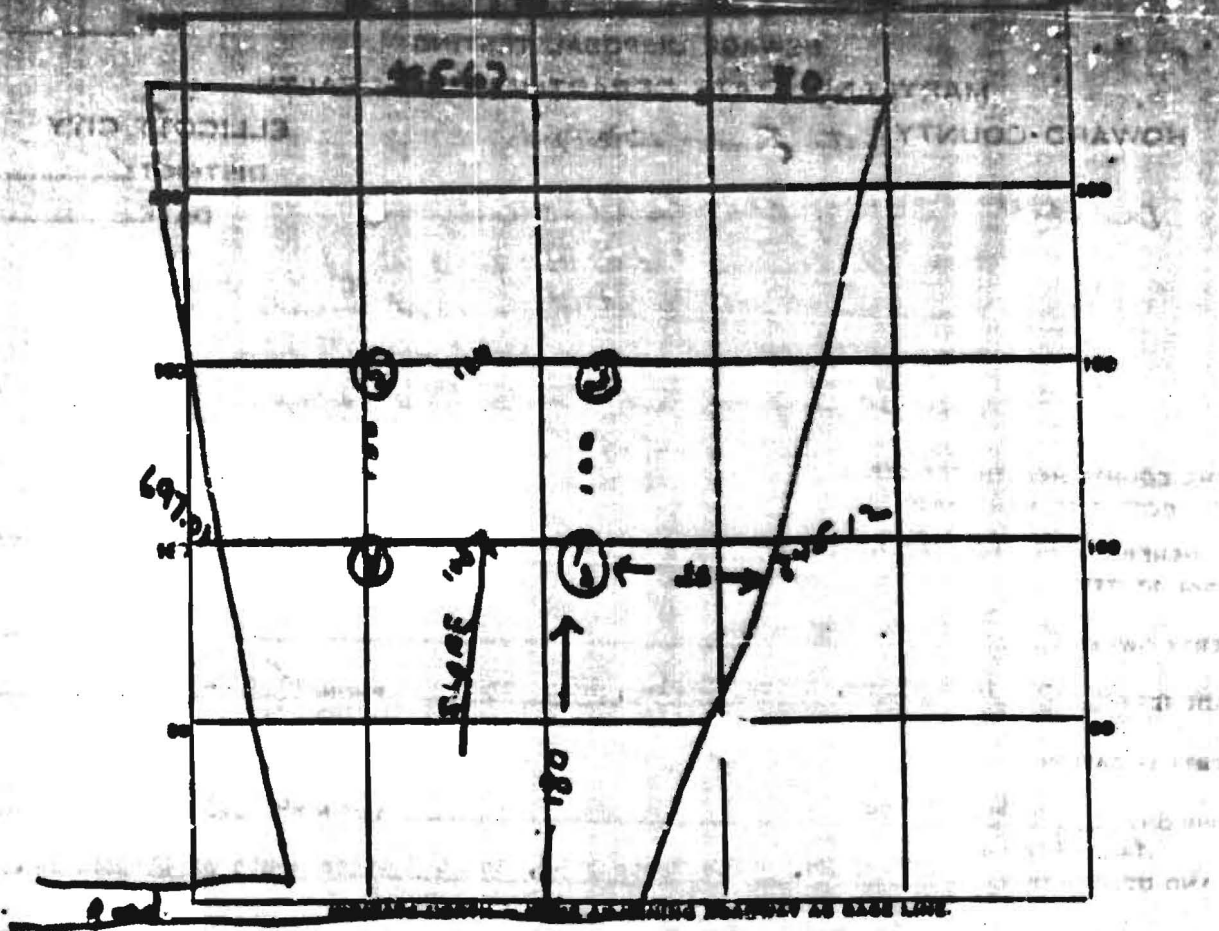

DATE	TEST NO.	DEPTH	PRE-TEST		TEST - 1" DROP		TIME
			START	STOP	START	STOP	
12/14/77	1	11 1/2 ft.	9:46	9:52	9:52	10:00	8 min
	2	4 ft.	9:46	9:49	9:49	9:58	5 min
	3	12 ft.	9:54	10:01	10:01	10:09	8 min
	4	11 ft.	hard soil - shale				
	5	10 1/2 ft.	" - shale				
	5A	4 ft.	9:59	10:01	10:01	10:08	4 min

SOIL AUGER FINDING _____

TESTED BY R. Tove

REMARKS _____