

WELL COMPLETION REPORT

PERMIT NO. 6-17729  
 11-13-67  
 00 00 00 00 00 00 00 00

10-14-74  
 DATE WELL DRILLED

OWNER: Wheaton Files  
 STREET OR RFD: 11501 LUND PL  
 POST OFFICE: Wheaton Md

STATE THE KIND OF FORMATIONS PENETRATED, WITH COLOR, DEPTH, THICKNESS AND IF WATER BEARING

WELL IDENTIFICATION NO. 42  
 TYPE OF CASING:  STEEL  PLASTIC

FORMATION	DEPTH (FEET)	THICKNESS (FEET)
Top Soil	0	2
Shale	2	15
SHALE	15	50
Brown Slate	50	100
Blue Slate	100	165

NO. OF CASES: 6 NO. OF PUMPS: 600  
 FALLING OF WATER: 36  
 DEPTH OF GROUT SEAL TO NEAREST FEET:  
 FROM 0 FT. TO 30 FT.  
 WATER IS FROM SURFACE:

CASING DEPTH:  
 STEEL  PLASTIC  
 WOOD  OTHER  
 MAIN CASING TYPE: 57  
 NOMINAL DIAMETER TOP END CASING (NEAREST INCH): 6  
 TYPICAL DEPTH OF MAIN CASING (NEAREST FOOT): 21

OTHER CASING BY WOOD:  
 DIAMETER (INCH) \_\_\_\_\_ DEPTH (FEET) \_\_\_\_\_

SCREEN DEPTH:  
 STEEL  PLASTIC  WOOD  
 OTHER

DEPTH (NEAREST WHOLE FOOT):  
110 74 165

PUMPING TEST  
 HOURS PUMPED TO NEAREST HOUR: 1  
 PUMPING DATE: \_\_\_\_\_  
 GALLONS PER MINUTE TO NEAREST GALLON: 6

WATER LEVEL: (MEASURED FROM LAND SURFACE)  
 BEFORE PUMPING: 30 FEET  
 DURING PUMPING: 165 FEET


TYPE OF PUMP USED (WHOLE APPROPRIATE FOR PUMPING TEST):  
 CENTRIFUGAL  ROTARY  OTHER  
 JET  SUBMERSIBLE

PUMP INSTALLER  
 TYPE OF PUMP (WRITE APPROPRIATE LETTER IN BOX - SEE ABOVE: A, C, J, P, R, S, T, U)  
 YES  NO

CAPACITY:  
 GALLONS PER MINUTE TO NEAREST GALLON: \_\_\_\_\_  
 PUMP HORSE POWER: \_\_\_\_\_  
 PUMP COLUMN LENGTH (NEAREST FOOT): \_\_\_\_\_

CASING HEIGHT (WHOLE APPROPRIATE OF AND ENTER CASING HEIGHT):  
 ABOVE  BELOW  
 LAND SURFACE: 2 FEET

LOCATION OF WELL ON LOT  
 SHOW PERMANENT STRUCTURE SUCH AS BUILDING, SEPTIC TANKS, AND FOR OTHER LAND MARKS, INDICATE NOT LESS THAN TWO DISTANCE MEASUREMENTS TO WELL.

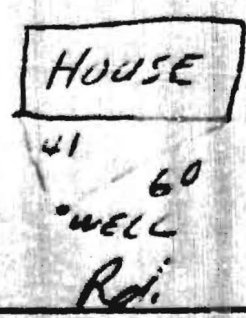

CIRCLE APPROPRIATE BOXES  
 A WELL WAS ABANDONED AND SEALED WHEN THIS WELL WAS COMPLETED  
 B ELECTRIC LOG OBTAINED  
 C TEST WELL CONVERTED TO PRODUCTION WELL  
 I HEREBY CERTIFY THAT I HAVE COMPLIED WITH ALL CONDITIONS STATED ON THE ABOVE-CAPTIONED "PERMIT TO DRILL WELL", AND THAT INFORMATION CONTAINED IN THIS REPORT IS TRUE, ACCURATE, AND COMPLETE TO THE BEST OF MY KNOWLEDGE, INFORMATION AND BELIEF.  
 DRILLER'S NAME: L.F. Fosterday  
 SIGNATURE: [Signature]

DIAMETER OF BUREN \_\_\_\_\_ (NEAREST INCH)  
 GRAVEL PACK \_\_\_\_\_  
 IF WELL DRILLED AND CLOSING WELL CIRCLE BOX:   
 IF YOU DO NOT WANT IT TO BE FILLED IN BY DRILLER:  
 TELESCOPE CASING  LOG  OTHER DATA AVAILABLE