

Fill out in triplicate.
Make \$30.00 check payable to
Howard County Health Dept. - Sanitation

1/30/88 1130
2-13' holes
75 ft. apart

APPLICATION

A 21032

SEWAGE DISPOSAL TESTING

P _____

STATE OF MARYLAND - DEPARTMENT OF HEALTH AND MENTAL HYGIENE

HOWARD COUNTY HEALTH DEPARTMENT
ENVIRONMENTAL HEALTH SERVICES

DISTRICT 5TH

P. O. BOX 476, ELLICOTT CITY, MARYLAND 21043
TELEPHONE: 465-5000, EXT. 356

DATE 12/13/74

Recorded

*12/23/74
1:30*

Dry well to see test sheet - to have 120 sq ft effective side wall area per bedroom below inlet. Inlet to be at 4', maximum depth of dry well will be 10' below original grade. Place dry well 70' from the front of lot, 130' off 105' property line (C+P pole #26 as lot front corner property line as per owner) when facing lot from road.

TO: THE COUNTY HEALTH OFFICER
ELLICOTT CITY, MARYLAND

I, HEREBY, APPLY FOR THE NECESSARY TEST IN ORDER TO CONSTRUCT (OR RECONSTRUCT) A SEWAGE DISPOSAL SYSTEM.

PROPERTY OWNER Karl R. Viernstein and Dale D. Viernstein

ADDRESS 3401 Brook Rd, Richmond, Va. 23227 PHONE 804-358-1044

PROPERTY LOCATION:

SUBDIVISION Forest Hills LOT NO. Lot # 8

ROAD AND DESCRIPTION Trotter Road (Rt. 29 South, Right on Route 108, left on Trotter Road To sign on right) 80% wooded & slopes toward rear.

SIZE OF LOT 1.452 Acres TYPE BLDG. None
NUMBER OF BEDROOMS _____

IF NOT SINGLE RESIDENCE DESCRIBE _____

THE SYSTEM INSTALLED UNDER THIS APPLICATION IS ACCEPTABLE ONLY UNTIL PUBLIC FACILITIES BECOME AVAILABLE.

SIGNATURE OF APPLICANT Karl R. Viernstein Dale D. Viernstein

APPROVED BY Paul J. Hall FOR Dry Well DATE Dec 24, 1974
(KIND OF SYSTEM)

REJECTED BY _____ FOR _____ DATE _____
(KIND OF SYSTEM)

HOLD PENDING FURTHER TESTS _____ DATE _____

REASONS FOR REJECTION OR HOLDING (No Rec Required) RE-TEST REQUIRED DUE TO AGE OF

TESTS AND PROXIMITY TO WATER TABLE - AGENT NORA McGAUGHLIN

NOTIFIED 1/13/89 CWL

THIS IS NOT A PERMIT

INDICATE NORTH. - NAME ADJOINING ROADWAY AS BASE LINE.

DATE	TEST NO.	DEPTH	PRE-WET		TEST - 1" DROP		TIME
			START	STOP	START	STOP	

REMARKS _____

TYPE OF SOIL _____

TESTED BY _____ ALSO PRESENT: _____

APPLICATION

A 21032

SEWAGE DISPOSAL TESTING

P _____

STATE OF MARYLAND - DEPARTMENT OF HEALTH AND MENTAL HYGIENE

HOWARD COUNTY HEALTH DEPARTMENT
ENVIRONMENTAL HEALTH SERVICES
P. O. BOX 476, ELLICOTT CITY, MARYLAND 21043
TELEPHONE: 465-5000, EXT. 356

DISTRICT 5TH

DATE 12/3/74

TO: THE COUNTY HEALTH OFFICER
ELLICOTT CITY, MARYLAND

I, HEREBY, APPLY FOR THE NECESSARY TEST IN ORDER TO CONSTRUCT (OR RECONSTRUCT) A SEWAGE DISPOSAL SYSTEM.

PROPERTY OWNER Karl R. Viernstein and Dale D. Viernstein

ADDRESS 3401 Brook Rd, Richmond, Va. 23227 PHONE 804-358-1044

PROPERTY LOCATION:

SUBDIVISION Forest Hills LOT NO. Lot # 8

ROAD AND DESCRIPTION Trotter Road (Rt. 29 South, Right on Route 108, left on Trotter Road To sign on Right) 80% wooded + slopes toward rear.

SIZE OF LOT 1.452 Acres TYPE BLDG. None
NUMBER OF BEDROOMS _____

IF NOT SINGLE RESIDENCE DESCRIBE _____

THE SYSTEM INSTALLED UNDER THIS APPLICATION IS ACCEPTABLE ONLY UNTIL PUBLIC FACILITIES BECOME AVAILABLE.

SIGNATURE OF APPLICANT Karl R. Viernstein ; Dale D. Viernstein


APPROVED BY _____ FOR _____ DATE _____
(KIND OF SYSTEM)

REJECTED BY _____ FOR _____ DATE _____
(KIND OF SYSTEM)

HOLD PENDING FURTHER TESTS _____ DATE _____

REASONS FOR REJECTION OR HOLDING _____

THIS IS NOT A PERMIT

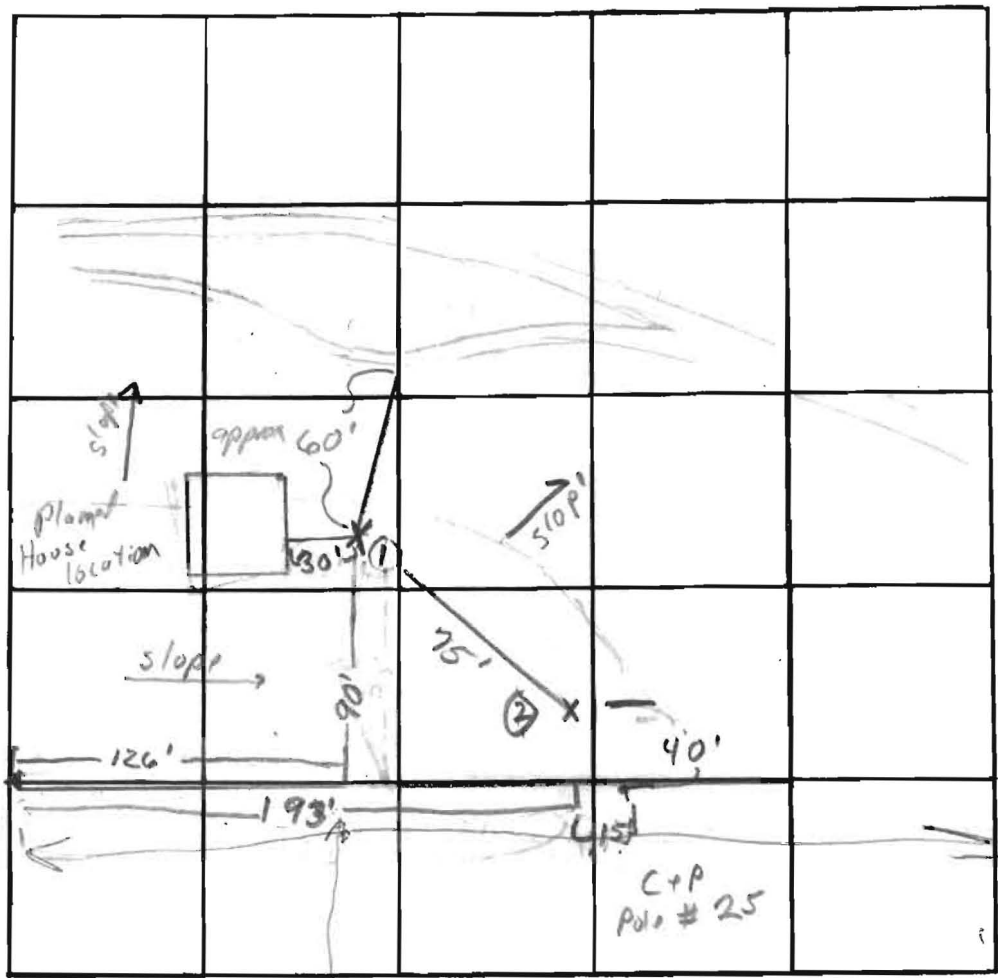

Forest Hills
Lot 8

Water course

Property
Marker
#26

INDICATE NORTH - NAME ADJOINING ROADWAY AS BASE LINE.


Trotter Rd.

DATE	TEST NO.	DEPTH	PRE-WET		TEST - 1" DROP		TIME	
			START	STOP	START	STOP		
12/23/14	15	3'	12 35	12 59	12 59	12 59	15 min	Clay loam see remarks
	1d	10'	12 41	12 42	12 42	12 43	1 min	
	15	4'	12 56	1 01	1 01	1 07	6 min	Sandy loam
	2d	12'	12 32	12 34	12 34	12 39	3 min	
			—					
			—					
REMARKS Washed lot - 1d weathered Feldspar 11'; Barter soils, purple present,

TYPE OF SOIL Sandy loam, weathered Feldspar

TESTED BY David J. O'Neill ALSO PRESENT: C.B. Stenker

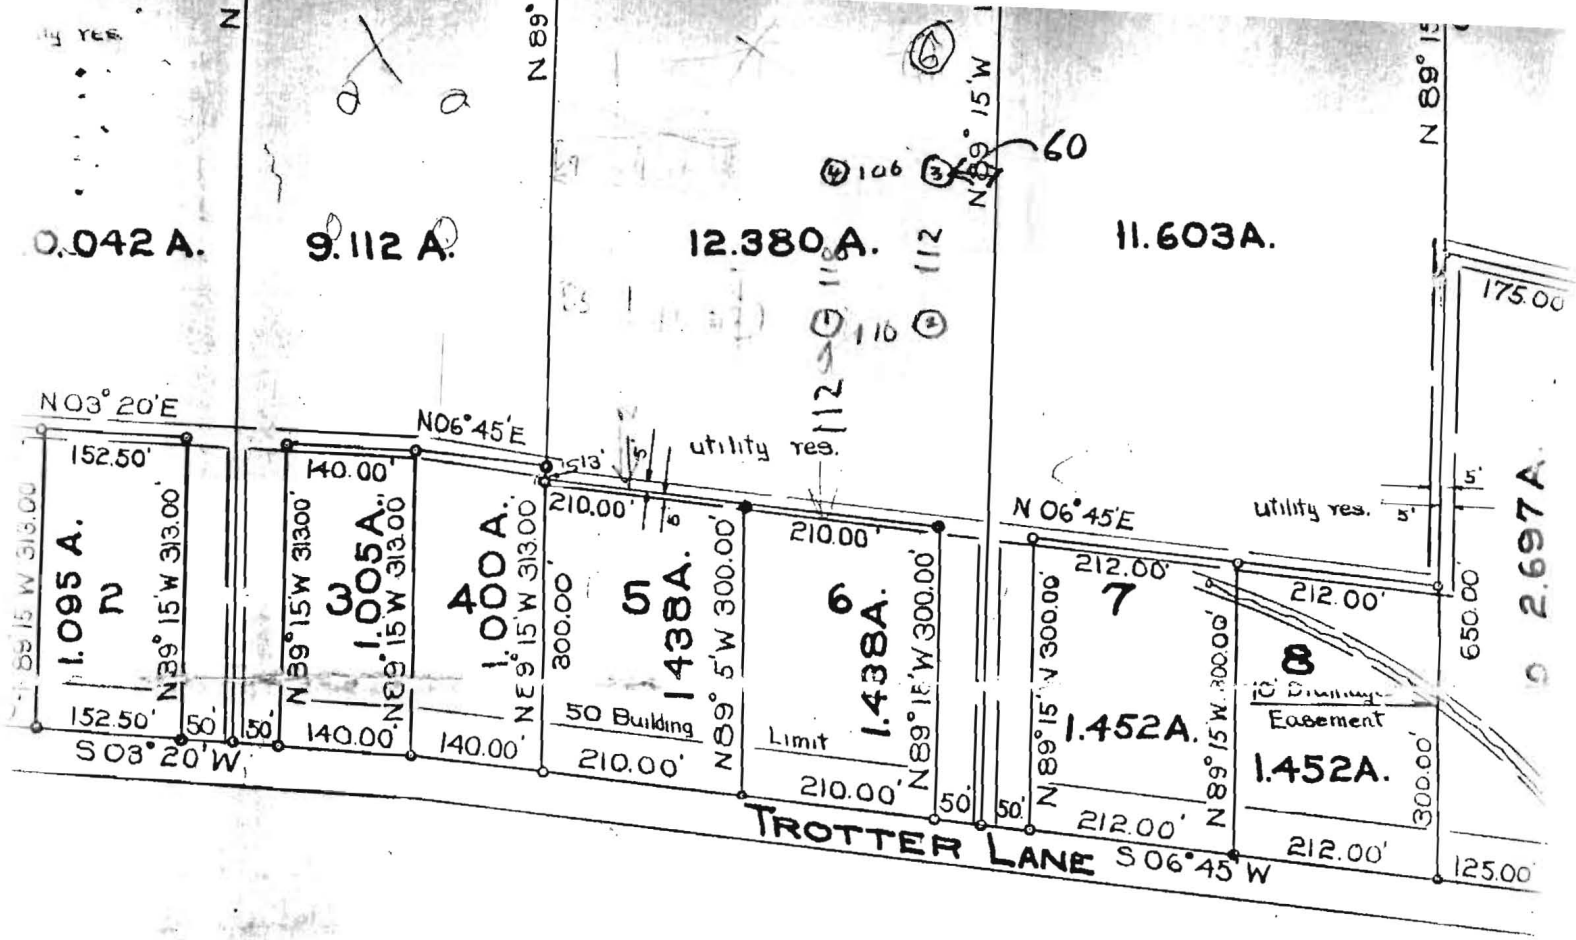

OWNERS' DEDICATION

We, Jesse E. Aiken and C. Ellsworth Jager, owners of the property, hereon adopt this plan of subdivision, and reserve the fee simple title to the beds of the streets and/or roads as shown hereon.

Jesse E. Aiken
 Jesse E. Aiken

C. Ellsworth Jager
 C. Ellsworth Jager

FIFTH ELE

SCALE: 1

ASHTON RE

PLAT APPROVED

BY

M. Genser, Chairman of Planning Commission