

INDICATE NORTH NAME ADJOINING ROADWAY AS BASE LINE.

*unnamed RD*

DATE	TEST NO.	DEPTH	PRE-WET		TEST - 1" DROP		TIME
			START	STOP	START	STOP	
9/4/68	1	4	10 <sup>19</sup>	10 <sup>20</sup>	10 <sup>20</sup>	10 <sup>24</sup>	4 min
	2	11 1/2	10 <sup>20</sup>	10 <sup>23</sup>	10 <sup>23</sup>	10 <sup>30</sup>	7 min
	3	9 ft	10 <sup>21</sup>	10 <sup>24</sup>	10 <sup>24</sup>	10 <sup>30</sup>	6 min
	4	4 ft	10 <sup>21</sup>	10 <sup>23</sup>	10 <sup>23</sup>	10 <sup>25</sup>	6 min

SOIL AUGER FINDING \_\_\_\_\_

TESTED BY *[Signature]* \_\_\_\_\_

REMARKS \_\_\_\_\_

*16 min*

# APPLICATION

A 13907

P \_\_\_\_\_

SEWAGE DISPOSAL TESTING

MARYLAND STATE DEPARTMENT OF HEALTH

HOWARD COUNTY

ELLICOTT CITY

DISTRICT 5

DATE 8/29/68

TO: THE COUNTY HEALTH OFFICER  
ELLICOTT CITY, MARYLAND

I, HEREBY, APPLY FOR THE NECESSARY TESTS IN ORDER TO CONSTRUCT (OR RECONSTRUCT) A SEWAGE DISPOSAL SYSTEM.

PROPERTY OWNER Aintree Estates, Inc.

ADDRESS 301 Cedar Ave., N. W., Washington, D. C. PHONE HO 5-1635

PROPERTY LOCATION:

SUBDIVISION Aintree Estates, Inc. LOT NO. 16, Sec. 2

ROAD AND DESCRIPTION Unnamed road

OCCUPANT \_\_\_\_\_ PHONE \_\_\_\_\_

PERSON TO CONSTRUCT SYSTEM \_\_\_\_\_

ADDRESS \_\_\_\_\_ PHONE \_\_\_\_\_

SIZE OF LOT 2.4 acres (376' x 308' x 470' x 198') TYPE BLDG. 3 or 4  
NUMBER OF BEDROOMS

IF NOT SINGLE RESIDENCE DESCRIBE \_\_\_\_\_

SIGNATURE OF APPLICANT /s/ Lloyd Booth

APPROVED BY \_\_\_\_\_ FOR \_\_\_\_\_ DATE \_\_\_\_\_  
(KIND OF SYSTEM)


REJECTED BY \_\_\_\_\_ FOR \_\_\_\_\_ DATE \_\_\_\_\_  
(KIND OF SYSTEM)

HOLD PENDING FURTHER TESTS \_\_\_\_\_ DATE \_\_\_\_\_

REASONS FOR REJECTION OR HOLDING \_\_\_\_\_

# THIS IS NOT A PERMIT

lot 16, Sec 2

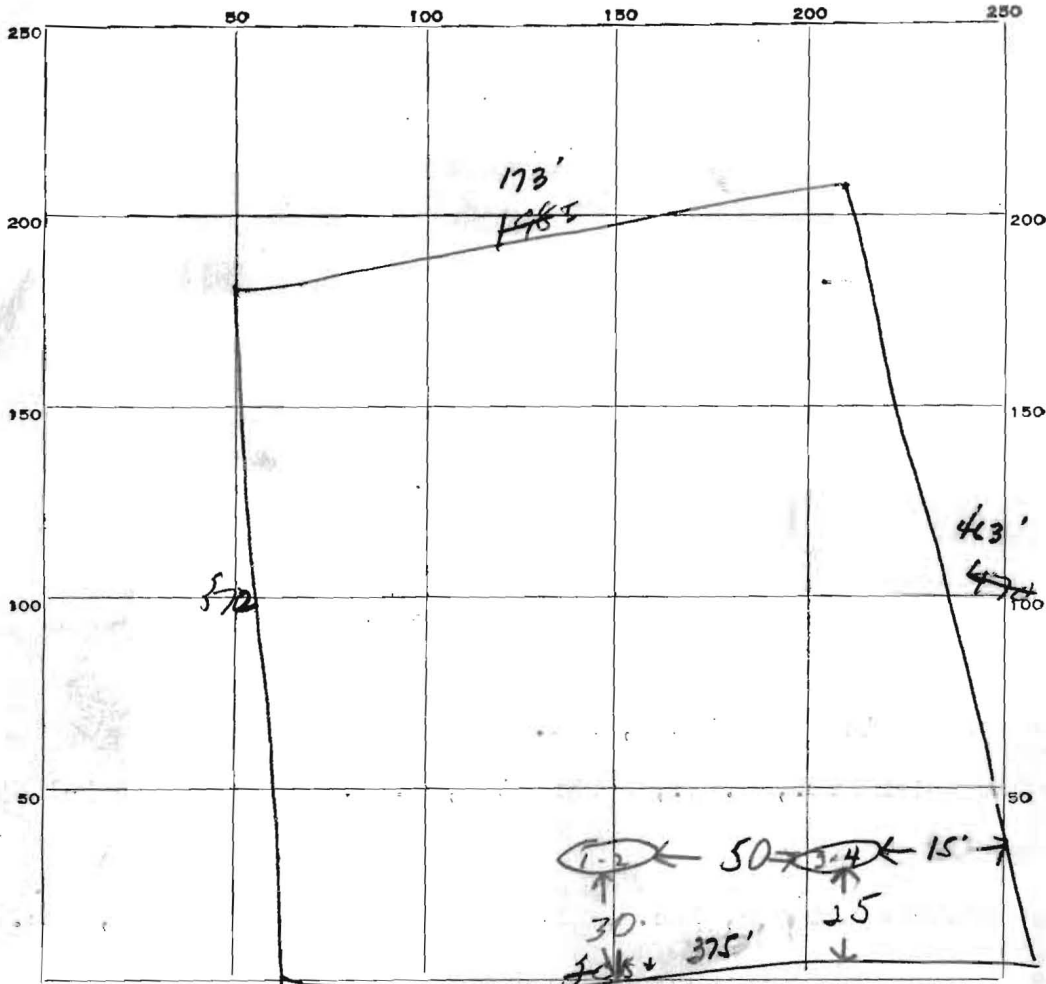

INDICATE NORTH. - NAME ADJOINING ROADWAY AS BASE LINE.

unnamed Rd

DATE	TEST NO.	DEPTH	PRE-WET		TEST - 1" DROP		TIME
			START	STOP	START	STOP	
9/4/8	1	4	10 <sup>19</sup>	10 <sup>20</sup>	10 <sup>20</sup>	10 <sup>24</sup>	4 min
	2	11 1/2	10 <sup>20</sup>	10 <sup>23</sup>	10 <sup>23</sup>	10 <sup>30</sup>	7 min
	3	9 ft	10 <sup>21</sup>	10 <sup>24</sup>	10 <sup>24</sup>	10 <sup>30</sup>	6 min
	4	4 ft	10 <sup>21</sup>	10 <sup>22</sup>	10 <sup>23</sup>	10 <sup>25</sup>	6 min
12/3/76	Checked a visual hole per specs - seen 11' dry hole pigger W. Hopkins + son.						

SOIL AUGER FINDING \_\_\_\_\_

TESTED BY Dum

REMARKS \_\_\_\_\_

16 sec 2