

1-18 (REV. 10-1-64)
DRILLER IS TO BE PUNCHED
ON ALL CARDS!

TAVES STATE OFFICE BLDG., ANNEAPOLIS, MD. 214
WELL COMPLETION REPORT

FILL IN TWO FOUR CORNERS

DATE WELL COMPLETED: 12/2/75
DEPTH OF WELL: 175
PERMIT NO. FROM "PERMIT TO DRILL WELL": 175
DRILLERS IDENTIFICATION NO.: 209

DRILLER: RINGER
LAST NAME: RINGER
FIRST NAME: Gary
ADDRESS: 601 Cedar Hill Road
POST OFFICE: Baltimore, Md. 21225

WELL LOG

THE KIND OF FORMATIONS PENETRATED, THEIR DEPTH, THICKNESS AND IF WATER BEARING

DESCRIPTION OF FORMATIONS PENETRATED (IF NECESSARY)	FEET		WELL DEPTH
	FROM	TO	
main rock	0	21	175
hard white Rock	21	125	
Ice Rock	125	175	

GRouting RECORD

WELL HAS BEEN GROUTED (CIRCLE APPROPRIATE BOX)

TYPE OF GROUTING MATERIAL (CIRCLE BOX)

CEMENT M BENTONITE CLAY C

NO. OF BAGS: 10 NO. OF POUNDS: 950

BALLONS OF WATER: 100

DEPTH OF GROUT SEAL (TO NEAREST FOOT)

FROM 0 FT. TO 21 FT.

CASING RECORD

CASING TYPES

(CIRCLE APPROPRIATE CODE BELOW)

STEEL S CONCRETE C

PLASTIC P OTHER O

MAIN CASING TYPE: S

INTERNAL DIAMETER TOP OF MAIN CASING (NEAREST INCH): 5

TOTAL DEPTH OF MAIN CASING (NEAREST FOOT): 21

OTHER CASING (if used)

TYPE: [] DEPTH (FEET): []

SCREEN RECORD

SCREEN TYPE OR SPIN HOLE

(CIRCLE APPROPRIATE CODE BELOW)

STEEL S BRASS OR BRONZE B

PLASTIC P OTHER O

DEPTH (NEAREST WHOLE FOOT)

FROM 0 TO 21

FROM 21 TO 175

DIAMETER OF SCREEN (NEAREST INCH)

FROM 1.5 TO 2.0

WELL DEPTH

IF WELL DRILLED WAS A FLOWING WELL (CIRCLE BOX) F

PUMPING TEST

HOURS PUMPED (TO NEAREST HOUR): 6

PUMPING RATE (GALLONS PER MINUTE TO NEAREST GALLON): 10

DEPTH USED TO MEASURE PUMP/LOG DATE: T₁₀₀

WATER LEVEL (DISTANCE FROM LAND SURFACE)

DEPTH OF PUMPING: 17

DEPTH OF WATER LEVEL: 10

TYPE OF PUMPED USED (CIRCLE APPROPRIATE BOX)

A B C D E F G H I J K L M N O P Q R S T U V W X Y Z

FINISH DETAILS

TYPE OF PUMP (CIRCLE APPROPRIATE LETTER)

DRILLER WILL INSTALL PUMP (CIRCLE APPROPRIATE BOX) Y

STANDARD PER MINUTE (TO NEAREST GALLON): []

PUMP DEPTH (FEET): []

LOCATION OF WELL ON LOT

INDICATE BY STRUCTURE SUCH AS BUILDING, DRIVE, TRAIL, AND/OR OTHER LAND MARKS AND DISTANCE NOT LESS THAN THE DISTANCE INDICATED TO THE WELL.

CIRCLE APPROPRIATE BOXES

A WELL WAS ABANDONED AND SEALED WHEN THIS WELL WAS COMPLETED

B ELECTRIC LOG OBTAINED

C TEST WELL CONVERTED TO PRODUCTION WELL

I HEREBY CERTIFY THAT I HAVE COMPLIED WITH ALL CONDITIONS STATED ON THE ABOVE-CAPTIONED "PERMIT TO DRILL WELL", AND THAT INFORMATION CONTAINED IN THIS REPORT IS TRUE, ACCURATE, AND CORRECT TO THE BEST OF MY KNOWLEDGE, INFORMATION AND BELIEF.

DRILLER'S NAME: Howard Miller

SIGNATURE: Howard Miller


WRA USE ONLY (NOT TO BE FILLED IN BY DRILLER)

TELEPHONE CASING: []

LOG INDICATOR: []

OTHER DATA AVAILABLE: []

HEALTH

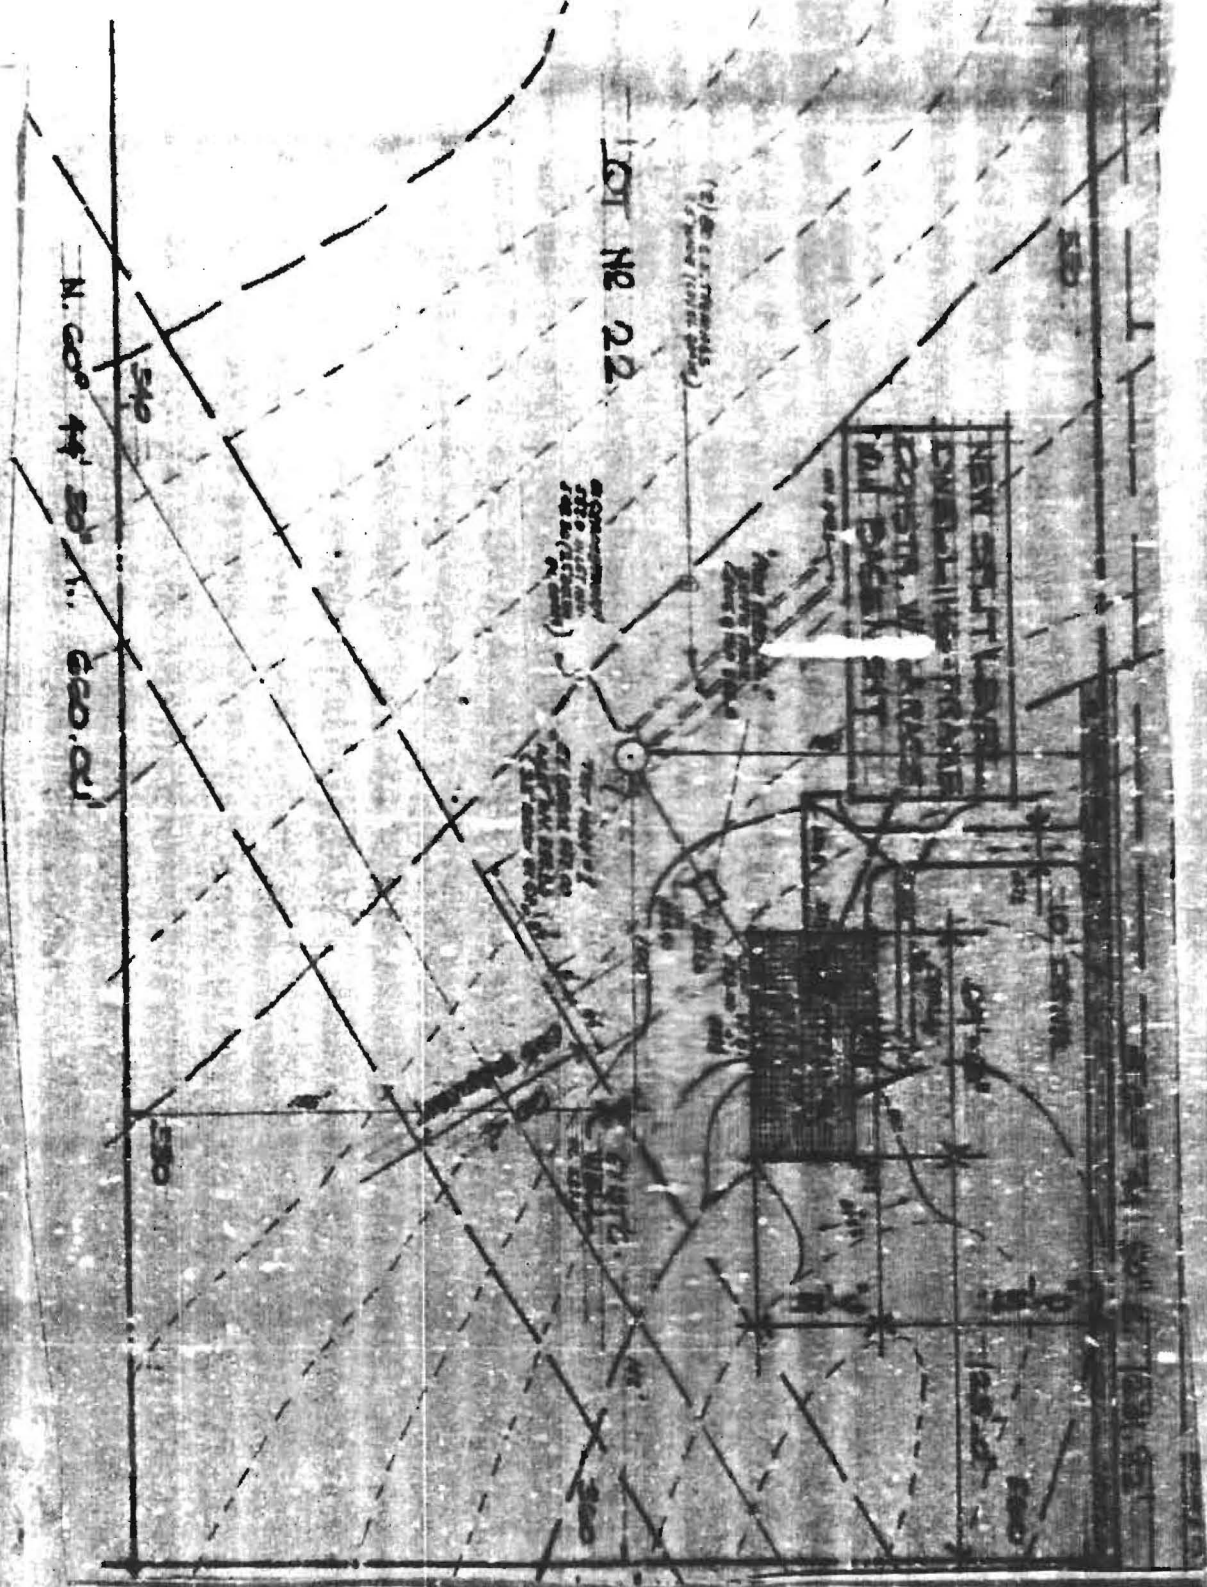

LOT NO 22

N. 60° 44' 50" E. 650.00'

540

650

NEW SETTLEMENT
FOR THE
CANTON OF
MADRID

SECTION
OF THE
TOWN OF
MADRID

SECTION
OF THE
TOWN OF
MADRID


10.000

1000

500

* 1/4" = 15 ft.

Windy Knoll Road

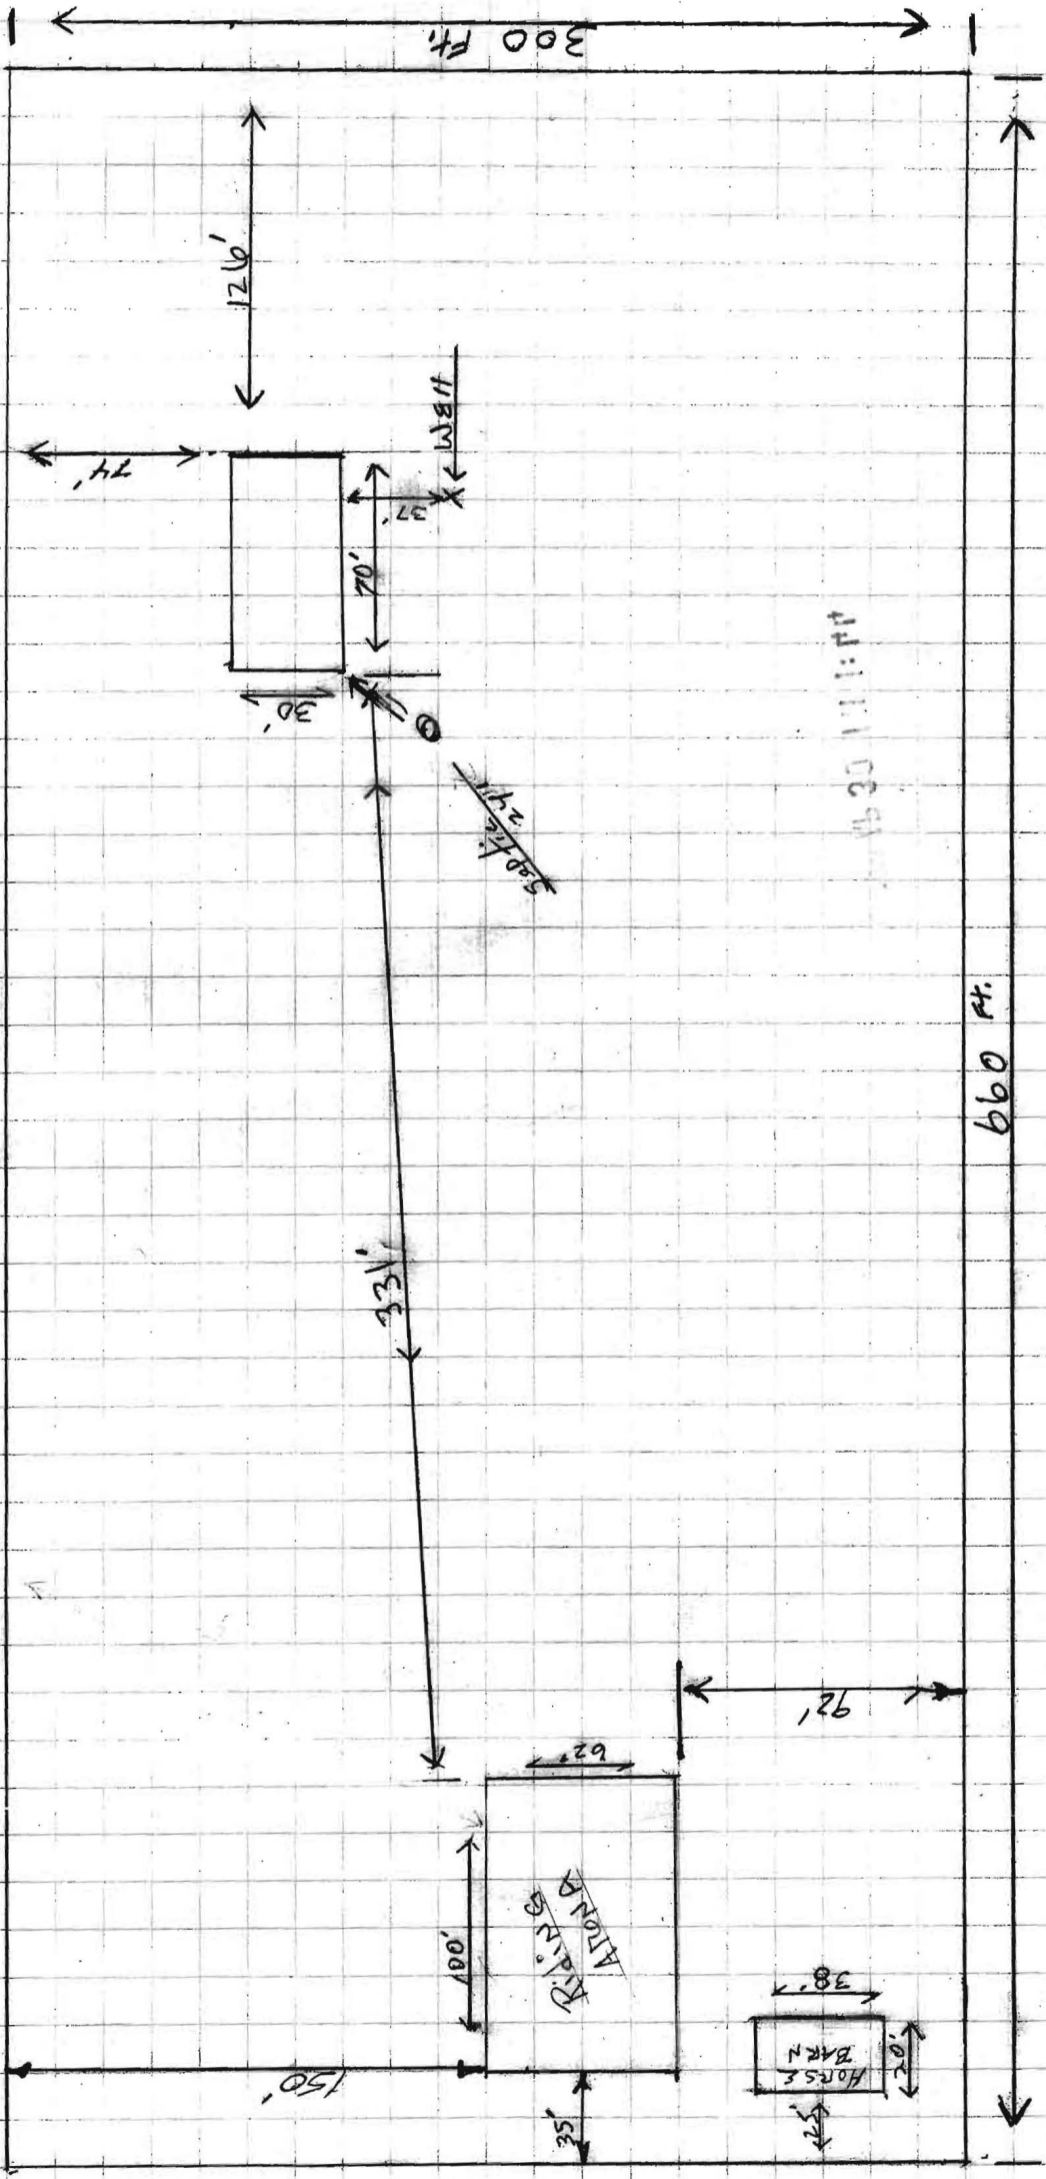

APR 11 11:44

