

3/5/76  
9.20  
Re-test

allow and necessary for it to be set

# APPLICATION

A 22803  
P \_\_\_\_\_  
DISTRICT \_\_\_\_\_  
DATE 5/13/76

## SEWAGE DISPOSAL TESTING

STATE OF MARYLAND - DEPARTMENT OF HEALTH AND MENTAL HYGIENE

HOWARD COUNTY HEALTH DEPARTMENT  
ENVIRONMENTAL HEALTH SERVICES  
P. O. BOX 475, ELLICOTT CITY, MARYLAND 21043  
TELEPHONE 448-6580, EXT. 370

TO: THE COUNTY HEALTH OFFICER  
ELLICOTT CITY, MARYLAND

I, HEREBY, APPLY FOR THE NECESSARY TEST IN ORDER TO CONSTRUCT (OR RECONSTRUCT) A SEWAGE DISPOSAL SYSTEM.

PROPERTY OWNER Gary Ringer

ADDRESS \_\_\_\_\_ PHONE \_\_\_\_\_

PROPERTY LOCATION:

SUBDIVISION 815 Windy Knoll LOT NO. 22

ROAD AND DESCRIPTION: Rt. 32 & River Road, (E. A. N. PROPERTY)

SIZE OF LOT 5.004 ACRES TYPE BLDG. 3 OF 4

IF NOT SINGLE RESIDENCE DESCRIBE \_\_\_\_\_  
(Single Family, 2-1/2 bry.)

THE SYSTEM INSTALLED UNDER THIS APPLICATION IS ACCEPTABLE ONLY UNTIL PUBLIC FACILITIES BECOME AVAILABLE.

SIGNATURE OF APPLICANT /s/ Pat Landis

APPROVED BY William H. Zapp FOR Daywell/Hand DATE 5/15/76  
(NAME OF SYSTEM)

REGISTERED BY \_\_\_\_\_ FOR \_\_\_\_\_ DATE \_\_\_\_\_  
(NAME OF SYSTEM)

HOLD PENDING FURTHER TESTS \_\_\_\_\_ DATE \_\_\_\_\_

REASONS FOR REJECTION OR HOLDING 5/15/76 Dimensional in DWM; since measurements were for center to center, can add 2' to each dimension. If do this have 210,000 lbs. is approx for shallow DN (9') in hole, 5 1/2' trench (w) off DN. Also statement regarding old pipe area.


# THIS IS NOT A PERMIT

TESTED BY \_\_\_\_\_  
 TYPE OF SOIL \_\_\_\_\_  
 REMARKS \_\_\_\_\_

TEST NO.	DEPTH	START TIME	STOP TIME	TEST TIME
1	3 3/4'	10:12	10:21	10:12
1-A	1 1/2'	10:10	10:17	10:22
2	10'	10:20	10:36	10:23
3	6'	10:32	10:36	10:40
4	4 1/2'	10:32	10:36	10:40
4-A	12'	10:32	10:42	11:05
5	4'	10:52	11:01	11:03
5-A	11'	10:43	10:53	11:10
6	5 1/2'	10:43	10:53	11:10
7	9'	10:43	10:53	11:10

9' - 3 3/4' - 9'  
 175 lb / 6x  
 15 min  
 145 lb / 6x  
 31  
 20 min - 50 min

R.H.W.

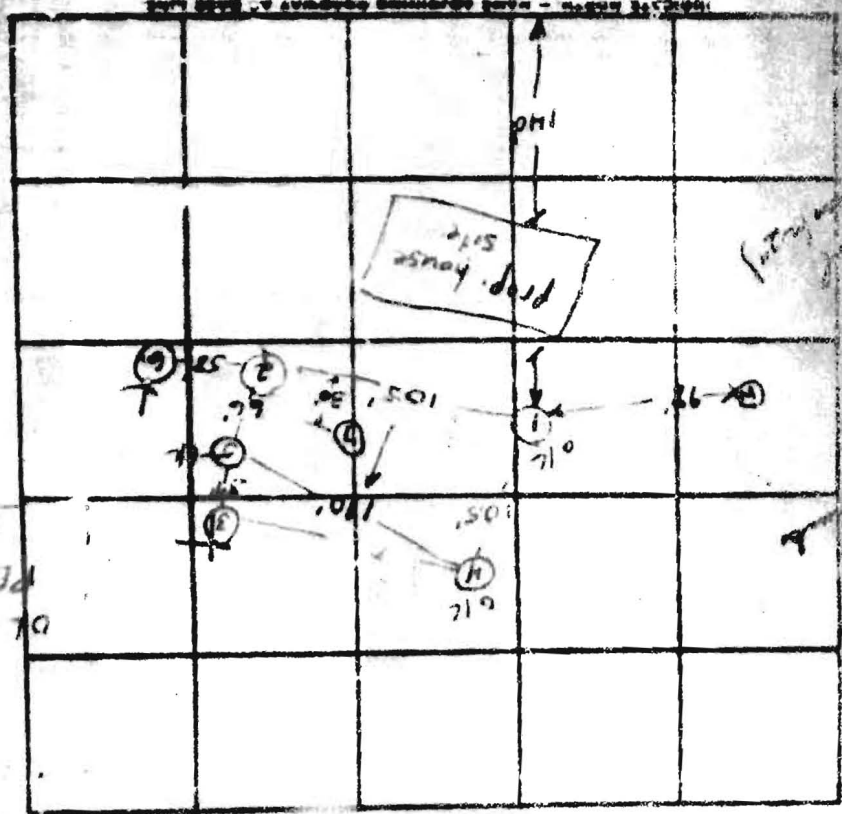

10  
 9  
 8  
 7  
 6  
 5  
 4  
 3  
 2  
 1