

7/30/03 - 10 AM 8/5/03 11 AM

PUB. SEWER STATUS VERIFIED BY

N/A for KN

ISSUE DATE:

7/25/2003

PERMIT

P 519067

APPROVAL DATE:

8/05/03

A REPAIR

INDEXED

ON-SITE SEWAGE DISPOSAL SYSTEM HOWARD COUNTY HEALTH DEPARTMENT BUREAU OF ENVIRONMENTAL HEALTH

04-315162

Jack Fyock Septic Service

IS PERMITTED TO

INSTALL ☐

ALTER ☒

ADDRESS: PO Box 89, Glenelg MD 21737

PHONE NUMBER: 410-988-9270

SUBDIVISION:

LOT NUMBER:

ADDRESS: 670 West Watersville Road

PROPERTY OWNER: Dennis McKenzie

SEPTIC TANK CAPACITY (GALLONS):

ADD ON ADDITIONAL 750 Tank or

PUMP CHAMBER CAPACITY (GALLONS):

N/A

replace it with at least
a compartmented 1250

NUMBER OF BEDROOMS:

3

SQUARE FEET PER BEDROOM:

180-210

LINEAR FEET OF TRENCH REQUIRED:

150-200' rate of tx zone 180
bottom of trench 210

TRENCHES:	Trench to be 3 feet wide. Inlet 4 feet below original grade. Bottom maximum depth 6 feet below original grade. Effective area begins at 5 1/2 feet below original grade. 2 feet of stone below distribution pipe.
LOCATION:	Run two -80' trenches on contour 12' c/c owner will decide to keep or fill in dry well
PURPOSE:	In support of building permit, B00142854. Call for inspection when the ground is opened so sanitarian can recommend repair.

PLANS APPROVED:

KN

DATE:

7/30/03

NOTE: PERMIT VOID AFTER 2 YEARS

NOTE: CONTRACTOR RESPONSIBLE FOR SCHEDULING A PRE-CONSTRUCTION INSPECTION FOR ALL INSTALLATIONS

NOTE: WATERTIGHT SEPTIC TANKS REQUIRED

NOTE: ALL PARTS OF SEPTIC SYSTEM SHALL BE 100 FEET FROM ANY WATER WELL

NOTE: MANHOLE RISERS REQUIRED ON ALL SEPTIC TANKS AND PUMP CHAMBERS

NEITHER THE HOWARD COUNTY COUNCIL NOR THE HEALTH DEPARTMENT IS
RESPONSIBLE FOR THE SUCCESSFUL OPERATION OF ANY SYSTEM


PERMITTEE RESPONSIBLE FOR OBTAINING FINAL APPROVAL ON THIS PERMIT

CALL 410-313-2640 FOR INSPECTION OF SEPTIC SYSTEM

**BUILDING PERMIT SIGNED
AND RETURNED**

7-30-03 B00142854-EX-APPRO MBDAAM

519067

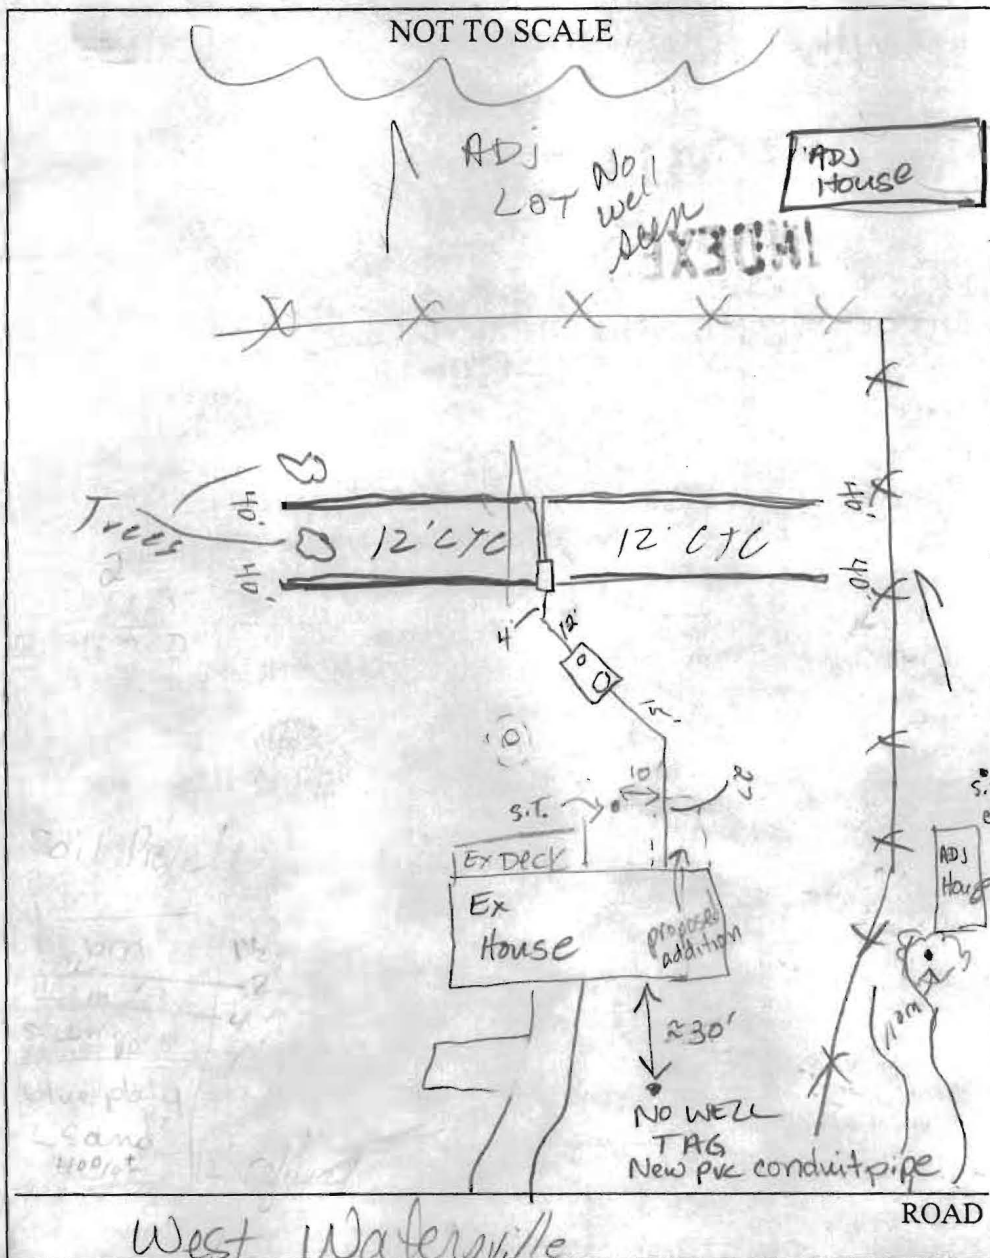

TRENCH/DRAINFIELD DATA		
WIDTH	INLET	BOTTOM
3	4	6
NUMBER OF TRENCHES		4
TOTAL LENGTH		160'
ABSORPTION AREA		
DISTRIBUTION BOX LEVEL		✓
DISTRIBUTION BOX BAFFLE		✓
DISTRIBUTION BOX PORT		✓

SEPTIC TANK DATA		
SEPTIC TANK 1 LEVEL		
Comp. CAPACITY	1500	GAL
SEAM LOC	Top	
TANK LID DEPTH	3'	
BAFFLES	✓	
BAFFLE FILTER		
MANHOLE LOC	Front	
6" PORT LOC	Back	
WATERTIGHT TEST		
SEPTIC TANK 2 LEVEL		
CAPACITY		GAL
SEAM LOC		
TANK LID DEPTH		
BAFFLES		
BAFFLE FILTER		
MANHOLE LOC		
6" PORT LOC		
WATERTIGHT TEST		

PRE-CONSTRUCTION 7/30/03 SEE PERC SHEET FOR PERC HOLE LOCATION & RATES OK TO REPAIR (SEE SPECS) (KN)

INSTALLATION - 8/5/03 - S.T. set, 2 trenches installed. OK to cover (SO) 8/5/03 - Last 2 trenches installed. Old S.T. & D.W. pump, collapsed, filled in. OK to cover all work (SO)

BUILDING PERMIT SIGNED AND RETURNED

FINAL INSPECTOR

DATE OF APPROVAL

8/5/03

BY LRA DATE 3/23/03 SUBJECT McKenzie Addition
CHKD. BY _____ DATE _____ Site Plan
Parcel 2 - 670 Waterville Rd. - H. Co Md.

SHEET NO. _____ OF _____
JOB NO. _____
Scale: 1" = 16'

