

11/14/69
PERMIT

SEWAGE DISPOSAL SYSTEM

MARYLAND STATE DEPARTMENT OF HEALTH

HOWARD COUNTY

ELLICOTT CITY

INDEXED

DISTRICT 6

DATE 8/2/69

Irving One IS PERMITTED TO INSTALL X ALTER

ADDRESS 9 N. Summit Avenue, Gaithersburg, Md. PHONE 926-1980

A SEWAGE DISPOSAL SYSTEM LOCATED AT _____

SUBDIVISION _____ ROAD West Waterville Rd. LOT _____
(see application for better directions)

PROPERTY OWNER Roland M. Dorney

ADDRESS _____

SPECIFICATIONS - 3 bedrooms

DRAIN FIELD _____ DEPTH _____ FEET, BOTTOM AREA _____ SQ. FT.

SEEPAGE PITS _____ ABSORBENT SIDE-WALL AREA _____ SQ. FT.

SEPTIC TANK CAPACITY 750 GALLONS

FOR GARBAGE GRINDER, INCREASE DISPOSAL AREA 22% & TANK CAPACITY 50%.

OTHER Dry well - 300 sq. ft. absorbent sidewall area to begin below the first
3 ft. of non-absorbent soil. Maximum depth permitted for dry well is 11 ft.
below original grade. Locate dry well 53 ft. from left side line and 86 ft.
from rear property line or same from West Waterville Rd.

NOTE: ALL PIPE FROM HOUSE TO SEPTIC TANK MUST BE CAST IRON.


PERMIT VOID AFTER THREE YEARS.

PLANS APPROVED BY Robert V. Tette DATE 8/2/69

FILL SEPTIC TANK AND DISTRIBUTION BOX WITH WATER BEFORE CALLING FOR AN INSPECTION. COVER NO WORK UNTIL INSPECTED AND APPROVED.

NEITHER THE HOWARD COUNTY COMMISSIONERS NOR THE HEALTH DEPARTMENT IS RESPONSIBLE FOR THE SUCCESSFUL OPERATION OF ANY SYSTEM.

12

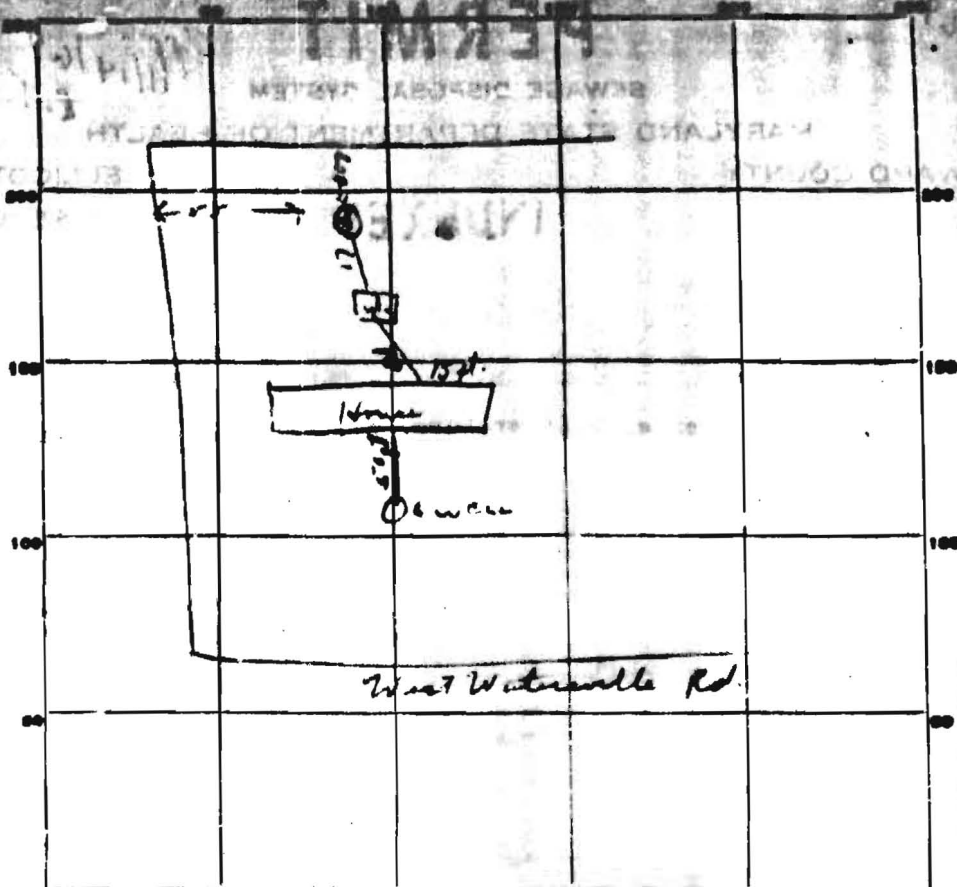

INDICATE NORTH. - NAME ADJOINING ROADWAY AS BASE LINE.

A 14616

Alvin + Roland
Dorsey

PERMIT CARD _____

SEPTIC TANK, LEVEL 750 gcl ok

CLEANOUTS ok

DISTRIBUTION BOX, LEVEL _____

TILE FIELD, DEPTH _____ FT. TRENCH WIDTH _____ FT.

GRAVEL DEPTH _____ IN. TOTAL LENGTH _____ FT.

NUMBER OF TRENCHES _____ TOTAL BOTTOM AREA _____

SEEPAGE PITS, ^{outside perimeter} 12 1/2 x 13 1/2 x 14 FT. DEPTH BELOW INLET 6 FT.

ABSORBENT AREA 312 SQ. FT.

REMARKS _____

11/2/69 Crack in dry well leak of an inches more.
Leak must be pushed closed or corrected.

11/14/69 - Cracked sealed with cement.

DATE SYSTEM APPROVED 11/14/69

INSPECTOR R. L. Lora