

C 1 - 2781

REQUIRED FOR
OWNER USE ONLY

STATE OF MARYLAND
DEPARTMENT OF WATER RESOURCES
STATE OFFICE 200 WEST BALTIMORE STREET
WELL COMPLETION REPORT

THIS REPORT MUST BE SUBMITTED
WITHIN 30 DAYS AFTER COMPLETION
OF THE WELL.
THIS FORM COMPLETELY

DATE RECEIVED
10/16/69
A 14616

DEPTH OF WELL
DATE WELL COMPLETED 4-19-69
120
28 (TO NEAREST FOOT) 28

PERMIT NO. FROM PERMIT TO DRILL WELL
MD-70-0087
20 25 30 35 40 45 50 55

DRILLER'S IDENTIFICATION NO. 43

OWNER
LAST NAME
STREET OR RFD

DRILLER'S NAME
POST OFFICE

WELL LOG

STATE THE KIND OF FORMATIONS PENETRATED, THEIR
COLOR, DEPTH, THICKNESS AND IF WATER BEARING

DESCRIPTION (USE ADDITIONAL SHEETS IF NECESSARY)	FEET		CHECK WEARING
	FROM	TO	
soil	0	3	
clay	3	20	
fine sand	20	60	
blue shale	60	120	

grout
2 bag cement
5 1/2" case
2" steel
Grout only - manual

WELL DESCRIPTION

SPROUTING RECORD
WELL HAS BEEN GROUTED
(CIRCLE APPROPRIATE BOX)
YES NO

DEPTH OF GROUT SEAL (TO NEAREST FOOT)
FROM 0 FT. TO 20 FT.
ENTER 0 IF FROM SURFACE

CASING RECORD
CIRCULE APPROPRIATE CODE BELOW
STEEL CONCRETE
PLASTIC OTHER

MAIN CASING TYPE
NOMINAL DIAMETER TOP (WITH CASING WEARST INCH)
TOTAL DEPTH OF MAIN CASING (NEAREST FOOT)
S T 6 21

OTHER CASING (IF USED)
DIAMETER (INCH) DEPTH (FEET) FROM TO

SCREEN RECORD
SCREEN TYPE (CIRCLE APPROPRIATE CODE BELOW)
STEEL BRASS OR BRONZE OPEN HOLE
PLASTIC OTHER

C 2

EACH	DEPTH (NEAREST WHOLE FOOT)	
	FROM	TO
1	18	21
2	24	30
3	32	41
4	46	51
5	56	60

PUMPING TEST

HOURS PUMPED (TO NEAREST HOUR) 1
PUMPING RATE
GALLONS PER MINUTE TO NEAREST GALLON 1

METHOD USED TO MEASURE PUMPING RATE
WATER LEVEL (DISTANCE FROM LAND SURFACE)
BEFORE PUMPING 40 (NEAREST FOOT)
WHEN PUMPING 150 (NEAREST FOOT)

TYPE OF PUMPED USED (CIRCLE APPROPRIATE BOX)
A AIR 27 P PISTON 27 T TURBINE 27
C CENTRIFUGAL 27 R ROTARY 27 O OTHER (DESCRIBE BY UNIT) 27
J JET 27 S SUBMERSIBLE 27

PUMP INSTALLED

TYPE OF PUMP (WRITE APPROPRIATE LETTER IN BOX - SEE ABOVE: A, C, J, P, R, S, T, O)
CAPACITY
GALLONS PER MINUTE (TO NEAREST GALLON) 30
PUMP HORSE POWER 37
PUMP COLUMN LENGTH (NEAREST FOOT) 48

CASING HEIGHT (CIRCLE APPROPRIATE BOX AND ENTER CASING HEIGHT)
+ ABOVE LAND SURFACE
- BELOW LAND SURFACE


LOCATION OF WELL ON LOT
SHOW PERMANENT STRUCTURE SUCH AS BUILDINGS, SEPTIC TANKS, AND/OR OTHER LAND MARKS AND INDICATE NOT LESS THAN TWO DISTANCES (MEASUREMENTS TO WELLS)

110:12

CIRCLE APPROPRIATE BOXES
A A WELL WAS ABANDONED AND SEALED WHEN THIS WELL WAS COMPLETED
E ELECTRIC LOG OBTAINED
C COPY OF ELECTRIC LOG ATTACHED

I HEREBY CERTIFY THAT I HAVE COMPLETED WITH ALL CONDITIONS STATED ON THE ABOVE-CAPTIONED "PERMIT TO DRILL WELL", AND THAT INFORMATION CONTAINED IN THIS REPORT IS TRUE, ACCURATE, AND COMPLETE TO THE BEST OF MY KNOWLEDGE, INFORMATION AND BELIEF.

SLAY SIZE 1, 2, 3, 4
IF WELL DRILLED WAS A FLOWING WELL CIRCLE BOX 55 P

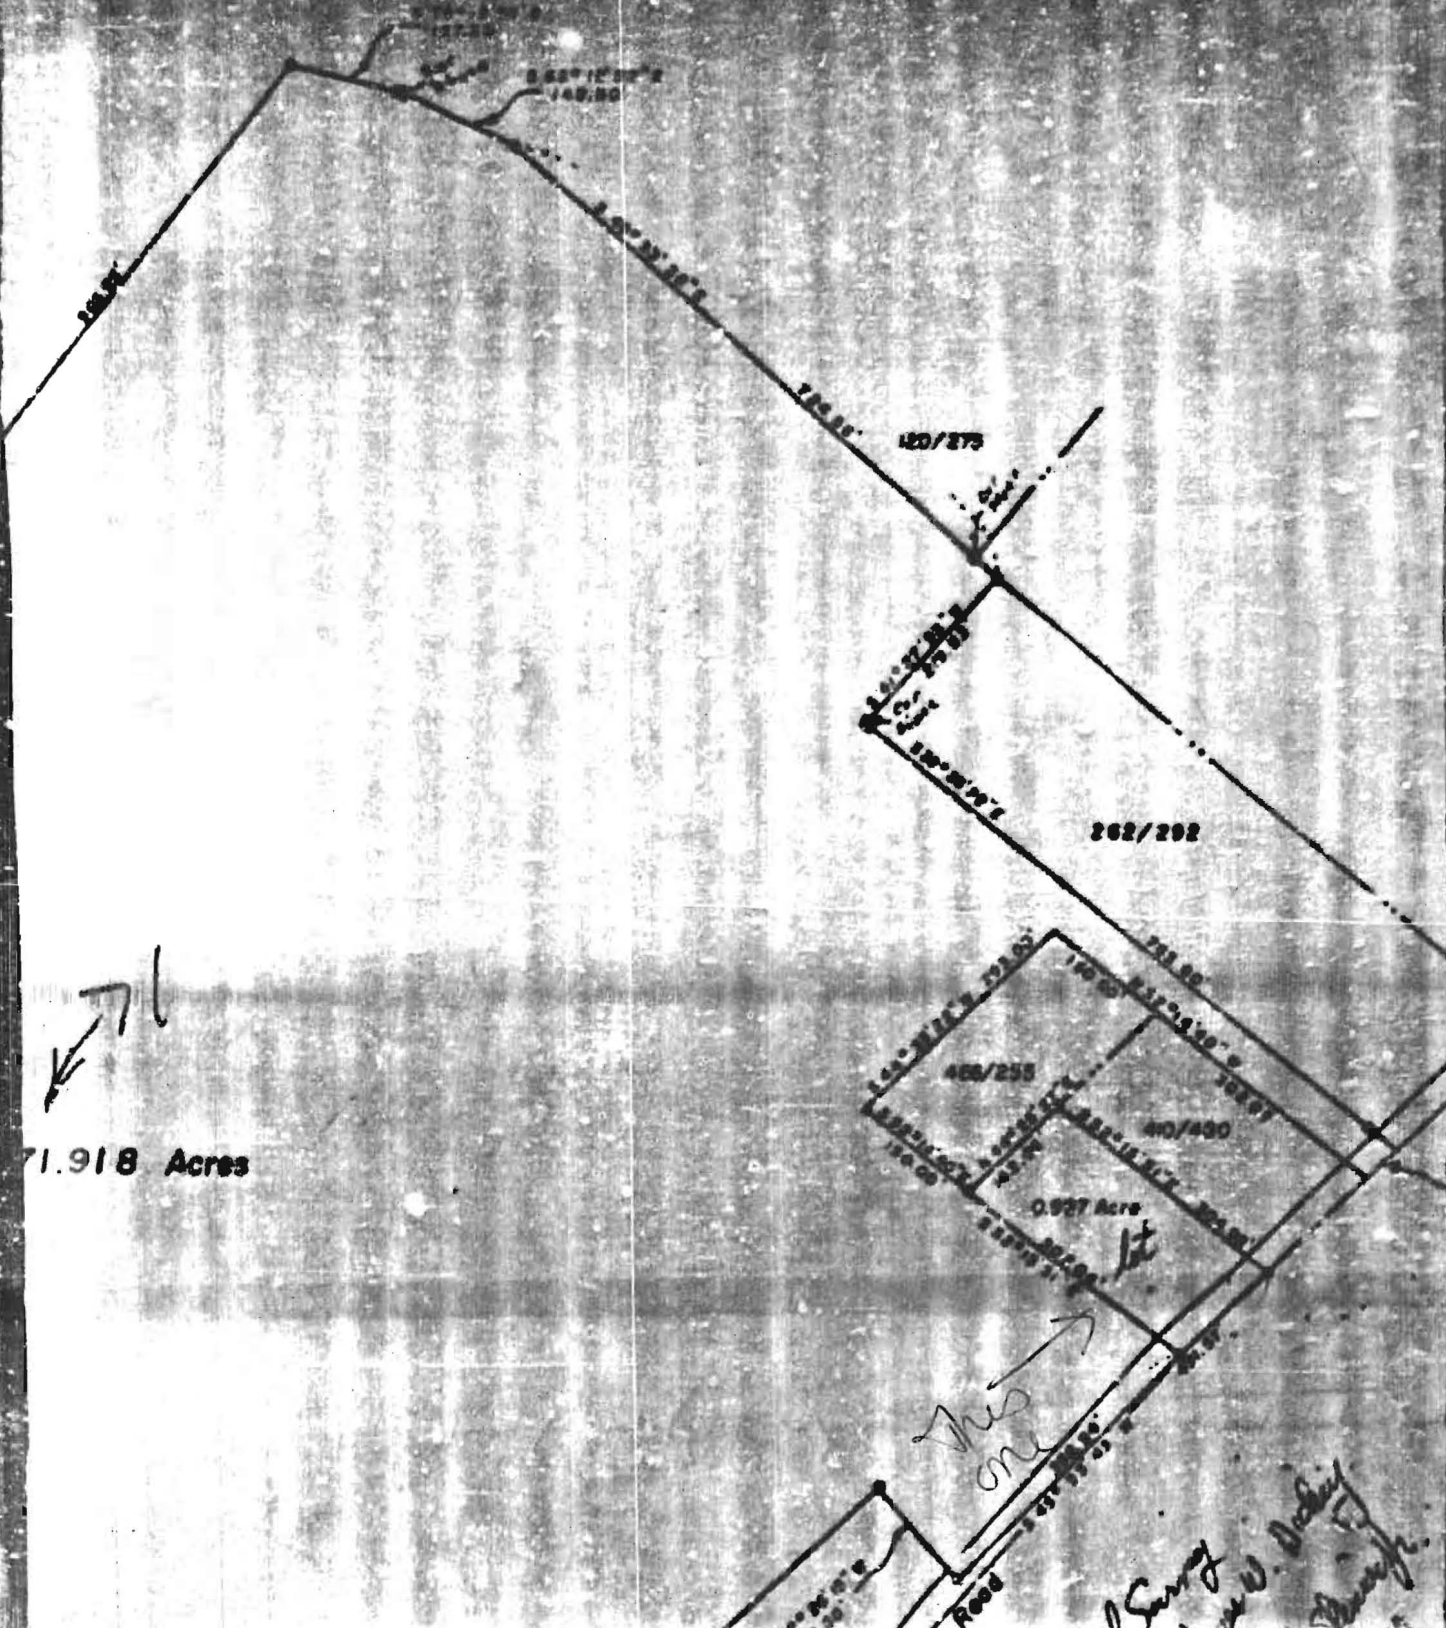

S 55° 12' 30" E
148.80'

120/275

262/202

408/255

40/400

0.927 Acres

This one

Survey
Law W. Dickey
through

71.918 Acres

Road