

PUB. SEWER STATUS VERIFIED BY _____

ISSUE DATE: _____

APPROVAL DATE: _____

PERMIT INDEXED

P 519596-C

A INDEX

ON-SITE SEWAGE DISPOSAL SYSTEM HOWARD COUNTY HEALTH DEPARTMENT BUREAU OF ENVIRONMENTAL HEALTH

04-321812

IS PERMITTED TO INSTALL ALTER

ADDRESS: _____ PHONE NUMBER: _____

SUBDIVISION: _____ LOT NUMBER: _____

ADDRESS: 3560 WOODBINE ROAD PROPERTY OWNER: WILLIAM PHEBUS

SEPTIC TANK CAPACITY (GALLONS): _____

PUMP CHAMBER CAPACITY (GALLONS): _____

NUMBER OF BEDROOMS: _____

SQUARE FEET PER BEDROOM: _____

LINEAR FEET OF TRENCH REQUIRED: _____













TRENCHES:	Trench to be _____ feet wide. Inlet _____ feet below original grade. Bottom maximum depth _____ feet below original grade. Effective area begins at _____ feet below original grade. _____ feet of stone below distribution pipe.
LOCATION:	
PURPOSE:	NO INDEX FILE FOUND-SITE INSPECTION DONE TO SUPPORT BUILDING PERMIT FOR PROPANE TANK


PLANS APPROVED: _____ DATE: _____

- NOTE: PERMIT VOID AFTER 2 YEARS
- NOTE: CONTRACTOR RESPONSIBLE FOR SCHEDULING A PRE-CONSTRUCTION INSPECTION FOR ALL INSTALLATIONS
- NOTE: WATERTIGHT SEPTIC TANKS REQUIRED
- NOTE: ALL PARTS OF SEPTIC SYSTEM SHALL BE 100 FEET FROM ANY WATER WELL
- NOTE: MANHOLE RISERS REQUIRED ON ALL SEPTIC TANKS AND PUMP CHAMBERS

**NEITHER THE HOWARD COUNTY COUNCIL NOR THE HEALTH DEPARTMENT IS
RESPONSIBLE FOR THE SUCCESSFUL OPERATION OF ANY SYSTEM
PERMITTEE RESPONSIBLE FOR OBTAINING FINAL APPROVAL ON THIS PERMIT
CALL 410-313-2640 FOR INSPECTION OF SEPTIC SYSTEM**

519596-C

- Help Me 
- Map Reset 
- Zoom Fit 
- Find Location 
- Remove Pin 
- Layer Control 
- Image Control 
- Theme Map 
- Local Print 
- Print Layout 
- Email Map 
- Map Exit 

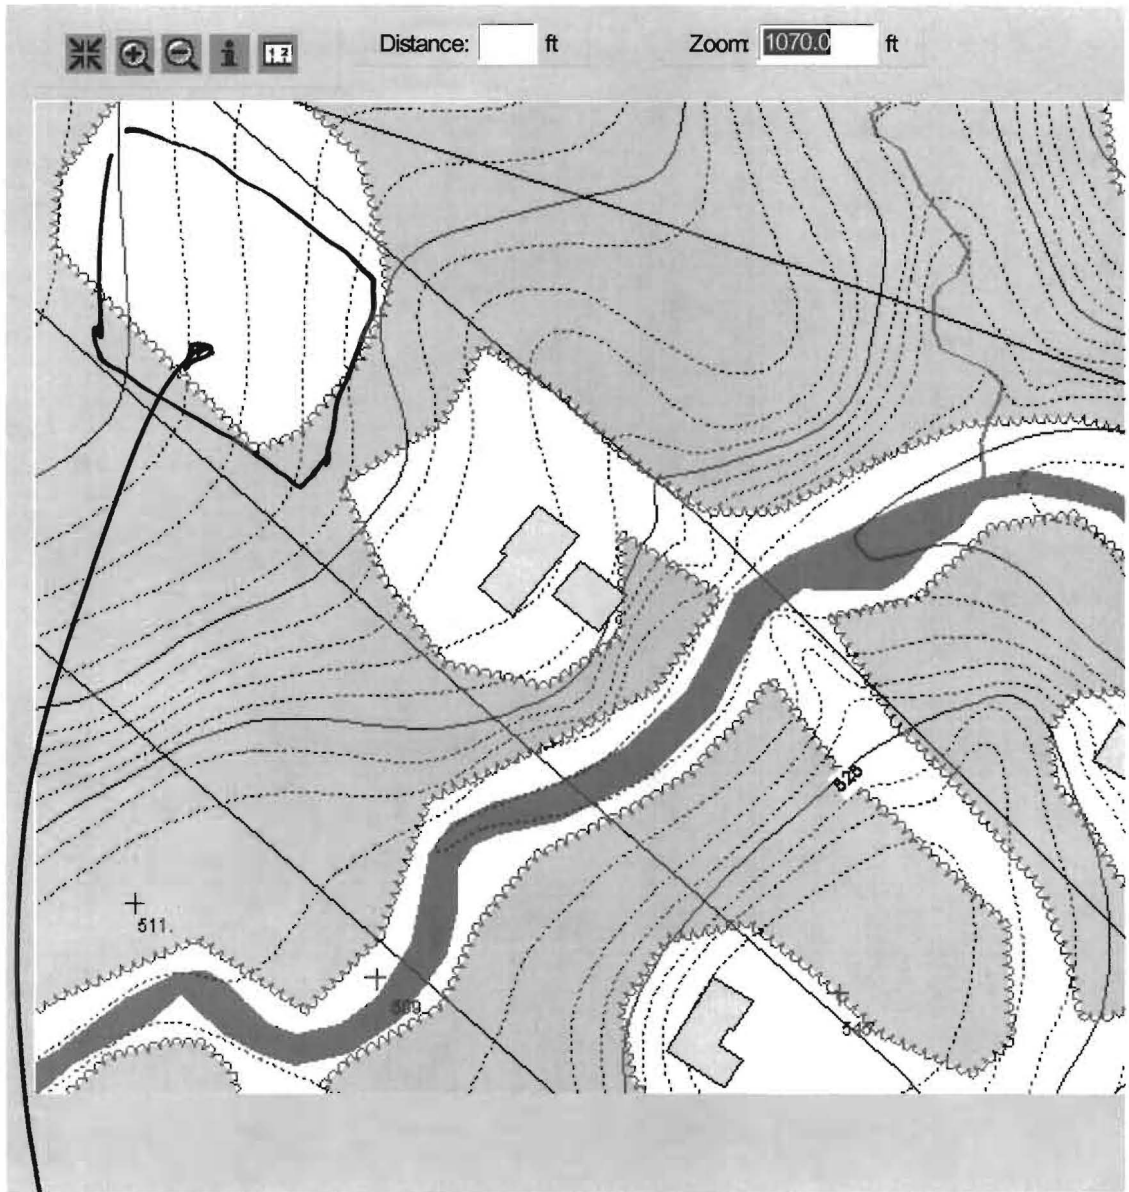

Disclaimer: Howard County, Maryland assumes no responsibility for the accuracy of this map or the information derived therefrom. The buyer and/or user assumes all risks and liabilities whatsoever resulting from or arising There are no oral agreements or warranties relating to this sale and/or use of this map.

Tuesday, January 06 2004 | 8:23:38 AM | @599

Contacts: John Bussiere (x3044) Virginia Peterman (x3659) Yut Phasukyued (x3093) Robert Slivinsky (x3094)

*3560 Woodbine Rd.
 Future septic easement for upgrade
 & repair. See letter dated on
 this date to current owner,
 Mr. William Phabus.*

*(FR)
 1/6/04*

FOGLE'S SEPTIC CLEAN, INC.

580 Obrecht Road
Sykesville, Maryland 21784
(410) 795-5670

DONOT
THROW
AWAY
(FR)

1/6/04

FOGLE'S SEPTIC EVALUATION

CLIENT Bill Pheebus INSPECTION ADDRESS 410-489-7774
35600 Woodbine Road
CITY Woodbine, MD STATE _____ ZIP _____ PHONE _____

INSPECTION

DAY 1/5 DATE _____ TIME 12:30 PM ORDERED BY Bill Pheebus

WEATHER

GENERAL GROUND CONDITIONS

System Age 34 ? Last Pumped 5/23/02 ? Problems None ? (note below) Repair Date _____ ?
House Age 34 ? Occupied YES ? Number _____ ? House Locked _____ ? (no entry)

- This is a subjective and visual inspection only, based upon many unknown and unseen factors.
- The condition of the Sewage Disposal System is reported as of the above date.
- **This report does not WARRANT nor GUARANTEE** continued functional Sewage Disposal System operations.
- If house has been unoccupied this report may not be accurate. Little or no use of the septic system could have allowed the problems to temporarily clear themselves.
- If a larger family is moving in than is presently occupying the house, the septic system may be subject to failure.
- If the general ground condition is wet, this report may not be accurate, as ground moisture may cover or hide actual septic effluent on the surface.
- In the above cases, it is strongly suggested that the septic system be recertified in 3 to 6 months.
- If system is rated below as marginal or unsatisfactory, it is suggested that the local health department be contacted to inspect and confirm the findings.

PAYMENT FOR THIS INSPECTION SIGNIFIES UNDERSTANDING AND ACCEPTANCE OF ABOVE CLAUSES.

The outside area showed no signs of septic system failure or as noted below:

system is functional.

System Appears: FUNCTIONAL MARGINAL UNSATISFACTORY

\$ N/C 2051 1/5/04
Amount Check No. Date Paid

[Signature]
Inspector Signature

CLIENT %

BILL TO

COMPANY

ADDRESS

CITY

STATE

Small truck

FOGLE'S SEPTIC CLEAN, INC.

580 OBRECHT RD. - SYKESVILLE, MD 21784

(410) 795-5670

Portable Toilets

Backhoe Service • Percolation Tests • Septic Line Cleaning
Pump Septic Tank & Drywells • New Installations • Repair Systems

Drop off
Certificate



065618

Bill To: Bill Pheabus

Date of Order: 1/5
Order Taken By: CMS

Address: 3560 Woodbine Rd

SCHEDULE FOR:
 Morning ASAP
 Afternoon

City: Woodbine

Job Phone:
Home Phone: 410 489

Job Name:
Location: Woodbine
Work Ordered By: Date

7774

Work Order	Actual Work	DESCRIPTION OF WORK
<input checked="" type="checkbox"/>		Pump Septic & Back Flush 120
		Pump Drywell
		Discharge Fee
		Emergency Fee
		Extra Back Flushing
		Extra Hose
		Locating System
		Hand Digging
		Back Hoe
		Hand Snaking
		Electric Snaking
<input checked="" type="checkbox"/>		Septic Certification
		Condition of Driveway:
		We are not responsible for your cleanout cap if we break it when we remove it.
		We are not responsible for any damage to your driveway.

DO NOT
THROW
AWAY

Handwritten signature and date: 1/5/04

FA
1/6/04

No One Home Date Completed: 1-5-04 Done By: [Signature]

Signature: [Signature]

I hereby acknowledge the satisfactory completion of the above described work.

PAY FROM THIS INVOICE NET 30 DAYS
A finance charge 1.5% will be charged monthly on unpaid balance.
And any actual and reasonable collection fees may be added if delinquent. There is a \$25.00 fee for a returned check.
PRICES SUBJECT TO CHANGE