

10/3/68 approved JTB  
**PERMIT**

SEWAGE DISPOSAL SYSTEM

P. 1590  
A. 13902

MARYLAND STATE DEPARTMENT OF HEALTH

HOWARD COUNTY

ELLICOTT CITY

FAX  
301-840-0521

**INDEXED**

DISTRICT A

DATE 6/19/69

Norman Kirk

IS PERMITTED TO INSTALL  ALTER

ADDRESS Annapolis Park Road, Woodbine, Md. PHONE BU 9-4724

A SEWAGE DISPOSAL SYSTEM LOCATED AT \_\_\_\_\_

SUBDIVISION \_\_\_\_\_ ROAD Rt. 94 - E. of LOT 11 B

Lisbon - see application for better direction

PROPERTY OWNER Charles R. Thompson

ADDRESS \_\_\_\_\_

SPECIFICATIONS - 4 bedrooms

DRAIN FIELD \_\_\_\_\_ DEPTH \_\_\_\_\_ FEET, BOTTOM AREA \_\_\_\_\_ SQ. FT.

SEEPAGE PITS \_\_\_\_\_ ABSORBENT SIDE-WALL AREA \_\_\_\_\_ SQ. FT.

SEPTIC TANK CAPACITY 1,000 GALLONS

FOR GARBAGE GRINDER, INCREASE DISPOSAL AREA 25% & TANK CAPACITY 50%

OTHER Dry well to be 552 sq. ft. of absorbent sidewall area below the inlet pipe. Inlet pipe to begin 5 ft. below original grade. Locate dry well 262 ft. from rear lot line and 69 ft. from right side line as seen from facing lot standing on Route 94. Maximum depth of dry well 12 1/2 ft.

NOTE: ALL PIPE FROM HOUSE TO SEPTIC TANK MUST BE CAST IRON.

PERMIT VOID AFTER THREE YEARS.


PLANS APPROVED BY James T. Wright DATE 10/3/68

FILL SEPTIC TANK AND DISTRIBUTION BOX WITH WATER BEFORE CALLING FOR AN INSPECTION. COVER NO WORK UNTIL INSPECTED AND APPROVED.

NEITHER THE HOWARD COUNTY COMMISSIONERS NOR THE HEALTH DEPARTMENT IS RESPONSIBLE FOR THE SUCCESSFUL OPERATION OF ANY SYSTEM.

**NOTIFY THE HEALTH DEPARTMENT 48 HOURS BEFORE EXCAVATIONS ARE TO BE BACK FILLED.**

A 15902

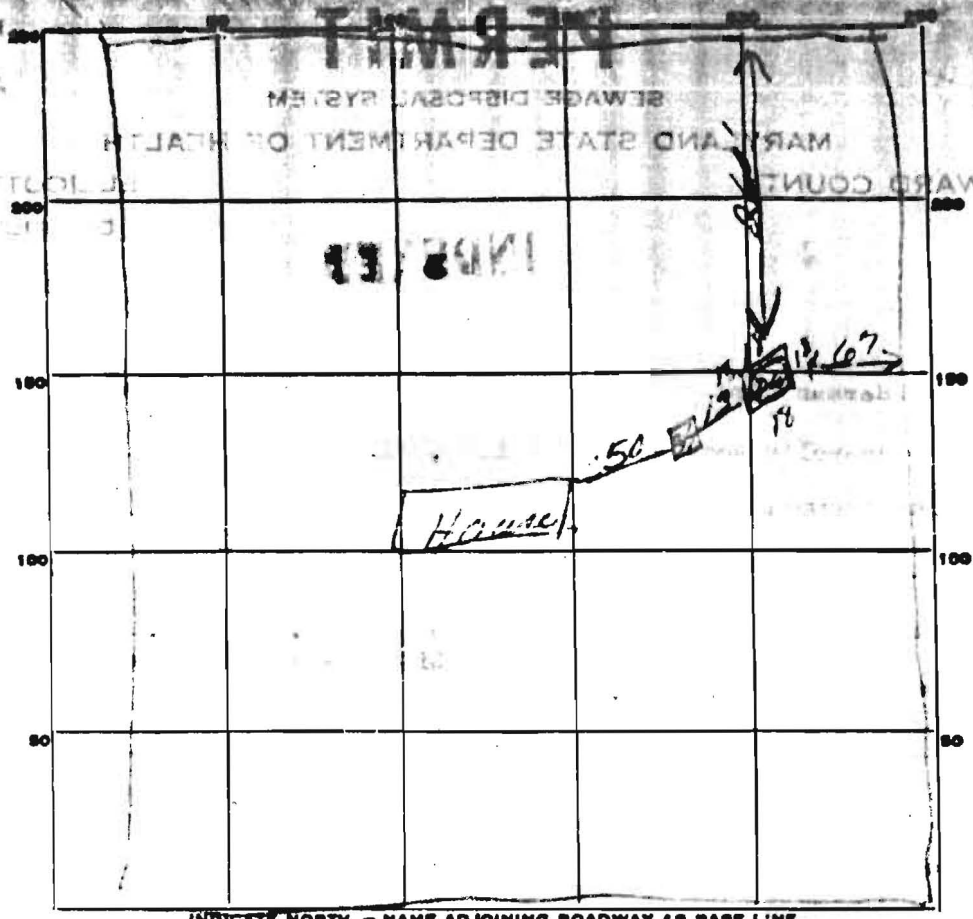

INDICATE NORTH - NAME ADJOINING ROADWAY AS BASE LINE.

PERMIT CARD         

SEPTIC TANK, LEVEL 1000

CLEANOUTS OK

DISTRIBUTION BOX, LEVEL         

TILE FIELD, DEPTH          FT. TRENCH WIDTH          FT.

GRAVEL DEPTH          IN. TOTAL LENGTH          FT.

NUMBER OF TRENCHES          TOTAL BOTTOM AREA         

SEEPAGE PITS, INSIDE DIAMETER 12 FT. DEPTH BELOW INLE 7 1/2 FT.

ABSORBENT AREA 540 SQ. FT.

REMARKS         

DATE SYSTEM APPROVED 10/04/69

INSPECTOR