

6/17/65
as shown
on plan

3d License from the State

PERMIT

SEWAGE DISPOSAL SYSTEM

P. 10219

A. _____

MARYLAND STATE DEPARTMENT OF HEALTH

HOWARD COUNTY

ELLICOTT CITY

DISTRICT 5

DATE 6/24/65

INDEXED

County Sewer Service _____ IS PERMITTED TO INSTALL _____ ALTER _____

ADDRESS: Wheatland, Maryland PHONE MT 4-1000

A SEWAGE DISPOSAL SYSTEM LOCATED AT _____

SUBDIVISION Forest Hills Lot 16 5740 ROAD Traylor Rd. Hall Hill Lot
has been on lot - closer to St. 100

PROPERTY OWNER George Bush

ADDRESS Traylor Rd.

SPECIFICATIONS

DRAIN FIELD _____ DEPTH _____ FEET. BOTTOM AREA _____ SQ. FT.

SEWAGE PITS _____ ABSORBENT SIDEWALL AREA _____ SQ. FT.

SEPTIC TANK CAPACITY _____ GALLONS

FOR GARBAGE GRINDER, INCREASE DISPOSAL AREA 50% & TANK CAPACITY 50%.


OTHER SEWER - 9 x 12" Any wall.

PLANS APPROVED BY _____ DATE 6/24/65

FILL SEPTIC TANK AND DISTRIBUTION BOX WITH WATER BEFORE CALLING FOR AN INSPECTION. COVER NO WORK UNTIL INSPECTED AND APPROVED.

NEITHER THE HOWARD COUNTY COMMISSIONERS NOR THE HEALTH DEPARTMENT IS RESPONSIBLE FOR THE SUCCESSFUL OPERATION OF ANY SYSTEM.

6/24/65

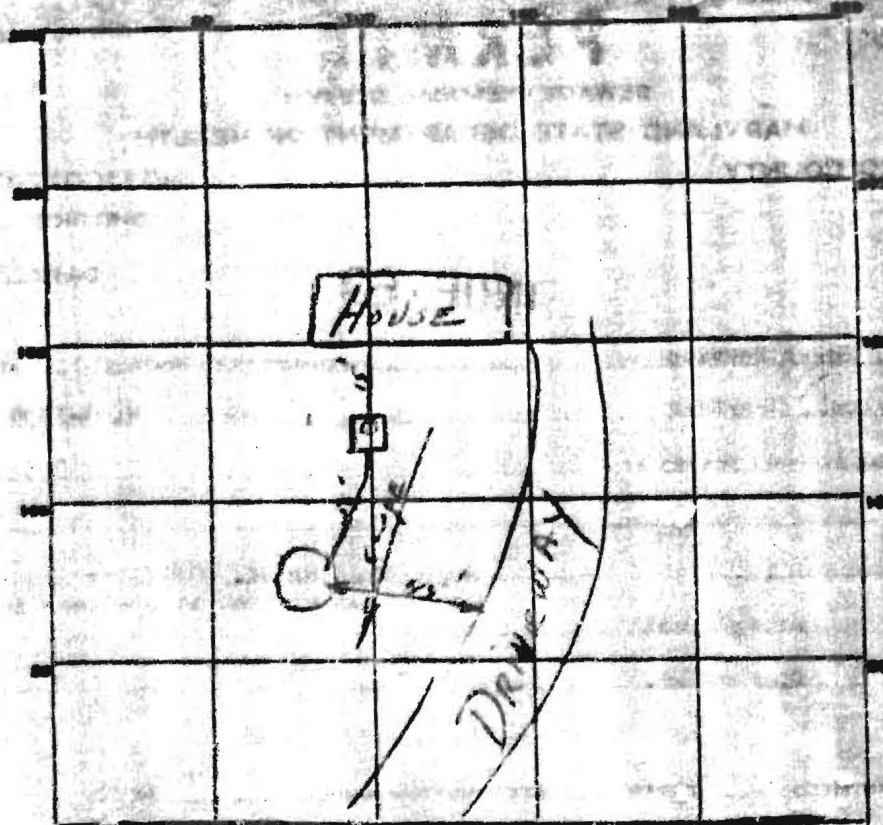

INDICATE NORTH -- MARK ABSORBING ROADWAY AS BASE ONE

Trotter Road

PERMIT CASE 4/23

SEPTIC TANK, LEVEL _____

CLEANOUTS 8" Sand pipe

DISTRIBUTION BOX, LEVEL _____

TILE FIELD, DEPTH _____ FT. TRENCH WIDTH _____ FT.

GRAVEL DEPTH _____ IN. TOTAL LENGTH _____ FT.

NUMBER OF TRENCHES _____ TOTAL BOTTOM AREA _____

SEEPAGE PITS, INSIDE DIAMETER 12 FT. DEPTH BELOW INLET 11/8 in

ABSORBENT AREA OK SQ. FT.

REMARKS Added dry well only. JH

DATE SYSTEM APPROVED 6-17-65

INSPECTOR J. Heavens