

APPLICATION

SEWAGE DISPOSAL TESTING

MARYLAND STATE DEPARTMENT OF HEALTH

HOWARD COUNTY

ELLICOTT CITY

DISTRICT 1

DATE 11/30/71

TO: THE COUNTY HEALTH OFFICER
ELLICOTT CITY, MARYLAND

I, HEREBY, APPLY FOR THE NECESSARY TESTS IN ORDER TO CONSTRUCT (OR RECONSTRUCT) A SEWAGE DISPOSAL SYSTEM.

PROPERTY OWNER Mark Wakefield, Jr.
12150 Mt. Albert Court
ADDRESS Ellicott City, Md.

PHONE 531-5072

PROPERTY LOCATION:

SUBDIVISION Woodmark, Inc.

LOT NO. 39, Block 2, Sec. 9

ROAD AND DESCRIPTION Carroll Mill Road

OCCUPANT _____ PHONE _____

PERSON TO CONSTRUCT SYSTEM _____

ADDRESS _____ PHONE _____

SIZE OF LOT 140'x245'x95'x65'x150'x220' TYPE BLDG. 3 OF 4

IF NOT SINGLE RESIDENCE DESCRIBE _____

SIGNATURE OF APPLICANT Mark Wakefield, Jr.


APPROVED BY _____ FOR _____ DATE _____

REJECTED BY _____ FOR _____ DATE _____

HOLD PENDING FURTHER TESTS _____ DATE _____

REASONS FOR REJECTION OR HOLDING _____

THIS IS NOT A PERMIT

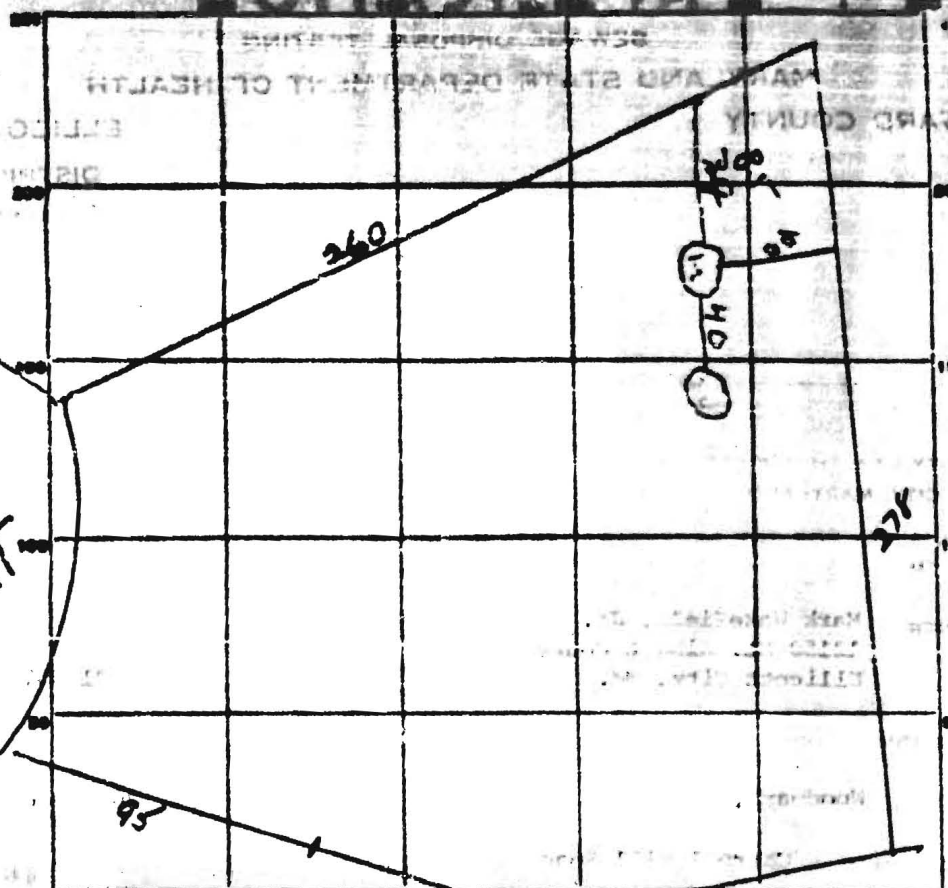

INDICATE NORTH. - NAME ADDRESS ROAD NO. PAGE LISTED

[illegible]

39 E

SOIL AUGER FINDING.

TESTED BY


34

THIS IS THE

16542

SCALE: 1"=50'

LOT NO. 39
BLOCK "E"
SECTION NO. 9
WOODMARK
23/77

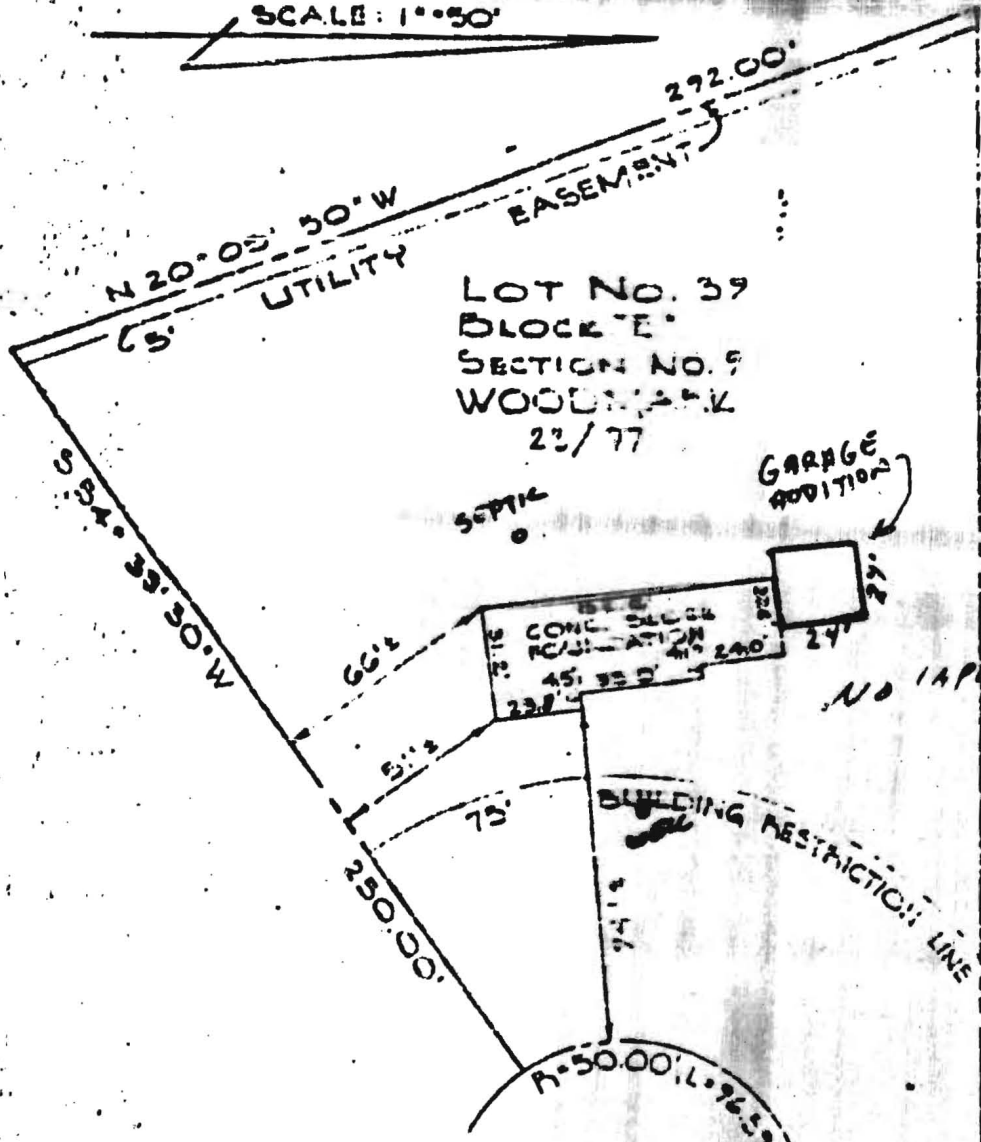

FEARLING CO.

203.10' to R.C.
EIGHTHSON