

PERMIT

SEWAGE DISPOSAL SYSTEM

MARYLAND STATE DEPARTMENT OF HEALTH

P 43591
28110
A REPAIR

DISTRICT 3rd

DATE 2/6/89

DATE SYSTEM APPROVED 12-9-88

INSPECTOR JEN

HOWARD COUNTY
BUREAU OF ENVIRONMENTAL HEALTH
461-9933

INDEXED

Jack Fyock

IS PERMITTED TO INSTALL _____ ALTER X

ADDRESS _____ PHONE 988-9270

SUBDIVISION Farside ROAD 11694 Farside Road LOT 15

PROPERTY OWNER Dr. and Mrs. Joe Manspeaker / Mrs LAKHAPAL

ADDRESS _____

IF GARBAGE GRINDER IS USED INCREASE SEPTIC TANK CAPACITY BY 50% AND ABSORPTION AREA BY 22%.

GARBAGE GRINDER? YES _____ NO _____
Total SEPTIC TANK CAPACITY 2000 GALLONS Total NUMBER OF BEDROOMS 4

150
4
51600
120 ft trench

REPAIR - CALL FOR INSPECTION WHEN GROUND IS OPENED UP SO SANITARIAN CAN RECOMMEND REPAIR.

Add a 1000 gallon tank for additional 1 bedroom. Inlet = 4.0ft, Bottom = 9.0ft. 150 sq ft / bdrm. 5.0 ft of stone JEN 12-9-88

BLDG. PERMIT

AND RETURNED 6-16-98

Serial # B7012919
General Addition
Remodel Kitchen + Family Room

PLANS APPROVED BY C. Williams DATE 12/09/88

COVER NO WORK UNTIL INSPECTED AND APPROVED

NEITHER THE HOWARD COUNTY COUNCIL NOR THE HEALTH DEPARTMENT IS RESPONSIBLE FOR THE SUCCESSFUL OPERATION OF ANY SYSTEM

NOTE: CLEANOUT REQUIRED EVERY 70 FEET OF SEWER LINE AND/OR AT 90° SWEEPS IN LINES FROM HOUSE TO DRAIN FIELDS

NOTE: ALL PARTS OF SEPTIC SYSTEMS (I.E. TANK, DISTRIBUTION BOX, TRENCHES) TO BE 100 FEET FROM WELL (UNLESS OTHERWISE SPECIFICALLY AUTHORIZED)

NOTE: IF DEEP TRENCH(IES) ARE USED CALL FOR INSPECTION BEFORE AND AFTER PLACING GRAVEL IN TRENCH(IES)

NOTE: NO DRY WELL SHALL EXCEED 15 FOOT IN DIAMETER NO ABSORPTION TRENCH TO EXCEED 100 FEET IN LENGTH.

NOTE: ALL PIPE FROM HOUSE TO SEPTIC TANK MUST BE CAST IRON OR SCHEDULE 40 PVC OR ABS

PERMIT VOID AFTER TWO YEARS

NOTE: INSTALL STAND PIPE ON SEPTIC TANK AND DRY WELL STAND PIPES MUST BE 6 INCHES IN DIAMETER CAST IRON, CONCRETE OR TERRA COTTA OR PVC OR ABS ACCEPTED. IF TOP OF SEPTIC TANK IS DEEPER THAN 3 FEET, MANHOLE TO GRADE REQUIRED

NOTE: DISTRIBUTION BOXES MUST HAVE BAFFLES

BLDG. PERMIT SIGNED

AND RETURNED 1/23/95


Serial # 57925
1 story addition

***INSTALLER IS RESPONSIBLE FOR OBTAINING FINAL APPROVAL ON THIS PERMIT**

*CALL 461-9933 FOR INSPECTION OF SEPTIC SYSTEMS.

P 43591
43591

Vixens Path

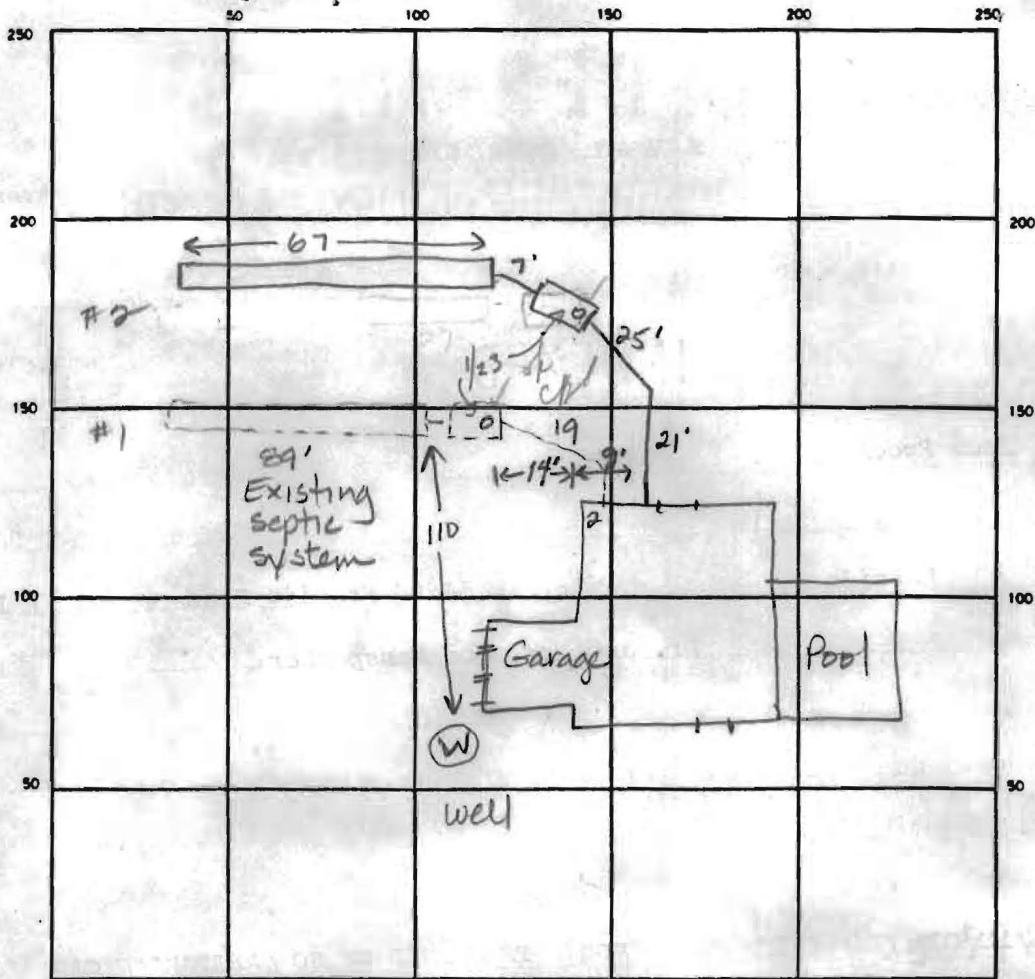

INDICATE NORTH - NAME ADJOINING ROADWAY AS BASE LINE

Farview Road

SEPTIC TANK LEVEL 1000 gal.

CLEANOUTS 1 on septic tank

DISTRIBUTION BOX LEVEL N/A

DRAIN FIELD TILE FIELD DEPTH 9 FT TRENCH WIDTH 2 FT INLET DEPTH 3 FT

EFFECTIVE GRAVEL DEPTH 6 FT TOTAL LENGTH 67 FT

NUMBER OF TRENCHES 1 ONE SIDEWALL/BOTTOM AREA 402 SQ FT

DRYWELL INSIDE DIAMETER _____ FT EFFECTIVE DEPTH BELOW INLET _____ FT

ABSORBENT AREA 402 SQ FT.

REMARKS 12-9-88 OK to add stone to 60 ft of trench. Lay pipe & paper leaving trench open for inspection. JEN 12-9-88 OK to cover all work, JEN

DATE SYSTEM APPROVED 12-9-88

INSPECTOR Jane E. Nadeau